#14581

PARCEL SIZE CORRECTION

APPROVED
LORAIN CO.
MAP DEPT.

DATE 3-11-82

PAGE 1-00-003-B

BY T. McNair

VOID AFTER
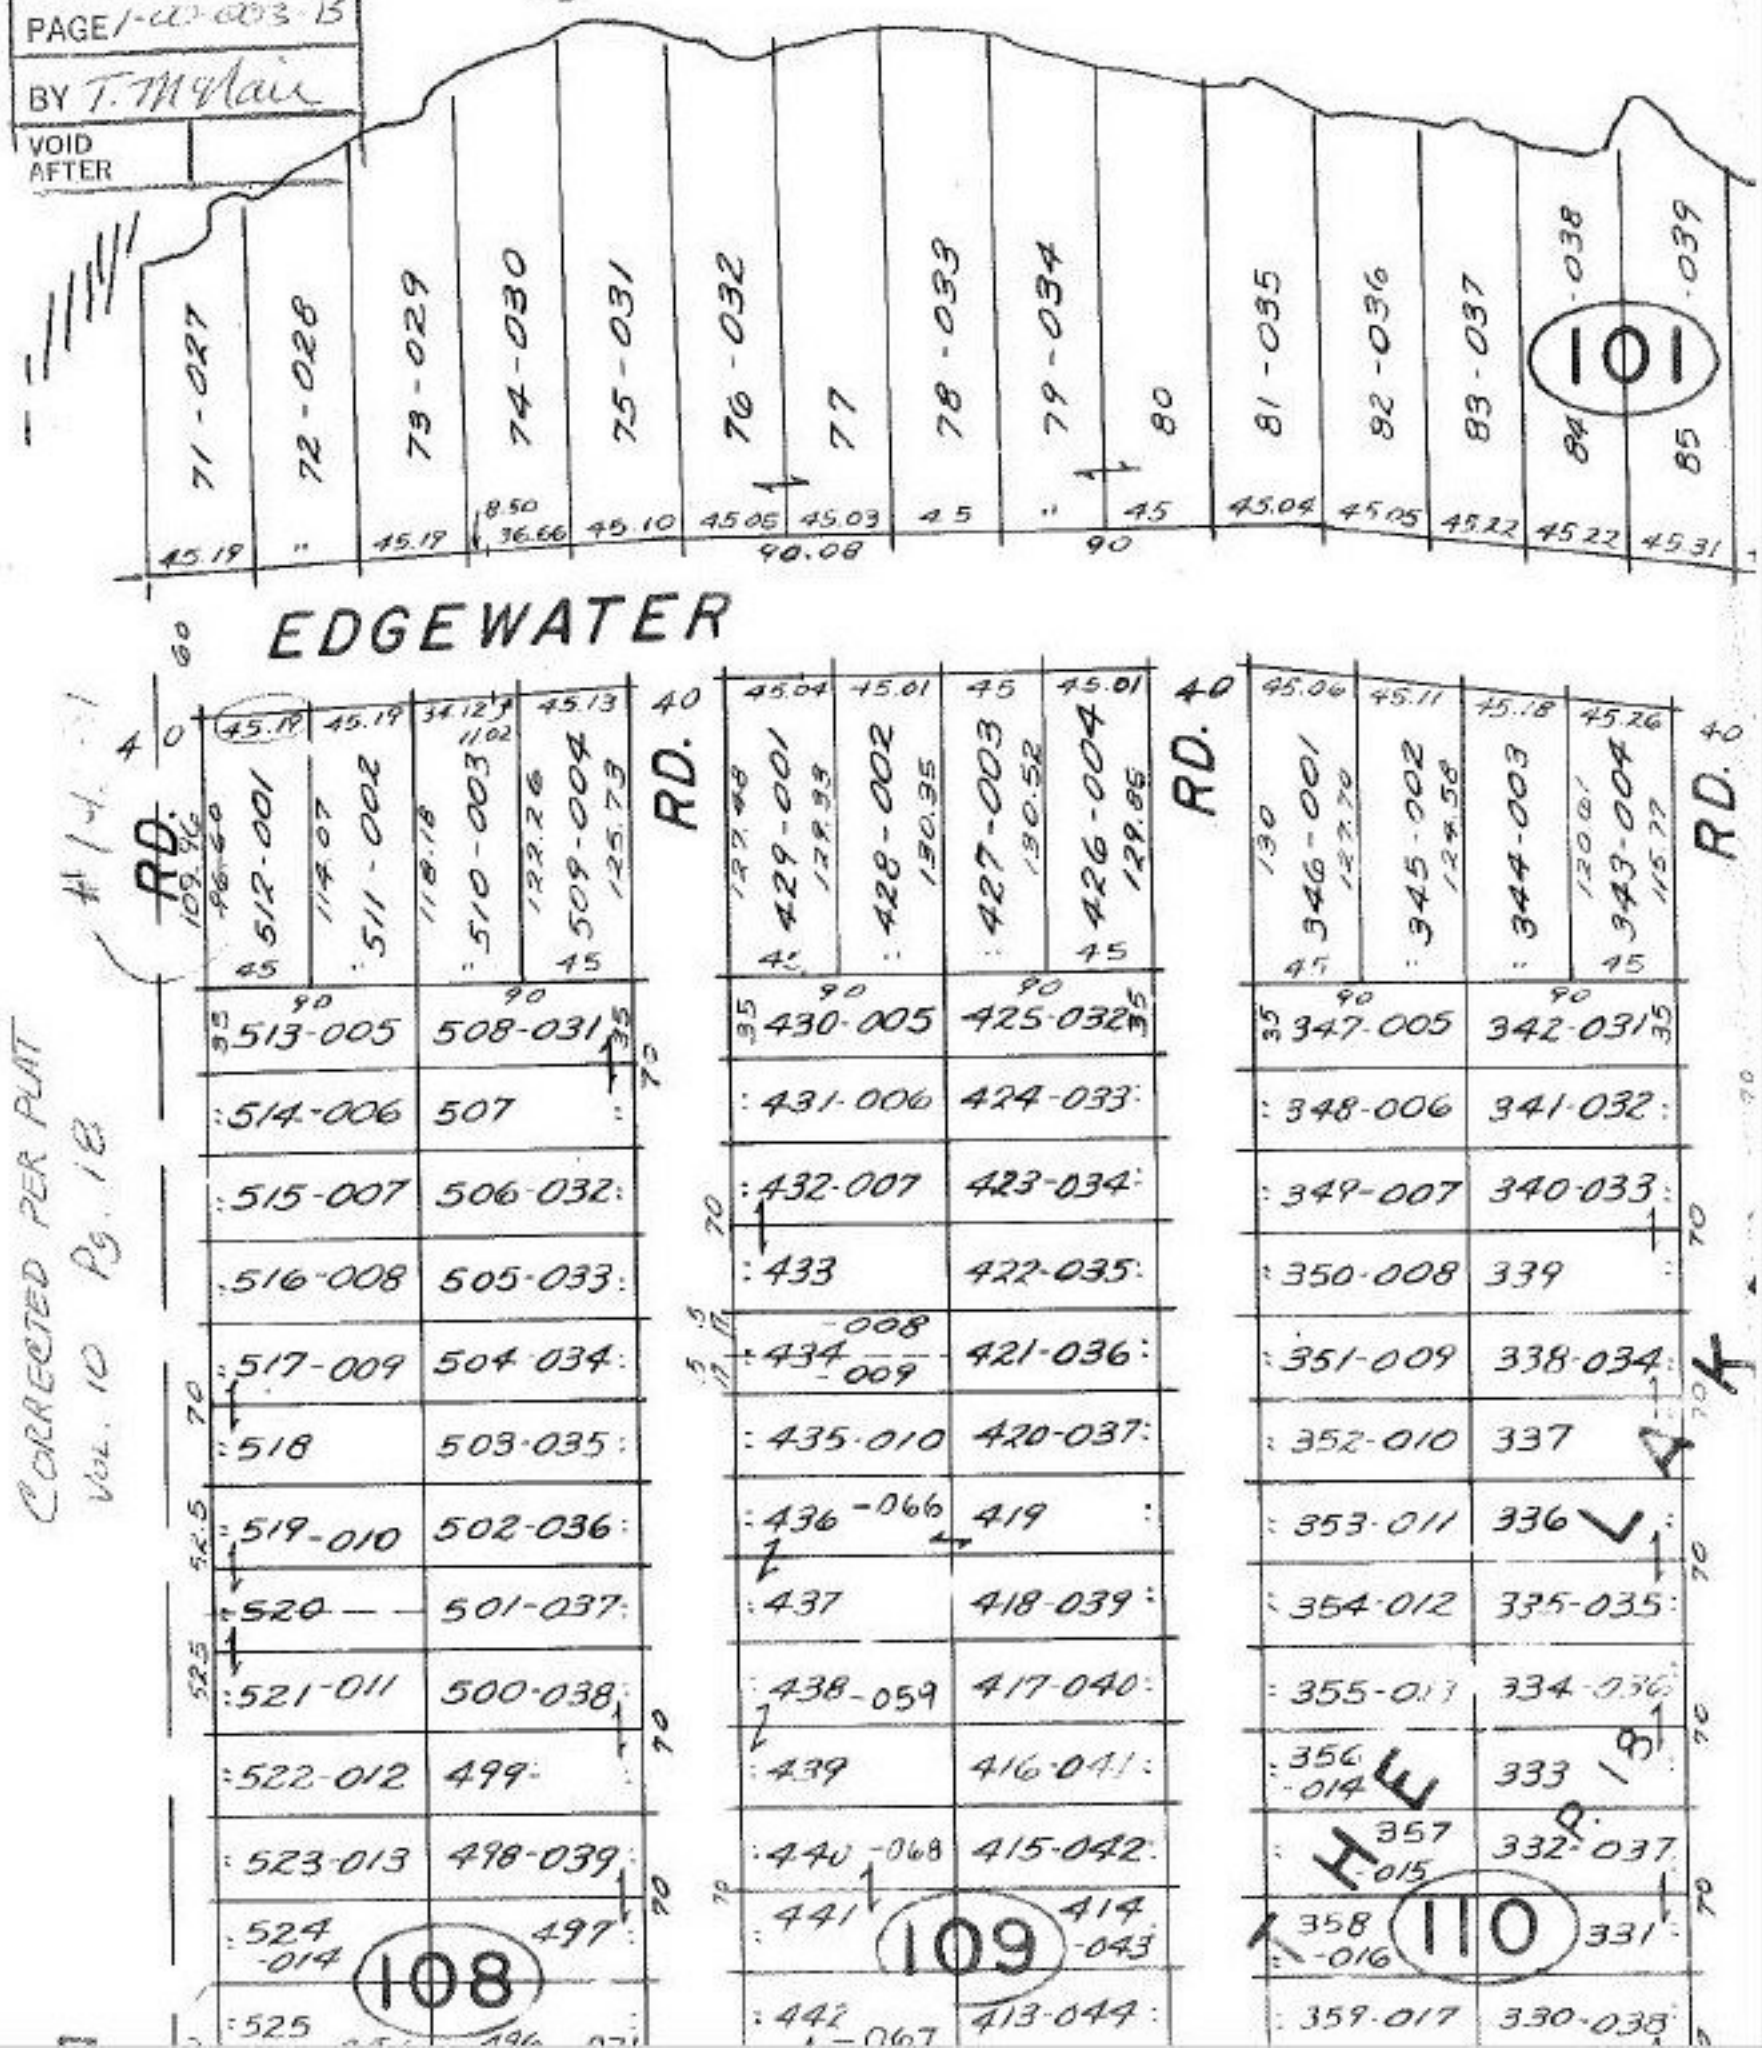
DEC 23 1982