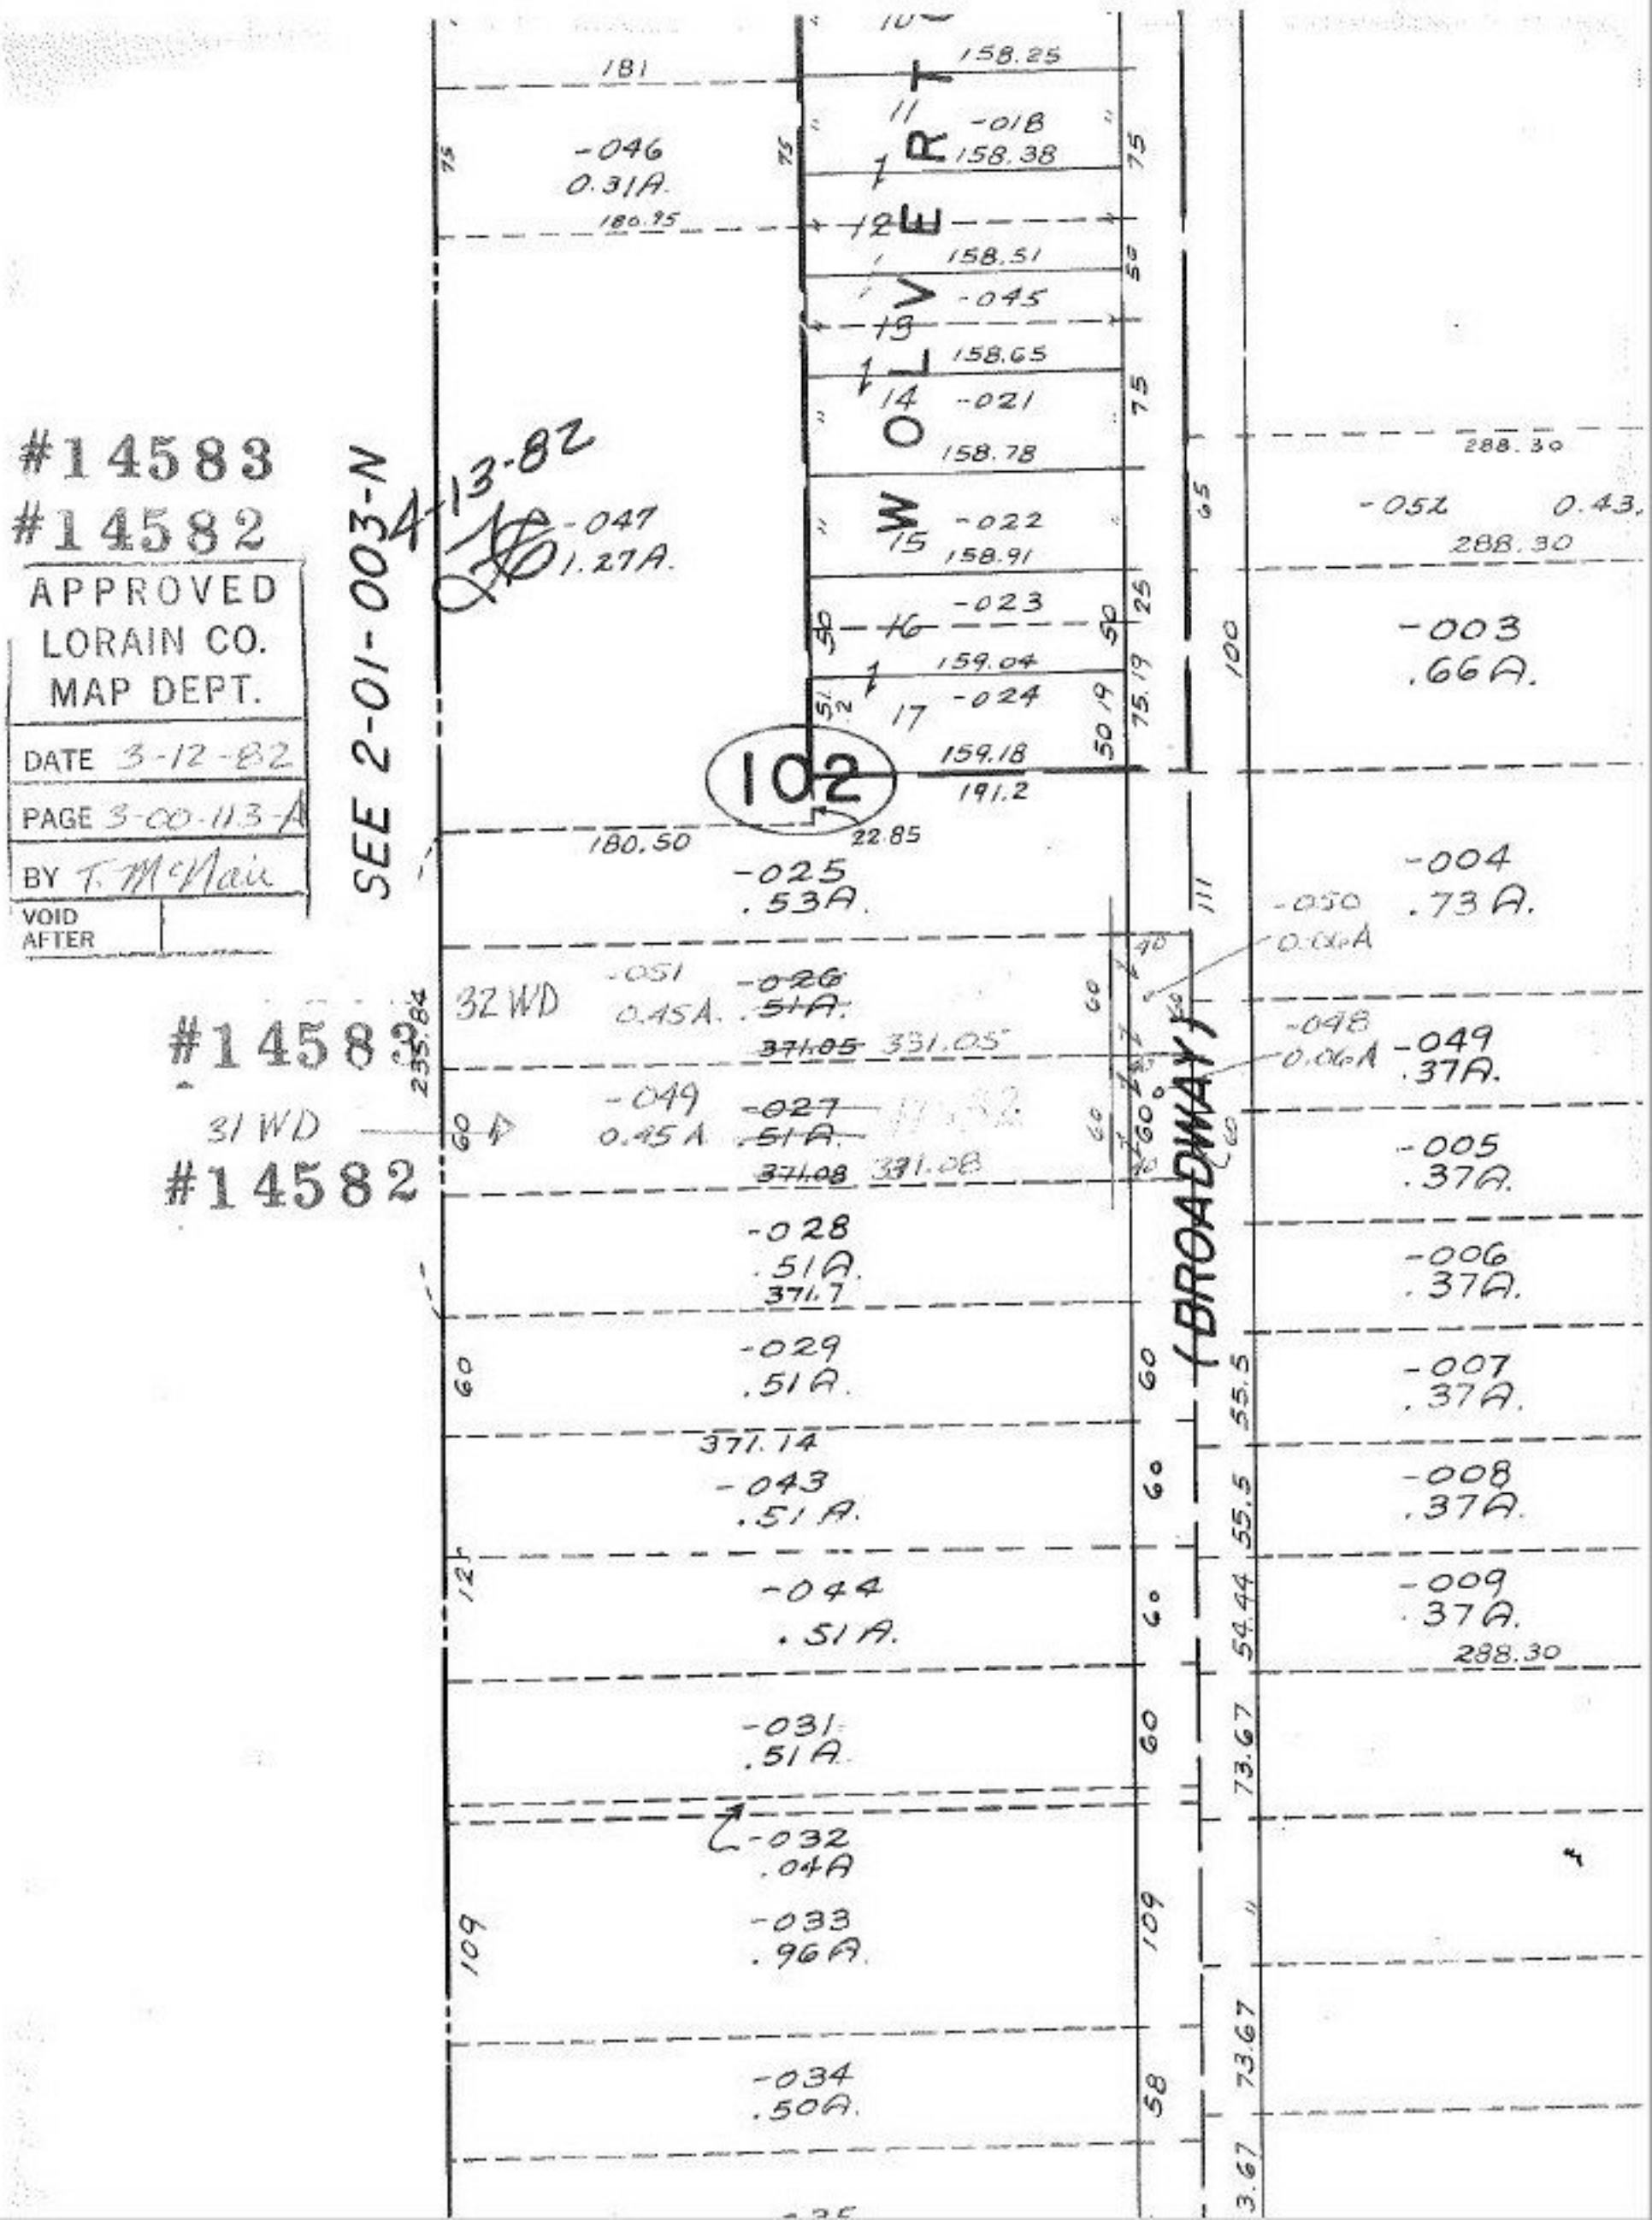

#14583
#14582
APPROVED
LORAIN CO.
MAP DEPT.
DATE 3-12-82
PAGE 3-00-113-A
BY T. McNair
VOID AFTER
SEE 2-01-003-N
4-13-82
WOLVERT
(BROADWAY)
102
#14583
#14582
32 WD
31 WD
-046 0.31A.
-047 1.27A.
-018 158.38
-045
-021
-022
-023
-024
-025 .53A.
-026 .51A.
-027 .51A.
-028 .51A.
-029 .51A.
-043 .51A.
-044 .51A.
-031 .51A.
-032 .04A
-033 .96A.
-034 .50A.
-051 0.45A.
-049 0.45A
-050 0.06A
-048 0.06A
-052 0.43.
-003 .66A.
-004 .73A.
-049 .37A.
-005 .37A.
-006 .37A.
-007 .37A.
-008 .37A.
-009 .37A.