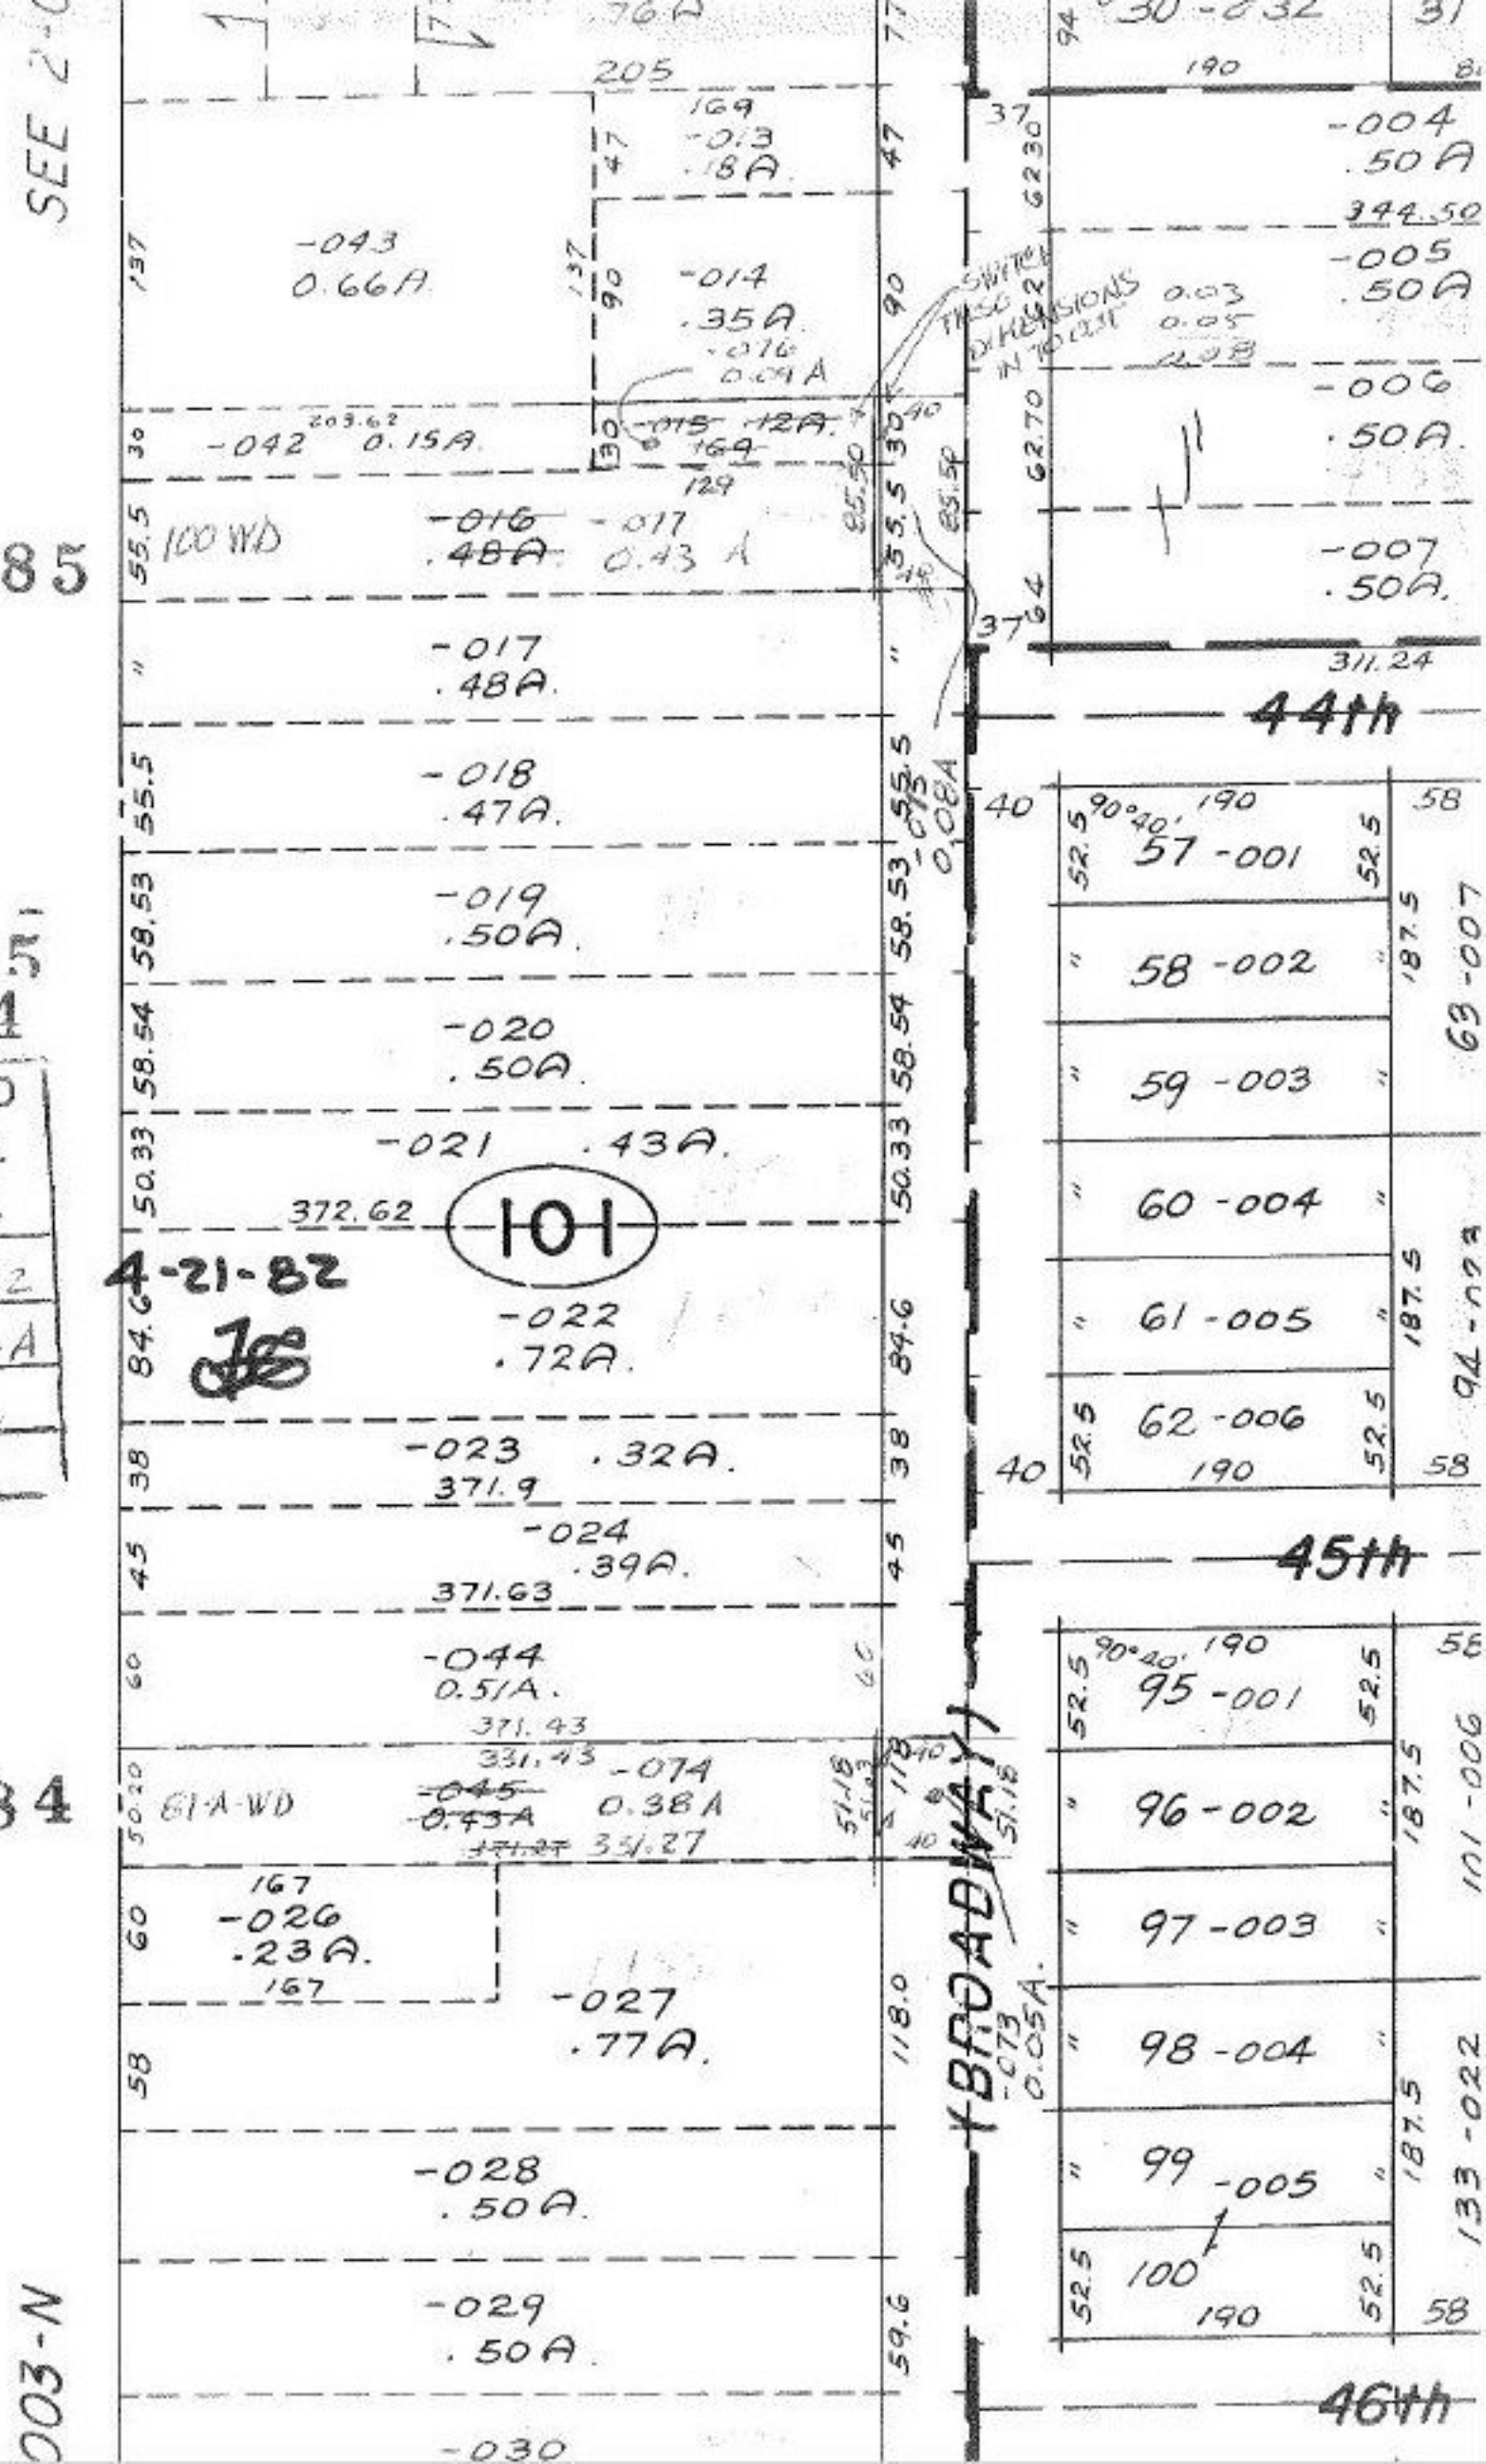

SEE 2-0
#14585
#14585
#14584
APPROVED
LORAIN CO.
MAP DEPT.
DATE 3-12-82
PAGE 3-00-108-A
BY T. McNair
VOID
AFTER
#14584
003-N
4-21-82
101
100 WD
61-A-WD
-043
0.66A
-042
0.15A
-016
.48A
-017
0.43 A
-017
.48A
-018
.47A
-019
.50A
-020
.50A
-021
.43A
372.62
-022
.72A
-023
.32A
371.9
-024
.39A
371.63
-044
0.51A
371.43
331.43
-045
0.43A
-074
0.38A
331.27
-026
.23A
-027
.77A
-028
.50A
-029
.50A
-030
-014
.35A
-013
.18A
-016
0.09A
-015
.12A
-004
.50A
-005
.50A
-006
.50A
-007
.50A
311.24
44th
45th
46th
BROADWAY
57-001
58-002
59-003
60-004
61-005
62-006
95-001
96-002
97-003
98-004
99-005
100
63-007
94-023
101-006
133-022