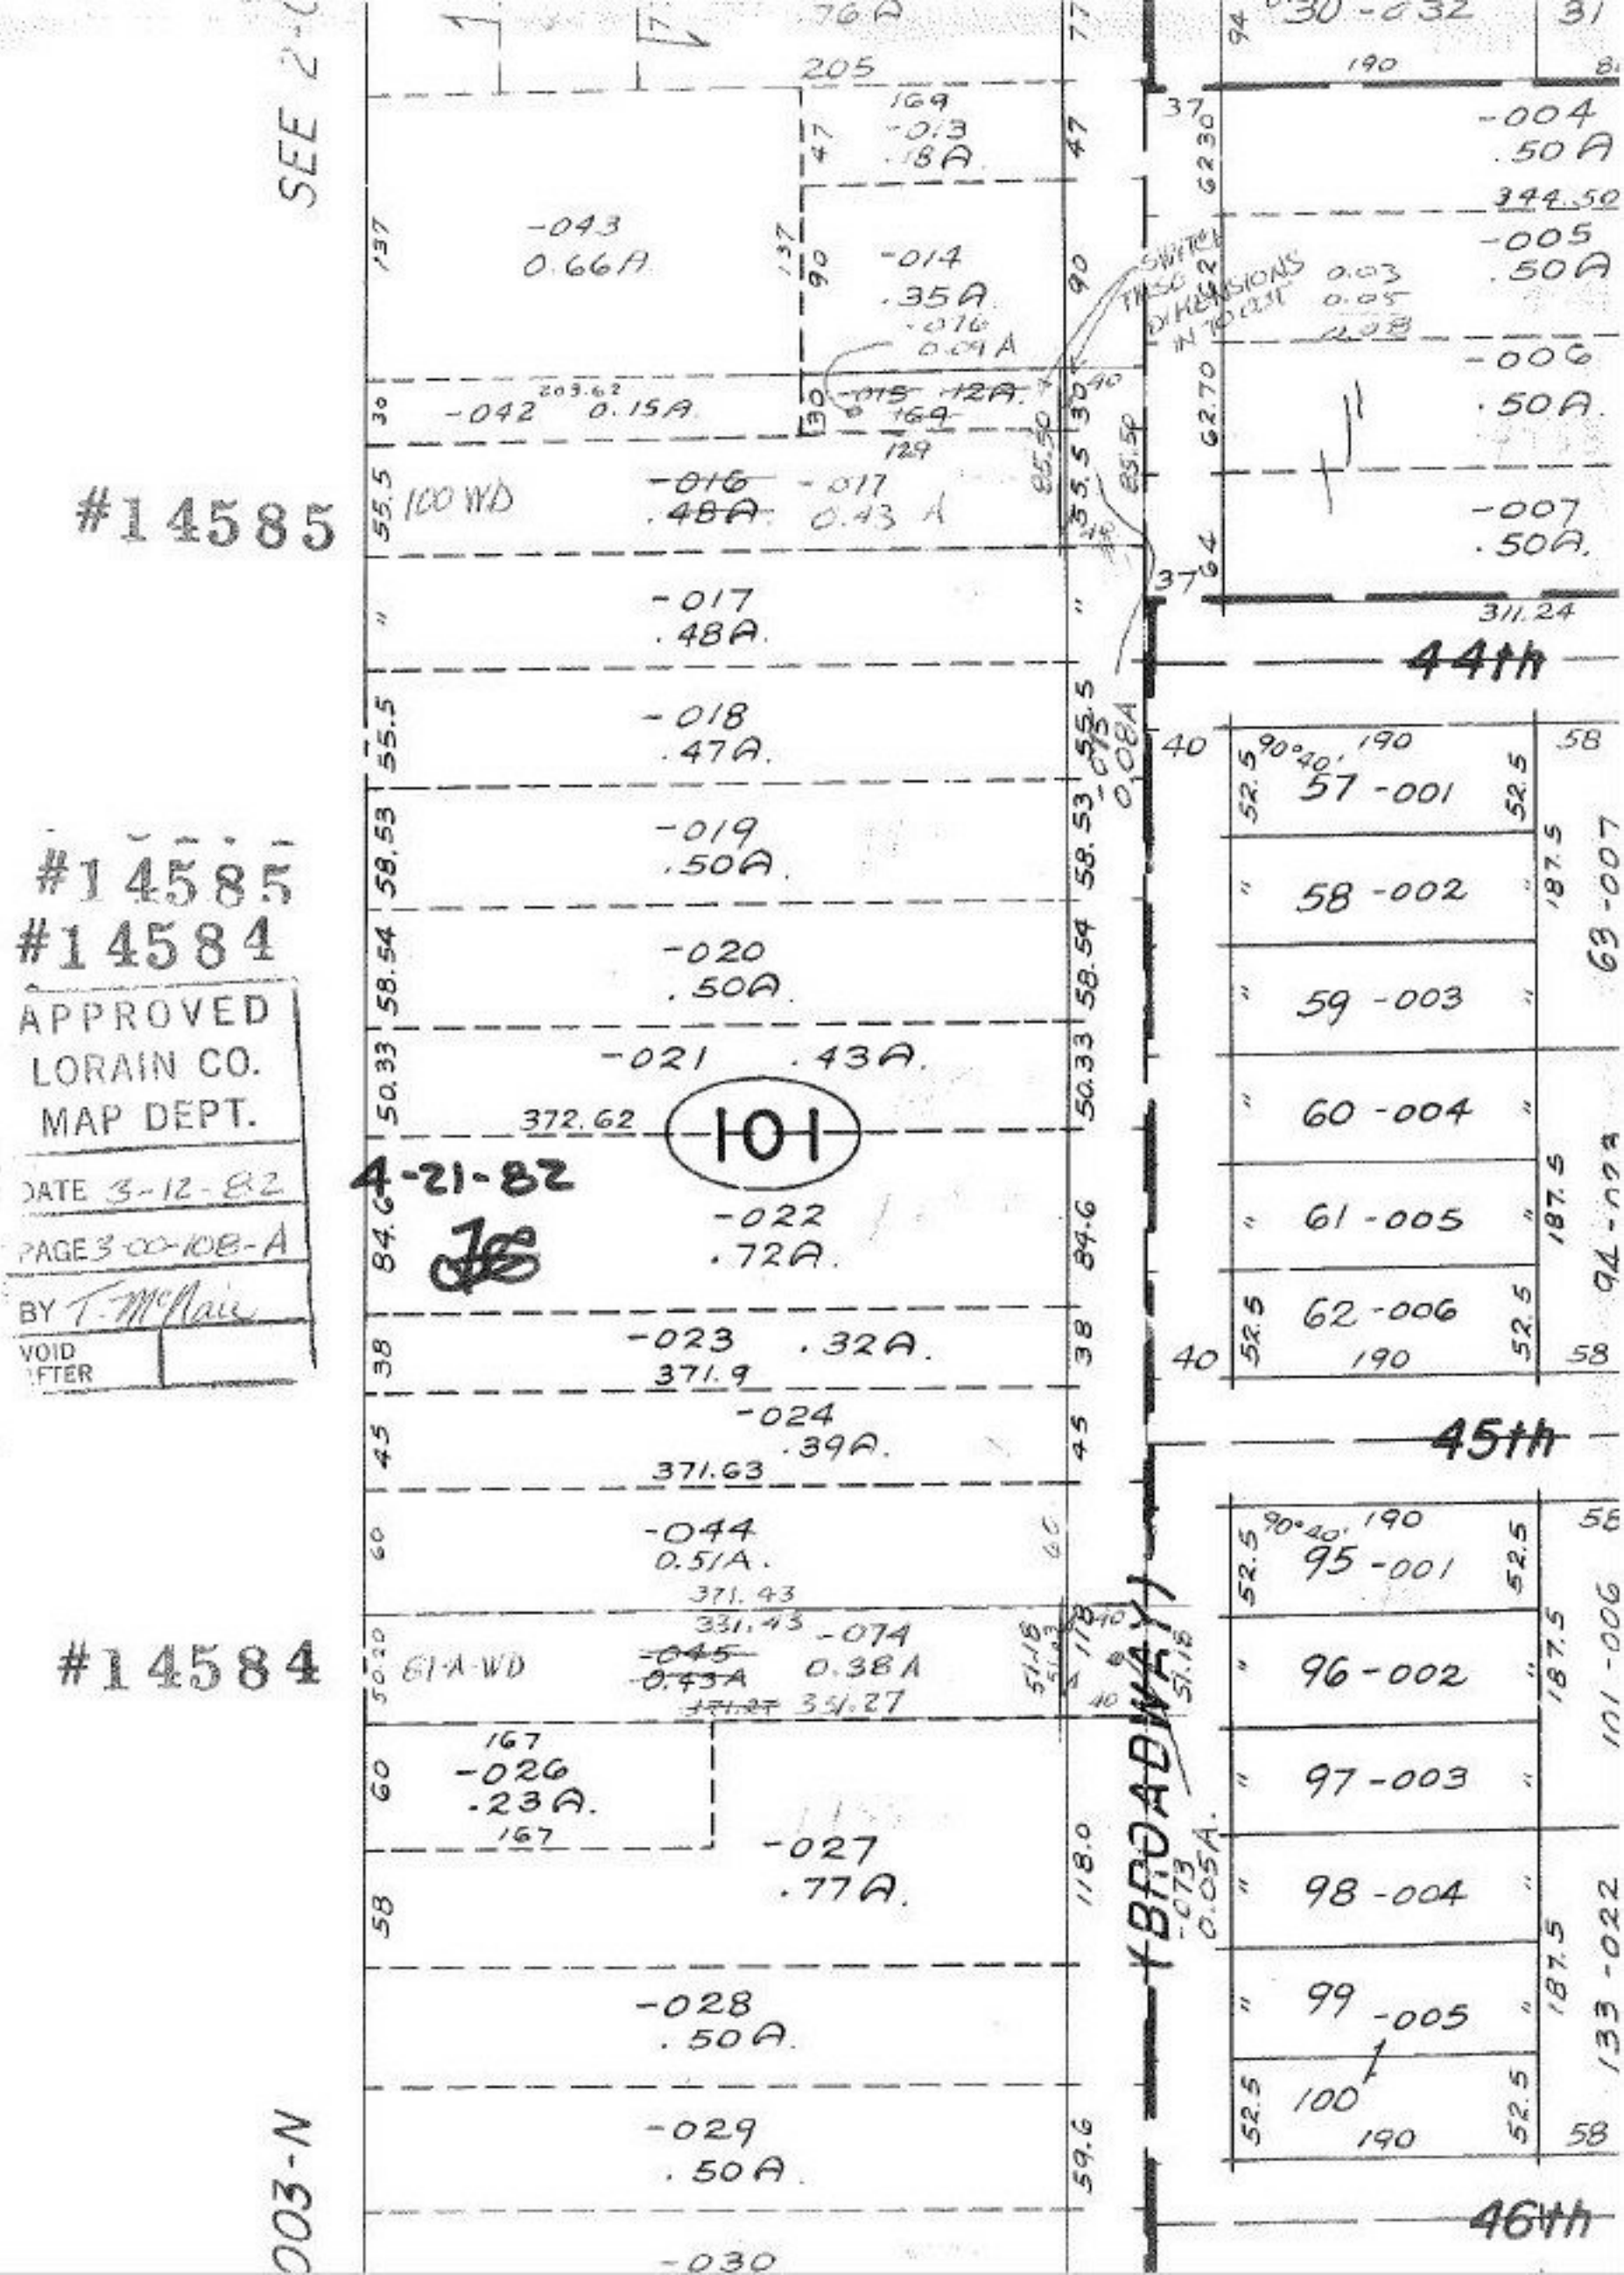

SEE 2-0
#14585
#14585
#14584
APPROVED
LORAIN CO.
MAP DEPT.
DATE 3-12-82
PAGE 3-00-108-A
BY T. McNair
VOID AFTER
#14584
003-N
4-21-82
101
100 WD
61-A-WD
SWITCH THESE DIMENSIONS IN TO CUT
44th
45th
46th
BROADWAY
-043 0.66A
-042 0.15A
-016 .48A
-017 0.43 A
-017 .48A
-018 .47A
-019 .50A
-020 .50A
-021 .43A
-022 .72A
-023 .32A
-024 .39A
-044 0.51A
-045 0.43A
-074 0.38A
-026 .23A
-027 .77A
-028 .50A
-029 .50A
-030
-004 .50A
-005 .50A
-006 .50A
-007 .50A
57-001
58-002
59-003
60-004
61-005
62-006
95-001
96-002
97-003
98-004
99-005
100