FE 4-H

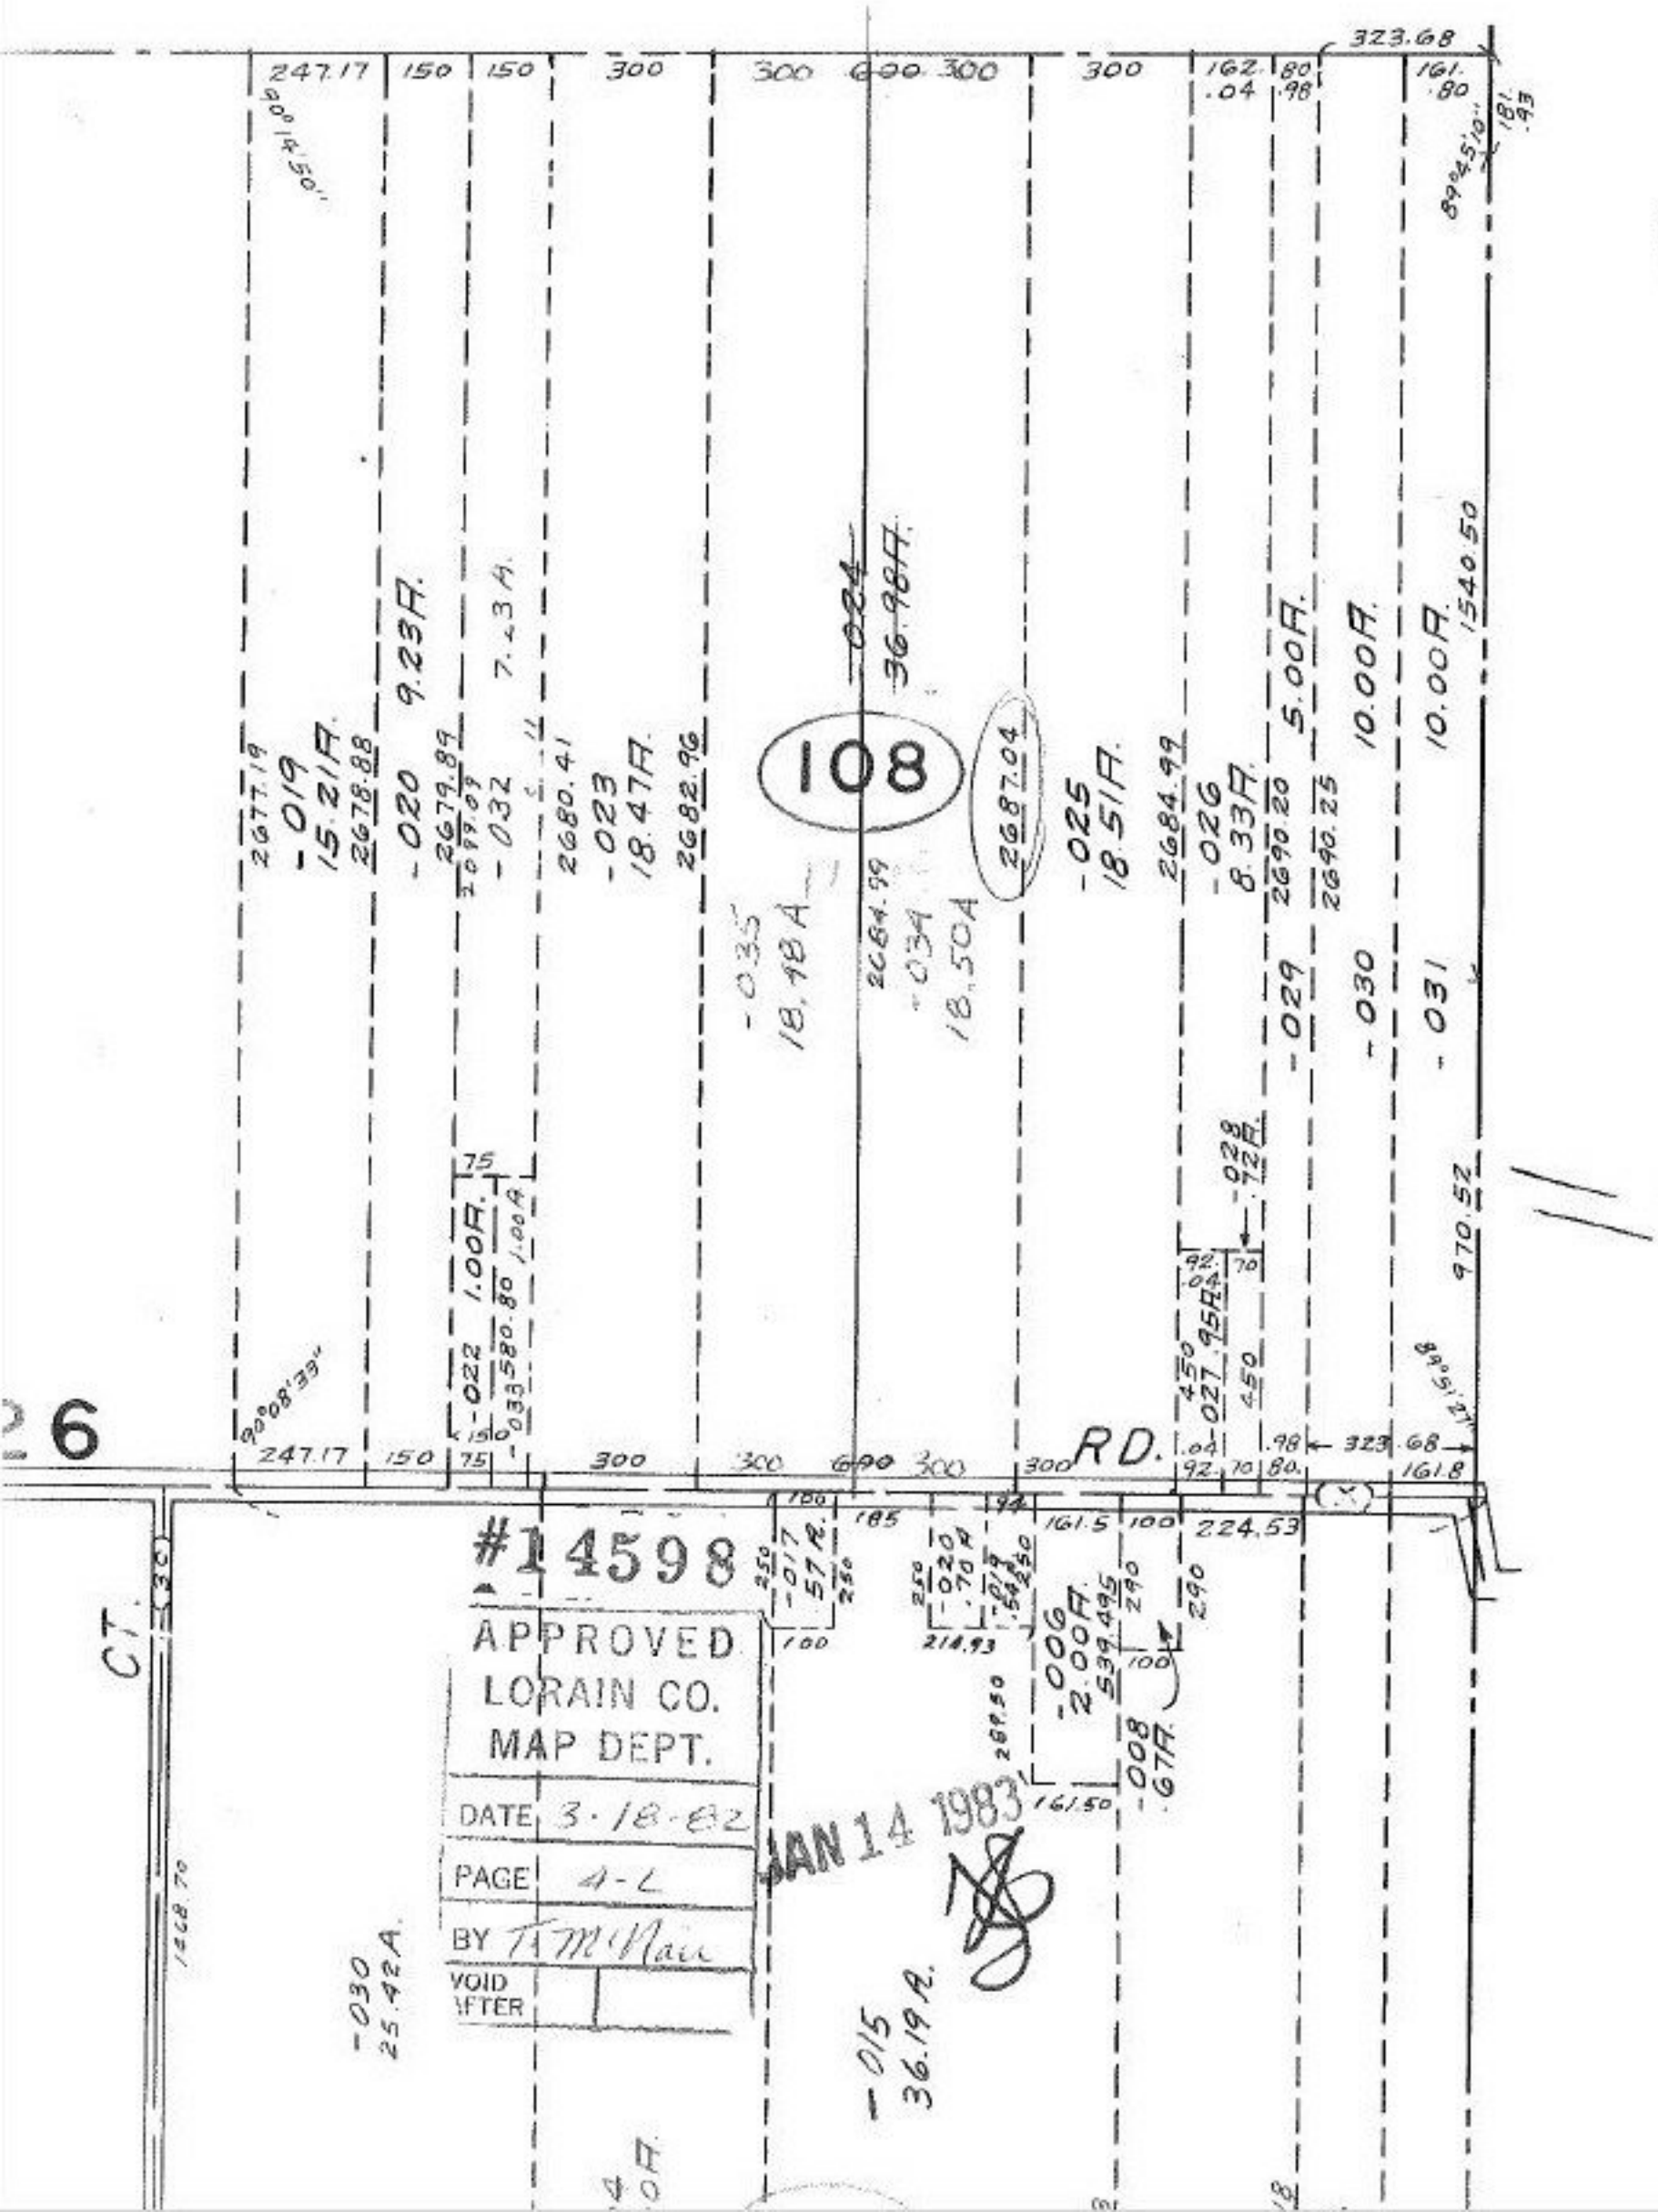
108
RD.
CT.
#14598
APPROVED
LORAIN CO.
MAP DEPT.
DATE 3-18-82
PAGE 4-L
BY TM Main
VOID AFTER
JAN 14 1983