#14603
#14604

APPROVED
LORAIN CO.
MAP DEPT.
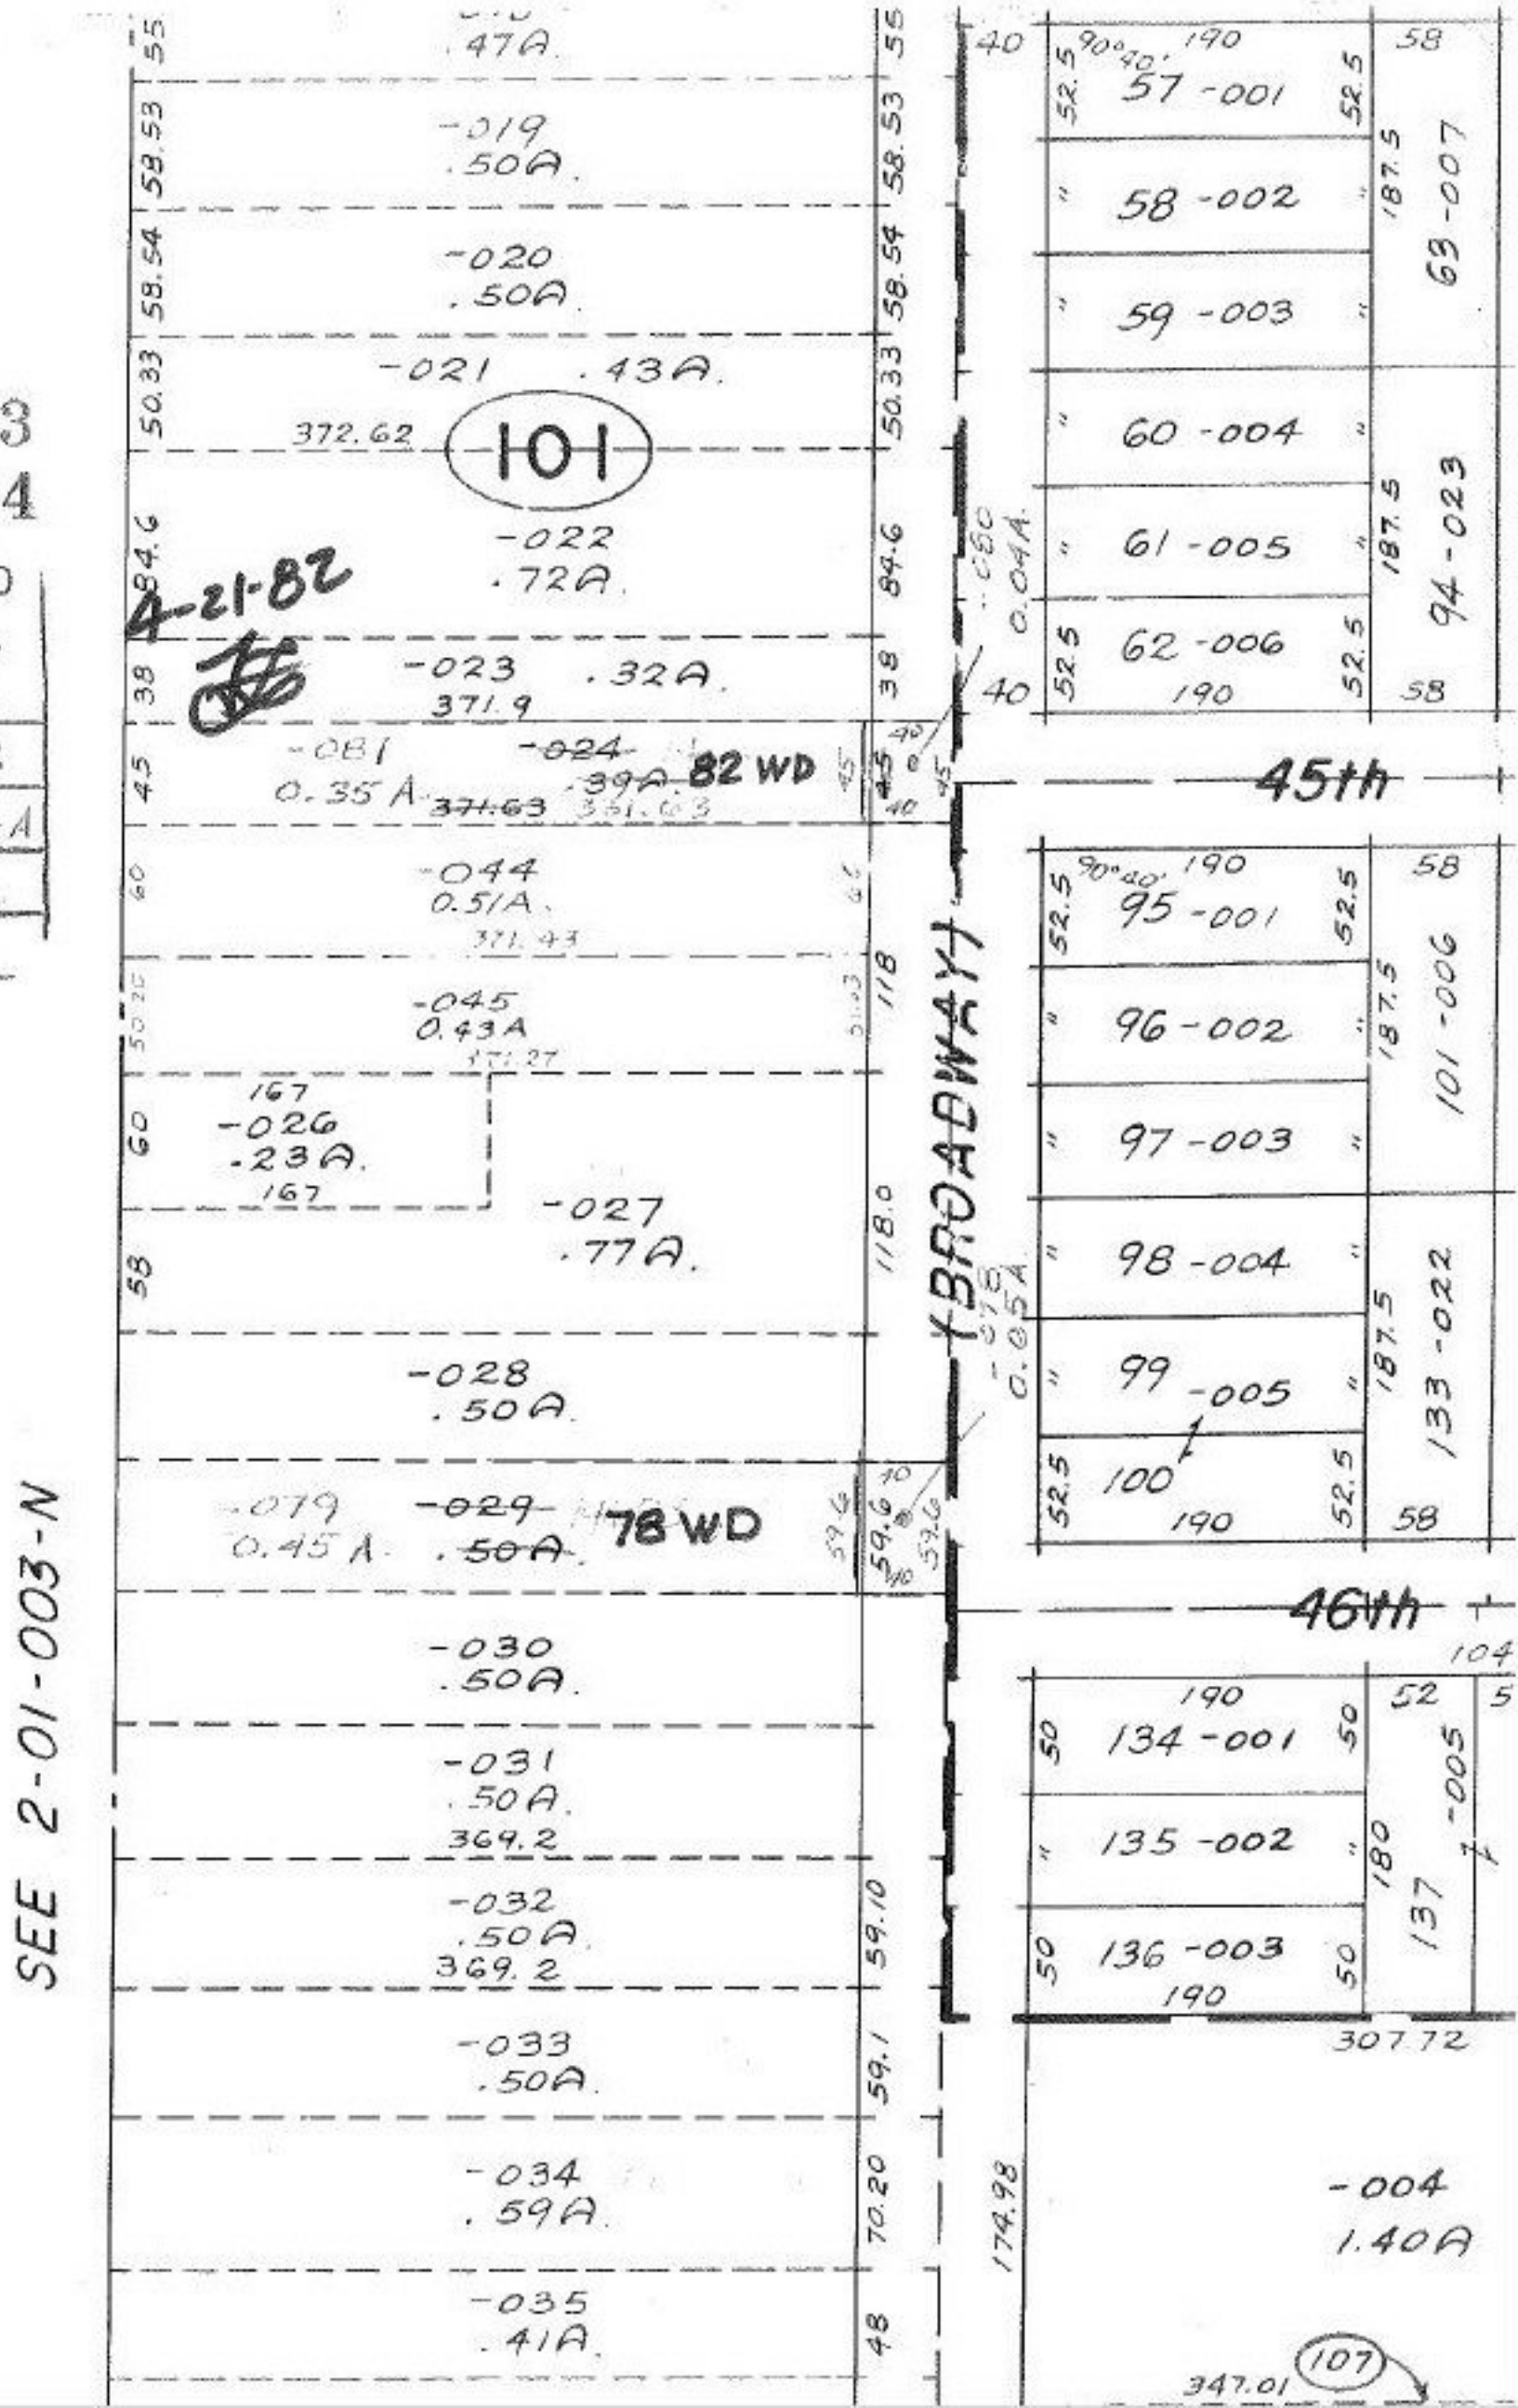
DATE 3.24.82
PAGE 3-00-108-A
BY T. McRae
VOID AFTER