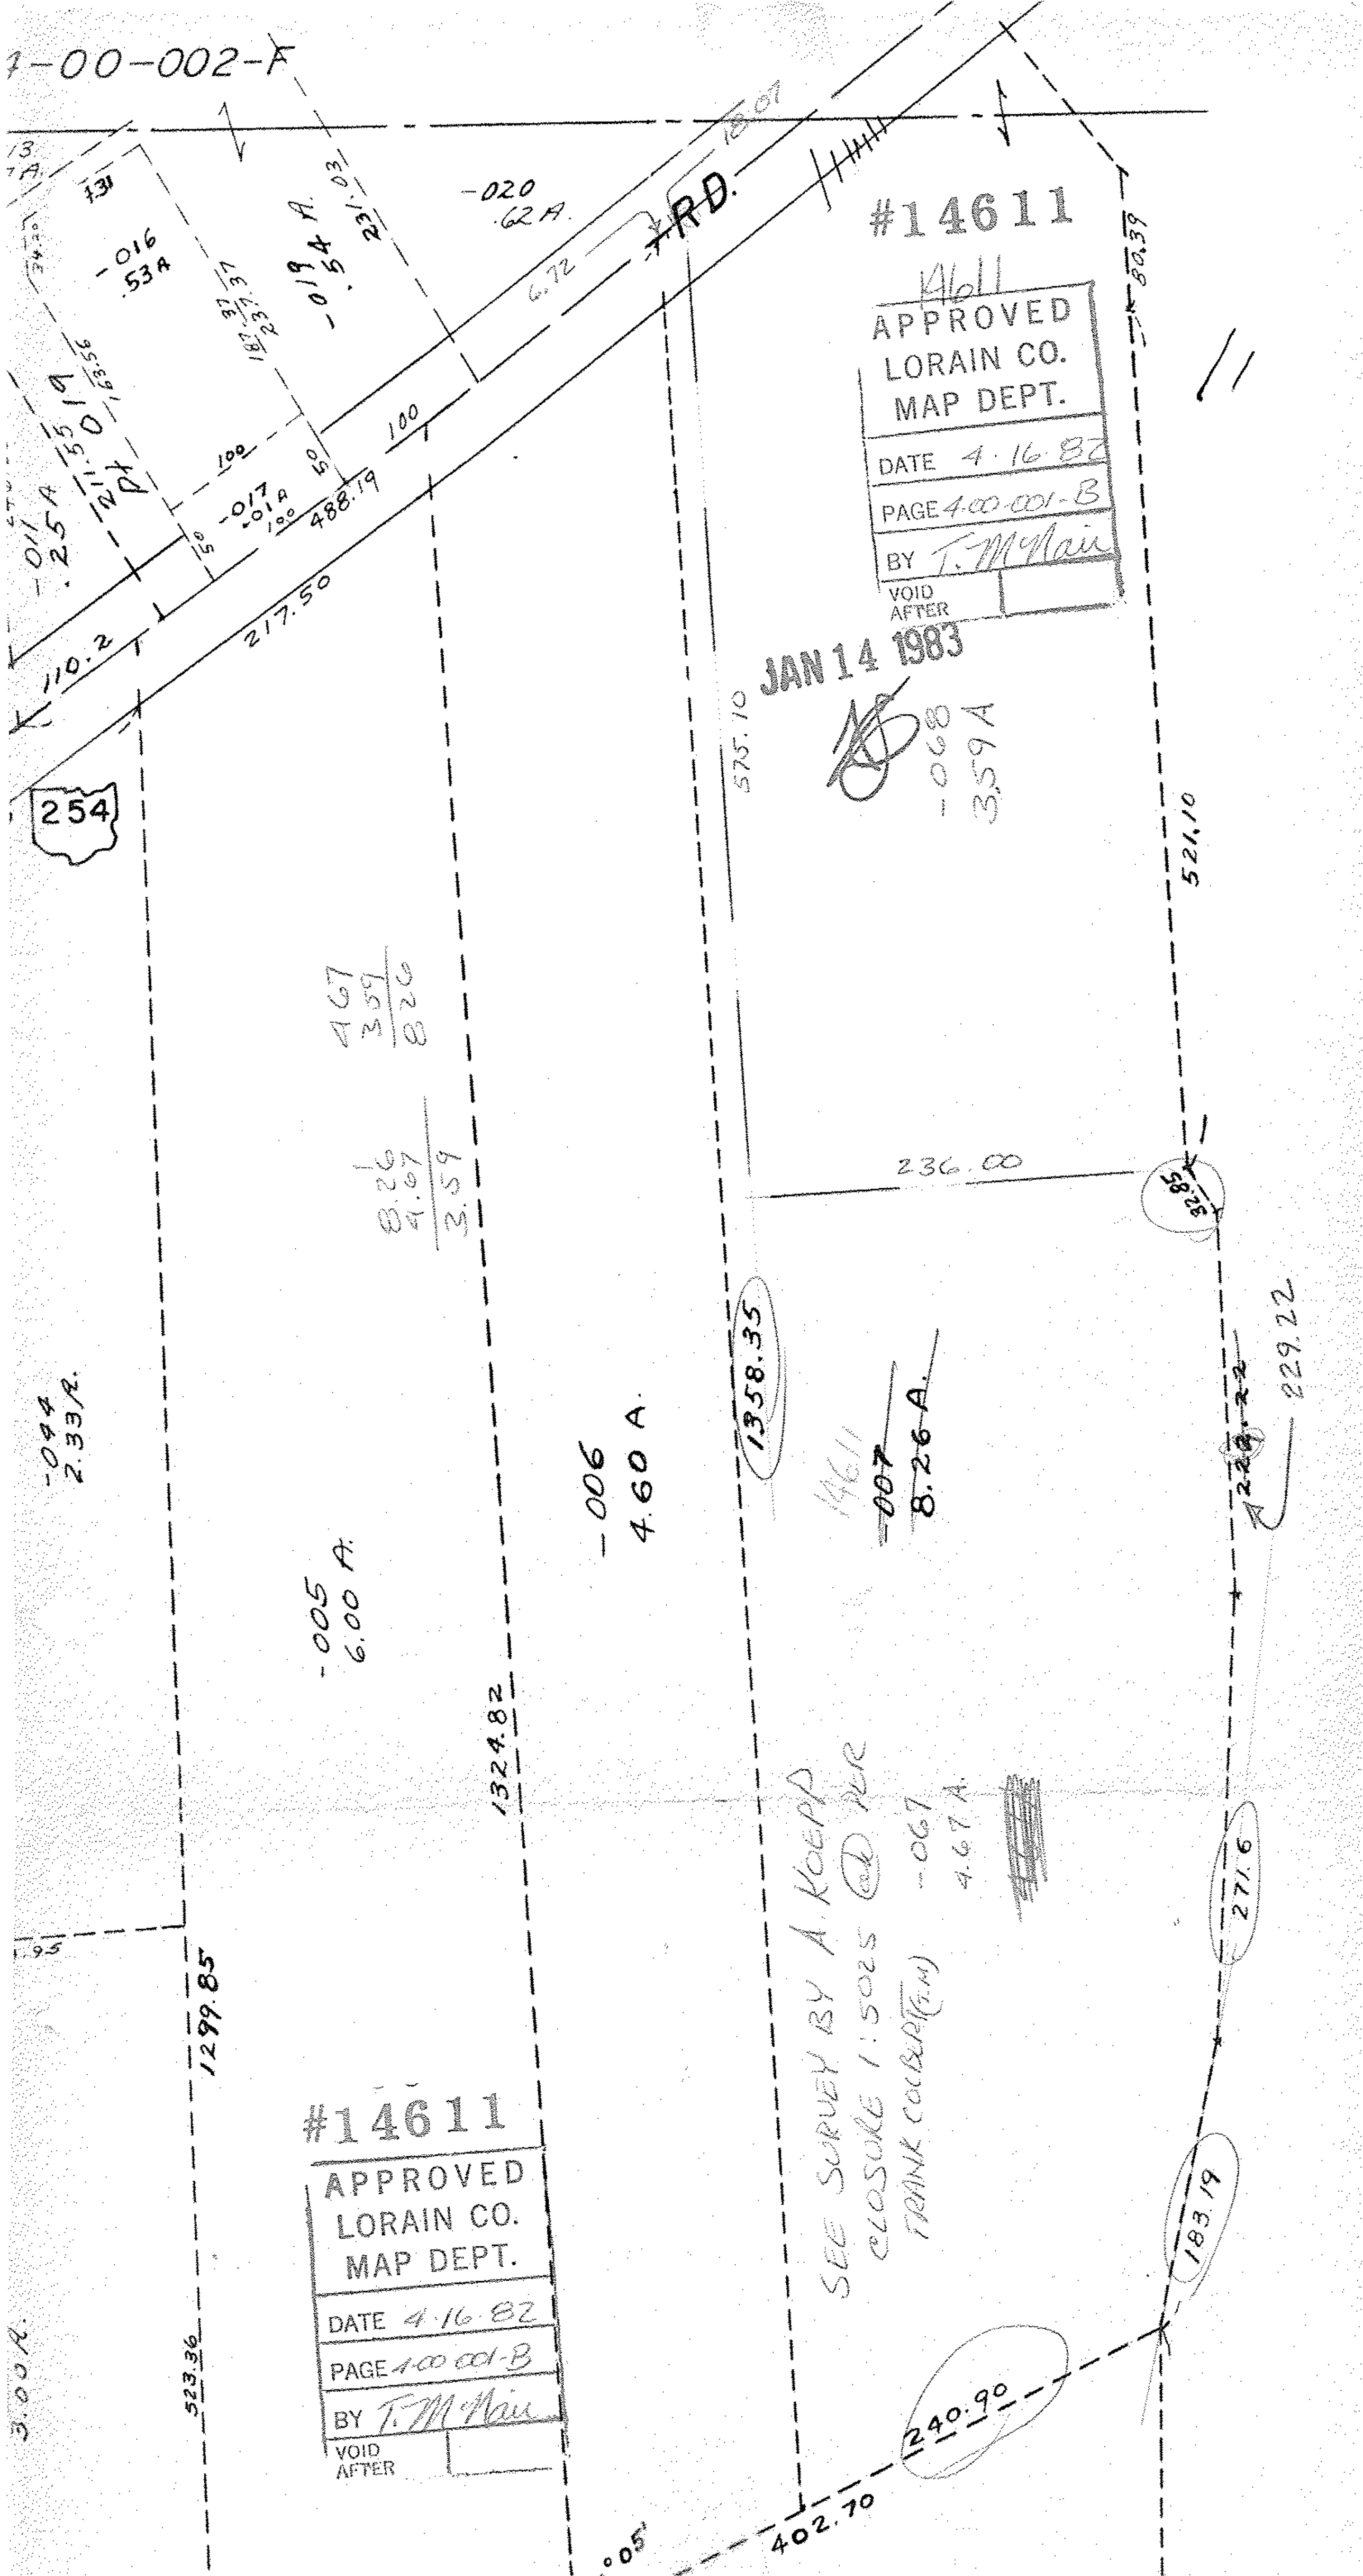

4-00-002-F
RD.
254
#14611
APPROVED
LORAIN CO.
MAP DEPT.
DATE 4.16.82
PAGE 4-00-001-B
BY T. McNair
VOID AFTER
JAN 14 1983
-020 .62 A.
-016 .53 A
-019 .54 A.
-017 .01 A
-011 .25 A
-019 Pt
-044 2.33 A.
-005 6.00 A.
-006 4.60 A.
-007 8.26 A.
-068 3.59 A
-067 4.67 A.
-044 3.00 A.
488.19
217.50
110.2
575.10
521.10
236.00
1358.35
1324.82
1299.85
523.36
402.70
240.90
183.19
271.6
229.22
32.85
80.39
6.72
18.07
SEE SURVEY BY A. KOEPP
CLOSURE 1:5025 @ PER
FRANK COLBERT (F.M.)