


SEE 2-01-003-N

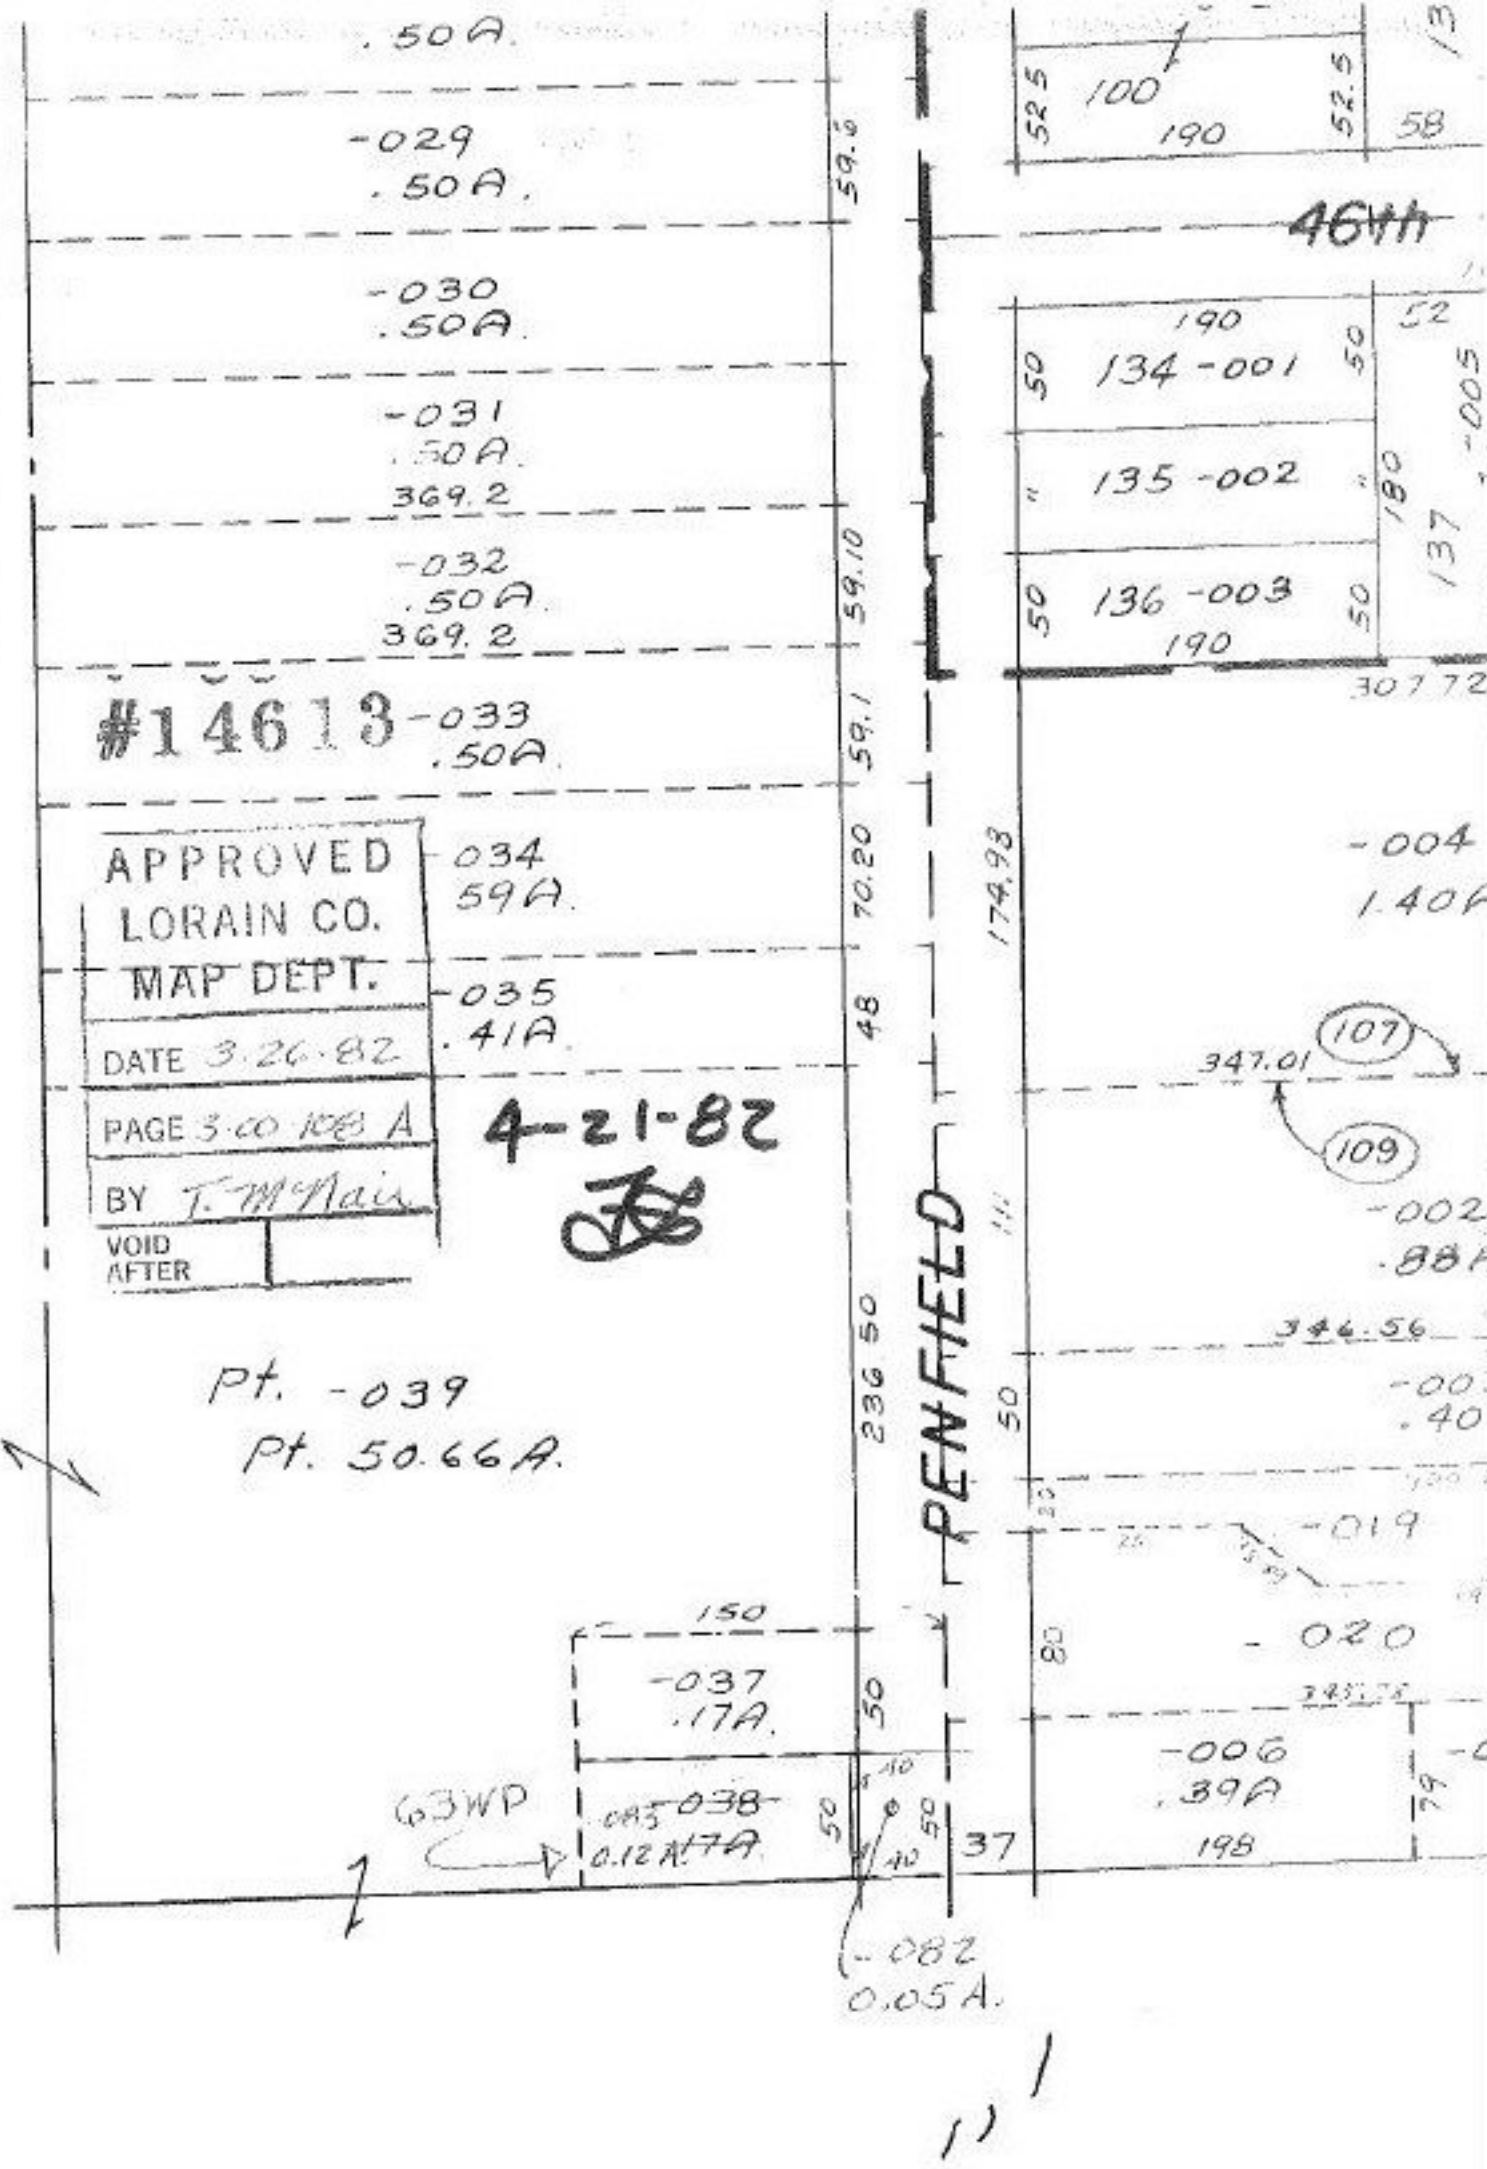

Copyright 1964

3-00-108-A

SHEFFIELD  
SCALE: 1" = 100'