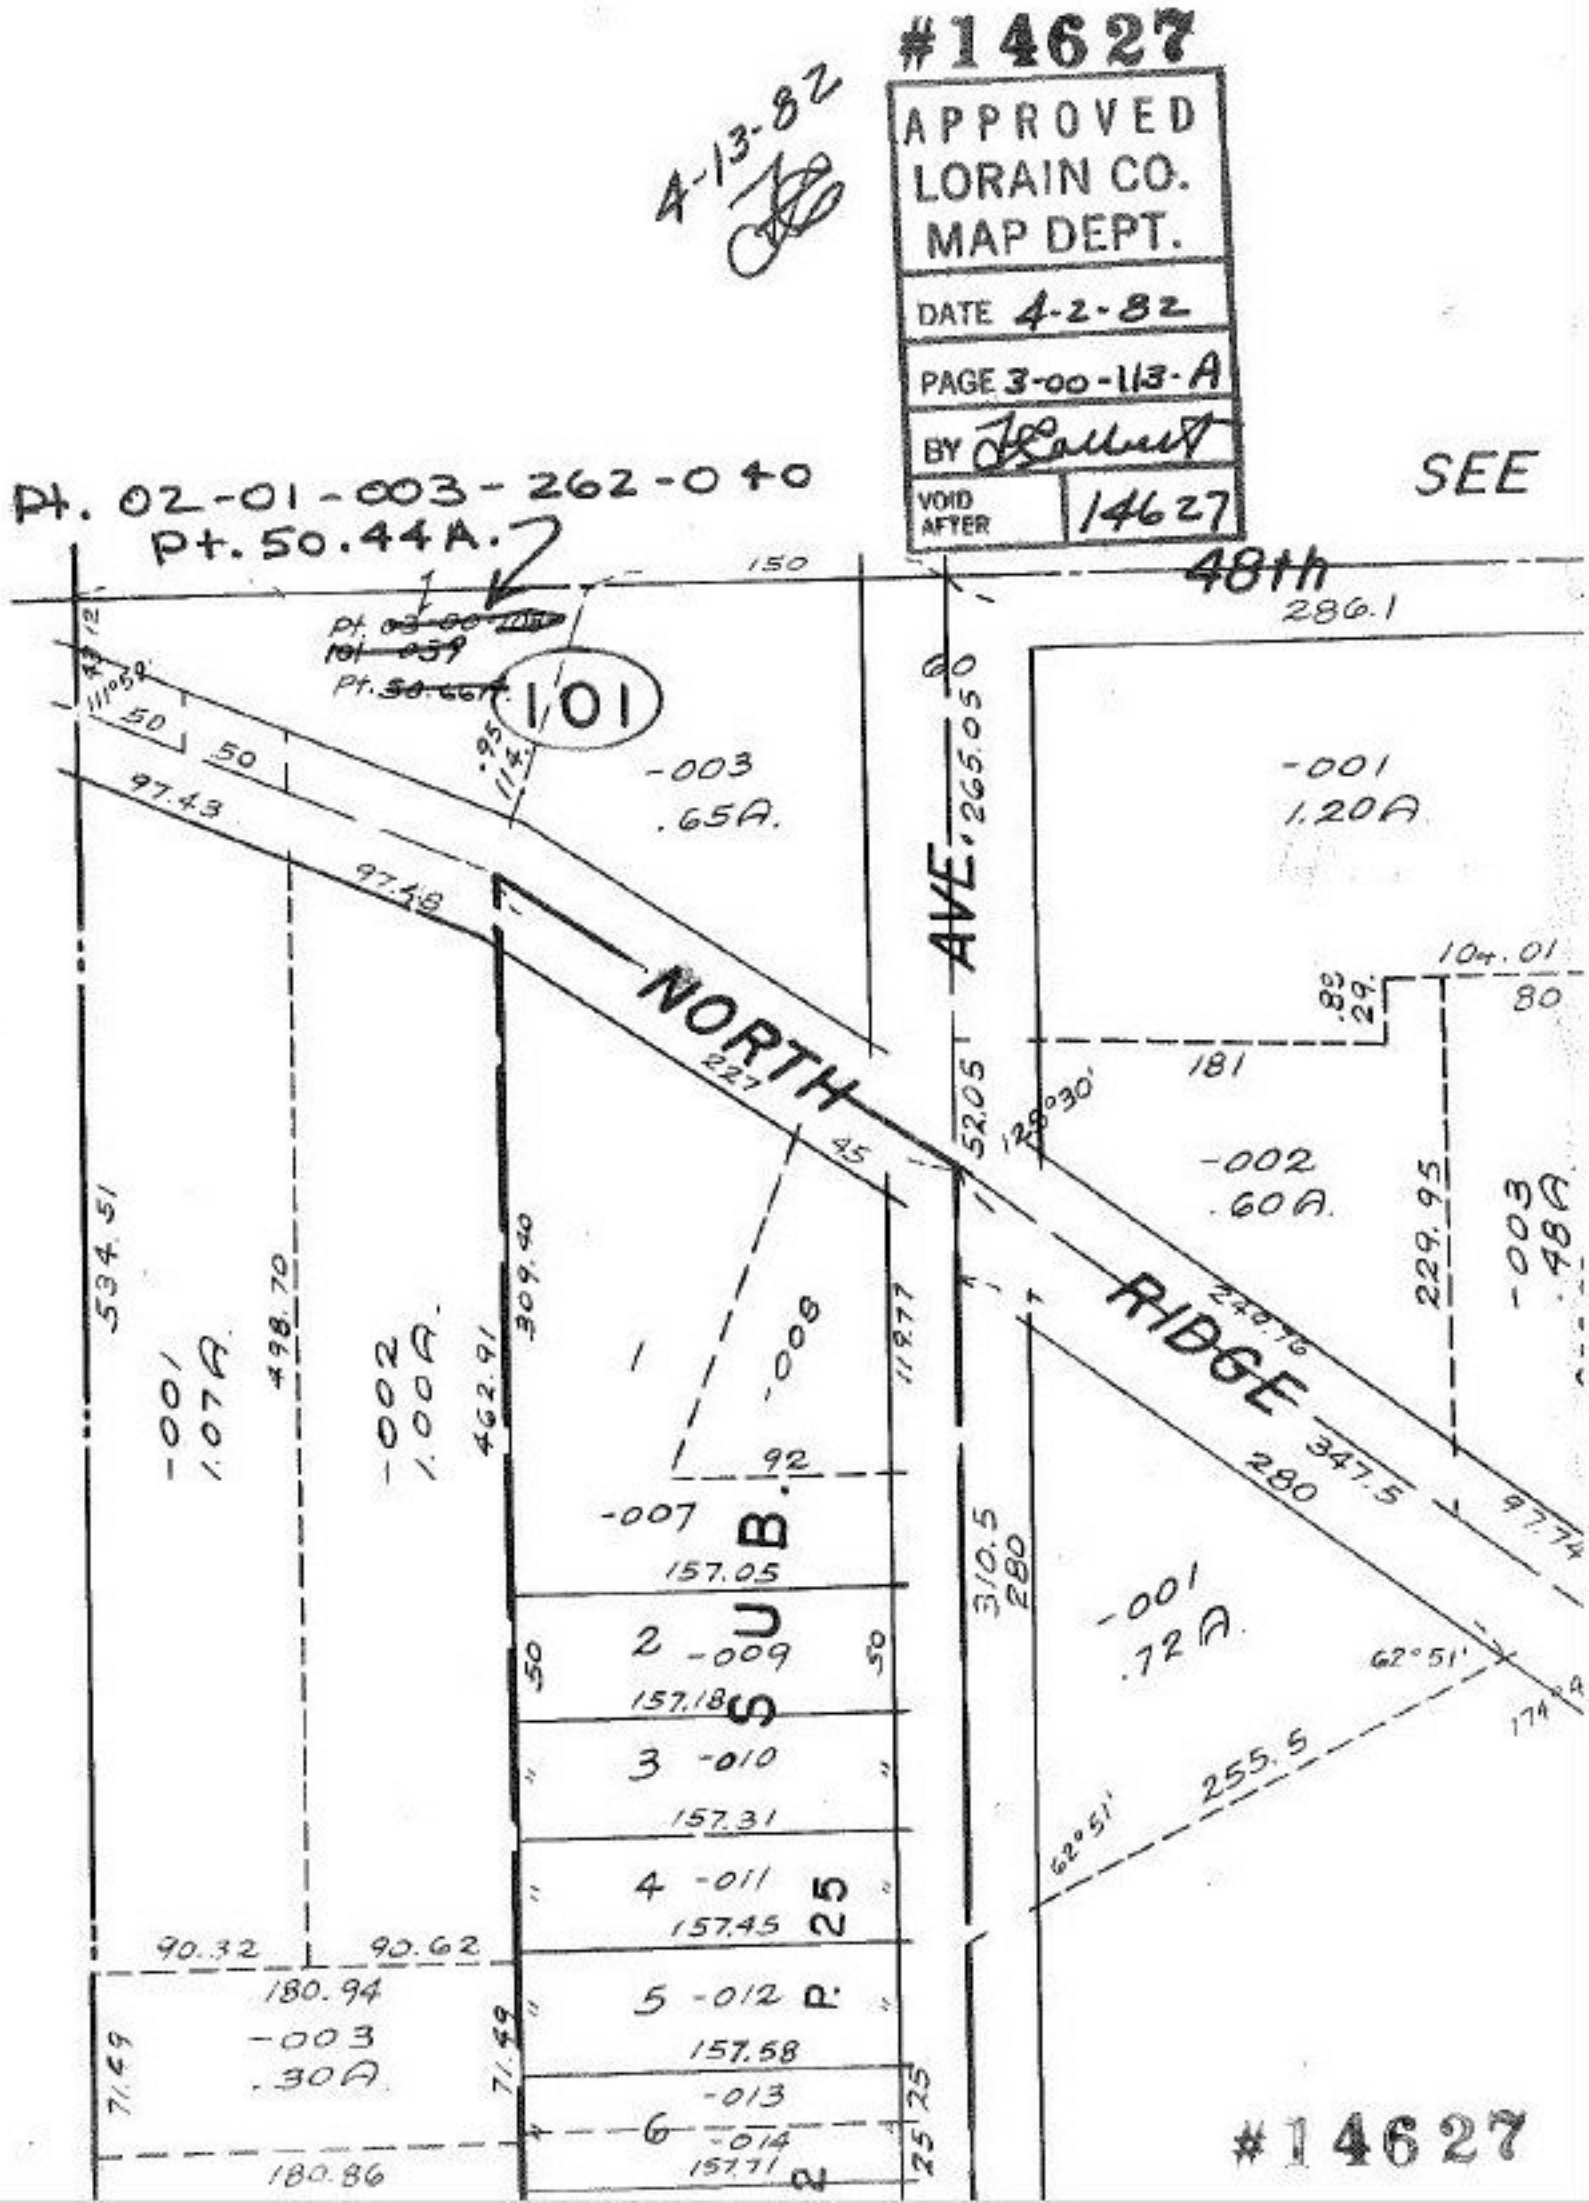

#14627
APPROVED
LORAIN CO.
MAP DEPT.
DATE 4-2-82
PAGE 3-00-113-A
BY
VOID AFTER 14627
4-13-82
SEE
Pt. 02-01-003-262-040
Pt. 50.44A.
48th
286.1
101
-003
.65A.
-001
1.20A
NORTH
AVE.
RIDGE
-002
.60A.
-003
.48A
-001
1.07A
-002
1.00A
-008
-007
SUB.
2 -009
3 -010
4 -011
5 -012
6 -013
-014
P. 25
-001
.72A
-003
.30A
#14627