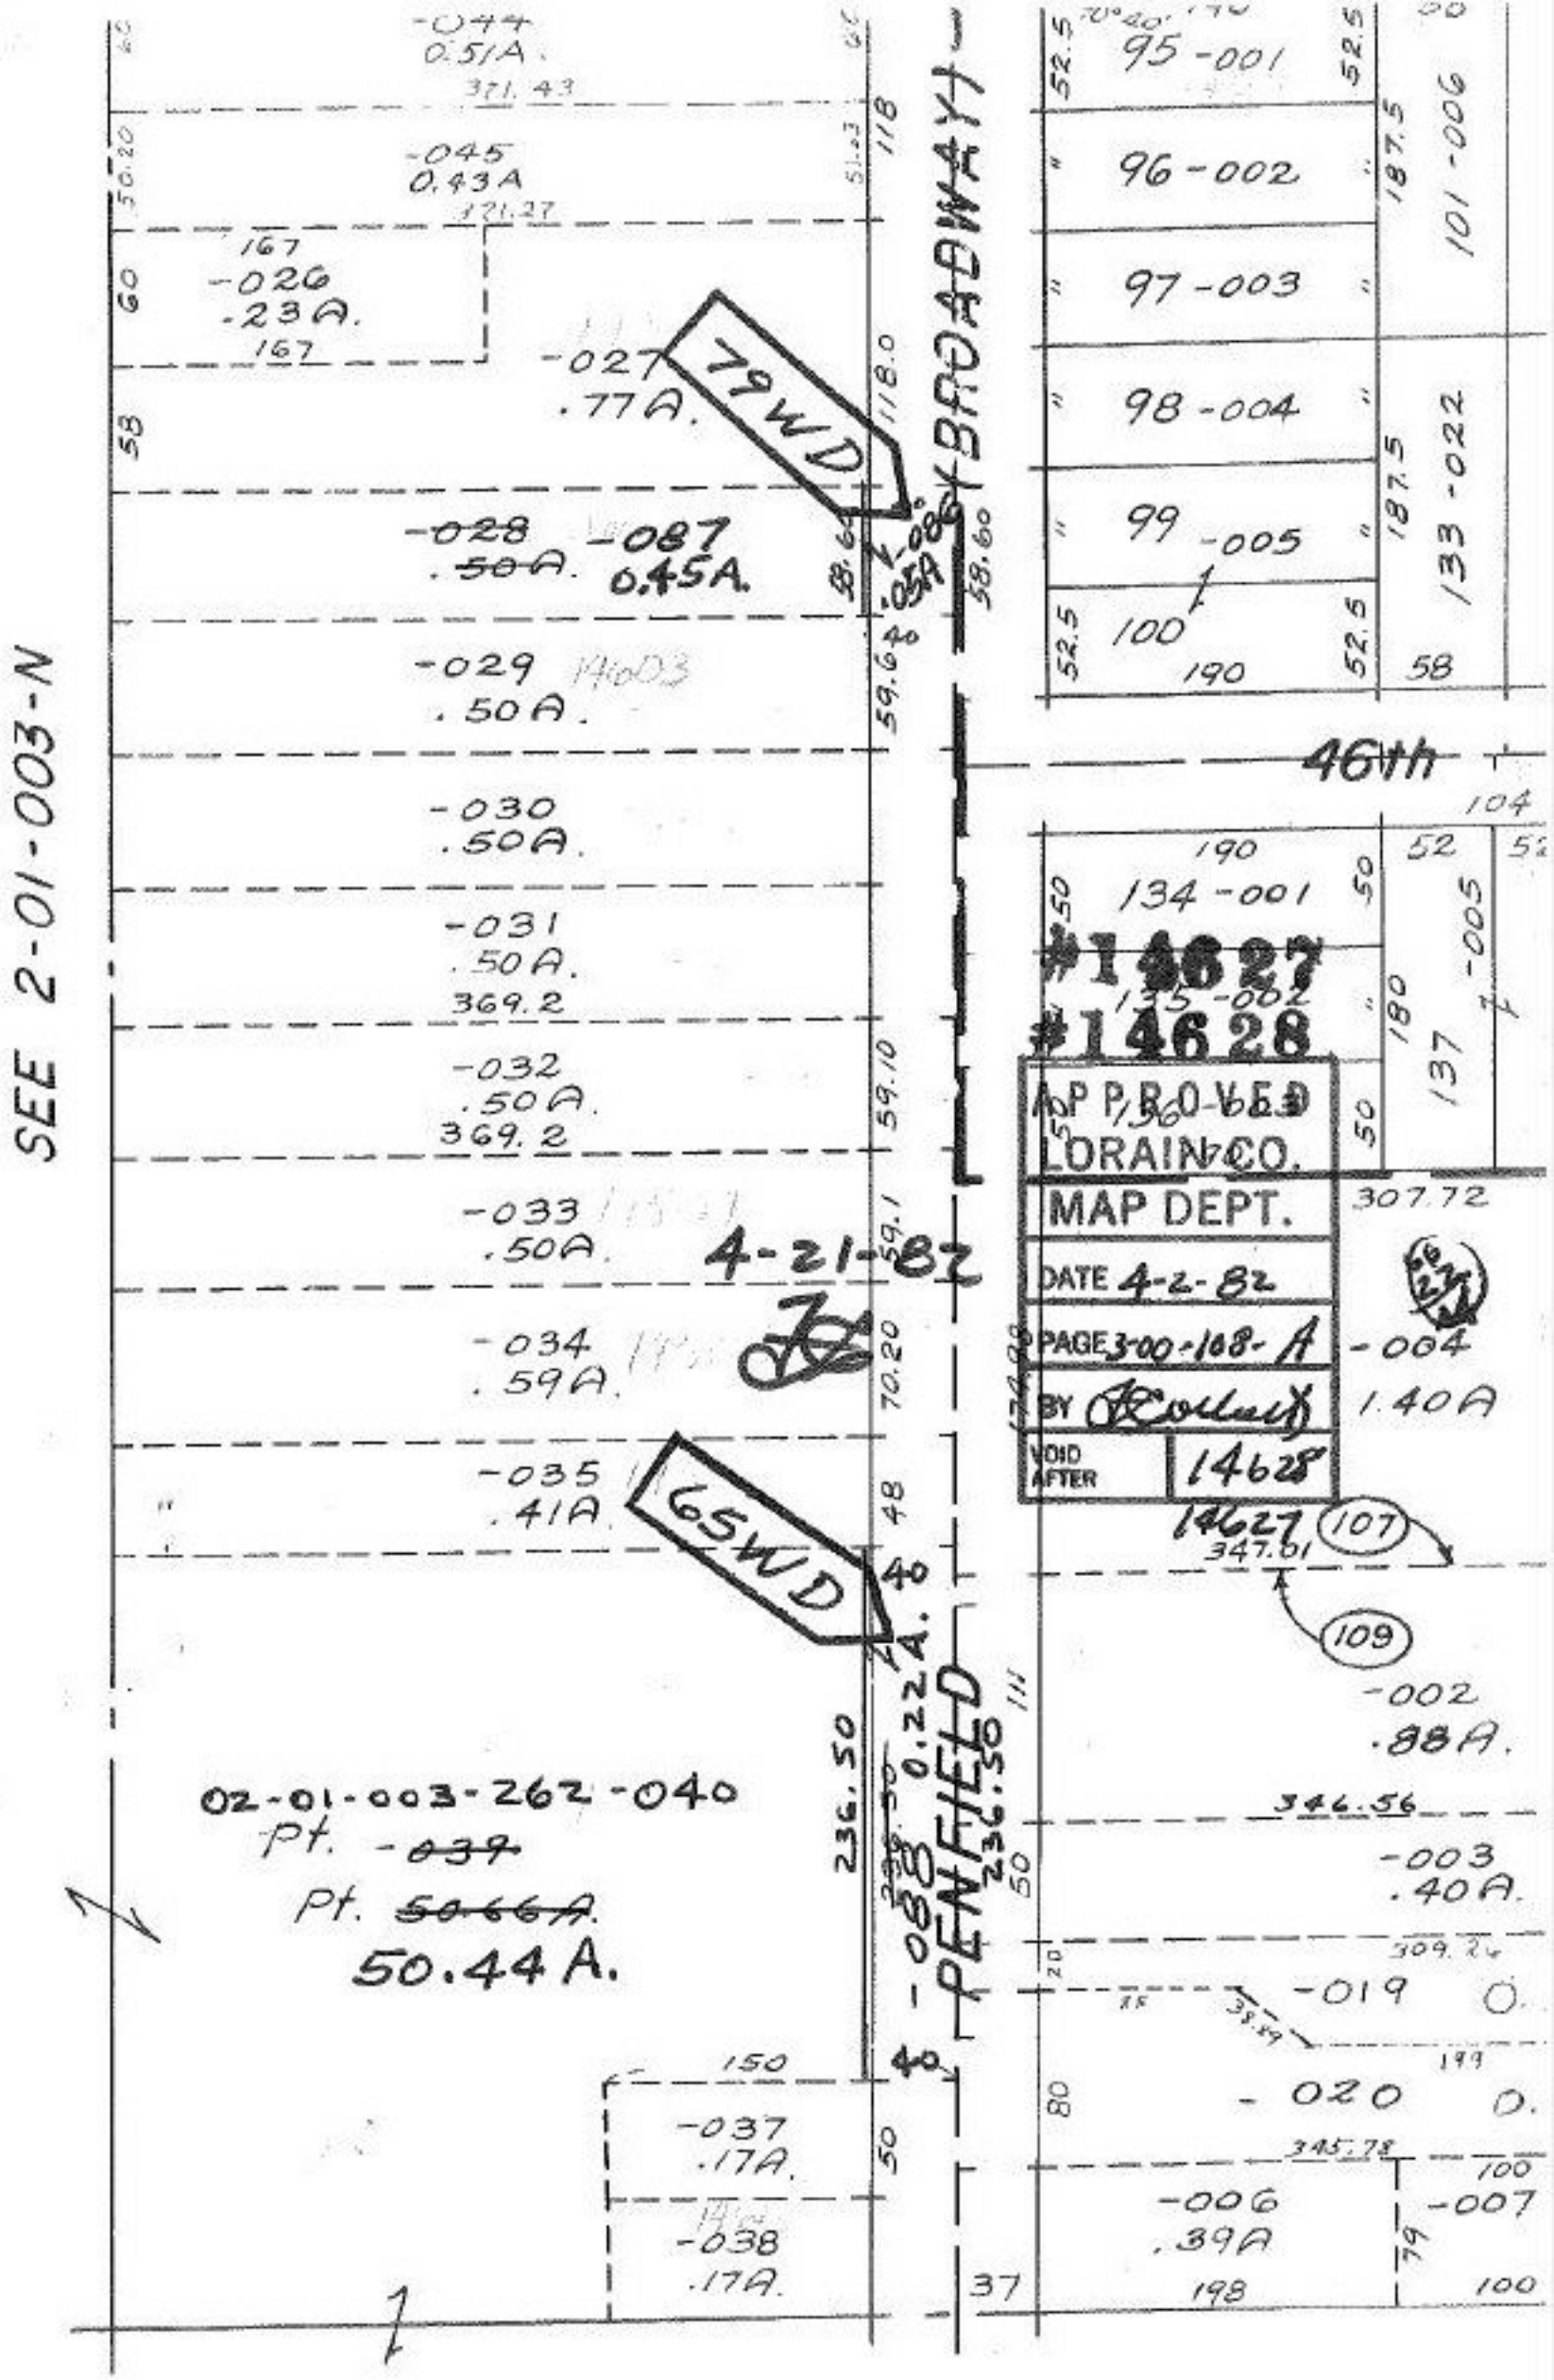

SEE 2-01-003-N
-044
0.51A.
371.43
-045
0.43A
321.27
167
-026
.23A.
167
-027
.77A.
79WD
-028
.50A.
-087
0.45A.
-086
.05A
-029
.50A.
-030
.50A.
-031
.50A.
369.2
-032
.50A.
369.2
-033
.50A.
4-21-82
-034
.59A.
-035
.41A.
65WD
0.22A.
PENFIELD
02-01-003-262-040
Pt. -039
Pt. 50.66A.
50.44 A.
-037
.17A.
-038
.17A.
95-001
96-002
97-003
98-004
99-005
100
190
101-006
133-022
46th
134-001
135-002
136-003
137-005
#14627
#14628
APPROVED
LORAIN CO.
MAP DEPT.
DATE 4-2-82
PAGE 3-00-108-A
BY
VOID AFTER 14628
14627
107
109
307.72
-004
1.40A
347.01
-002
.88A.
346.56
-003
.40A.
309.26
-019
-020
345.78
-006
.39A
-007
198
100