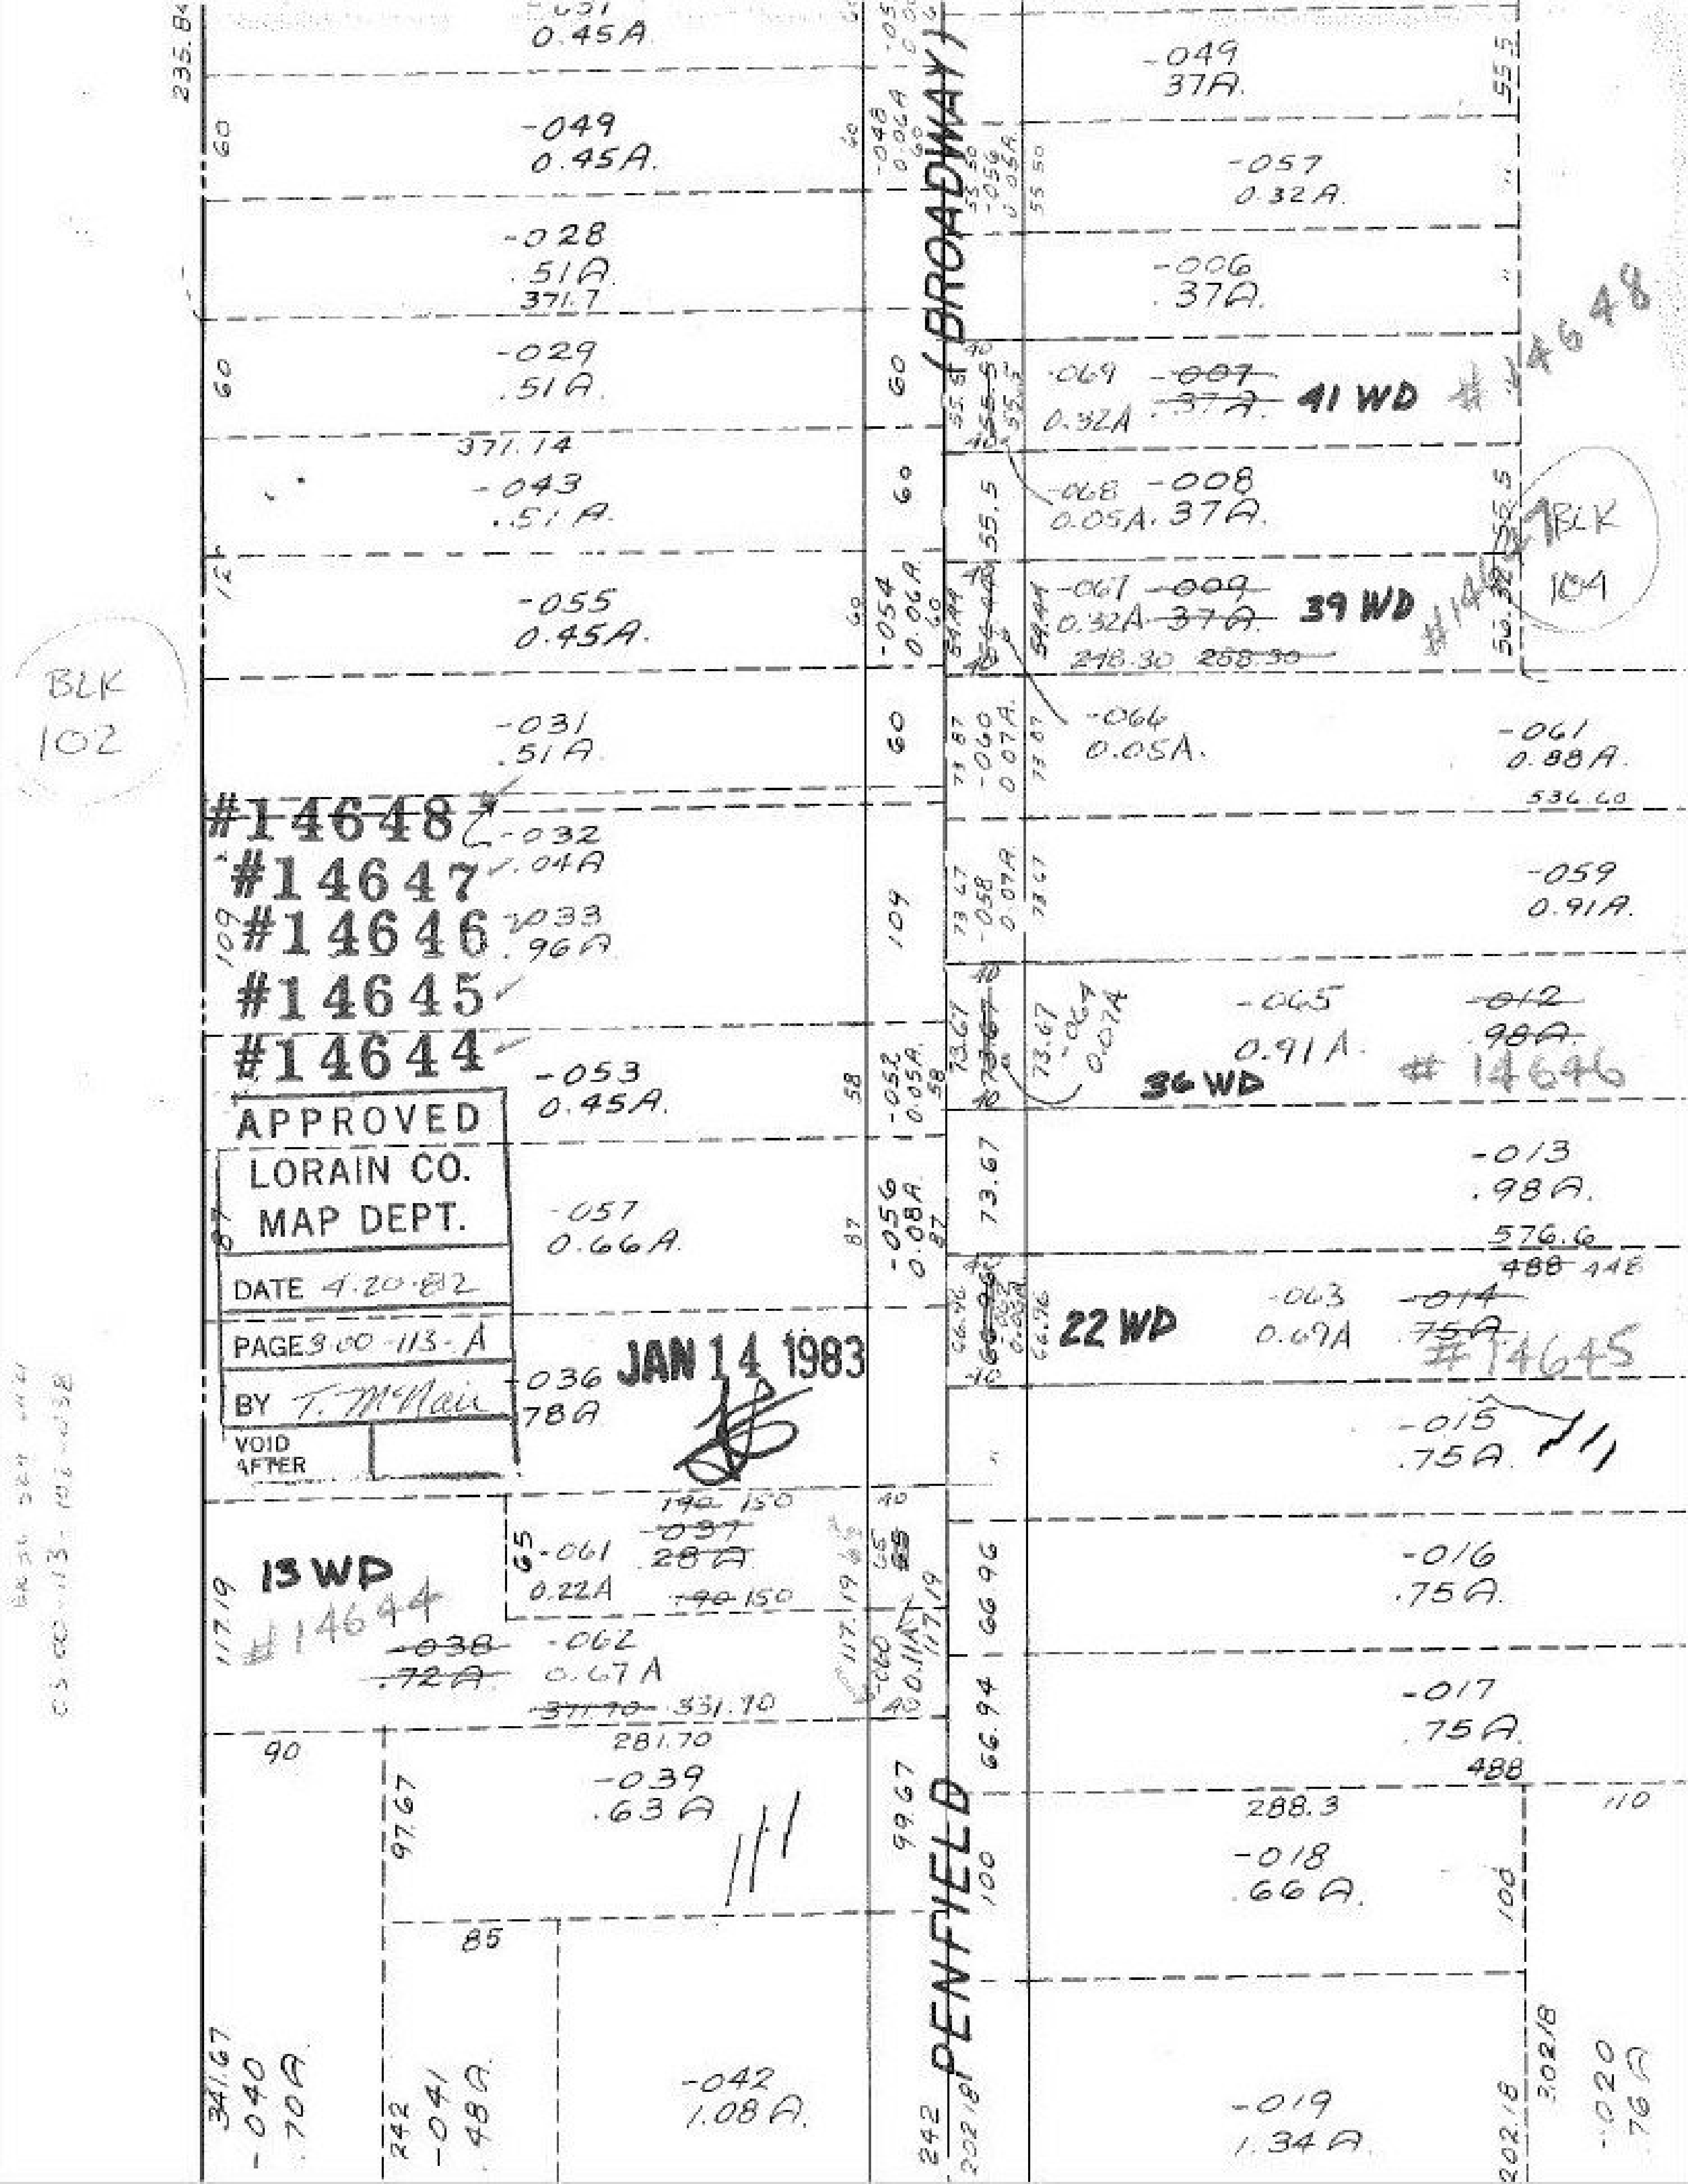
(BROADWAY)
PENFIELD
BLK 102
BLK 104
-049 0.45A.
-028 .51A. 371.7
-029 .51A.
371.14
-043 .51A.
-055 0.45A.
-031 .51A.
#14648
#14647
#14646
#14645
#14644
-032 .04A
-033 .96A
-053 0.45A.
-057 0.66A.
APPROVED
LORAIN CO.
MAP DEPT.
DATE 4-20-82
PAGE 300-113-A
BY T. McNair
VOID AFTER
-036 .78A
JAN 14 1983
13 WD
-061 0.22A
-037 .28A
-062 0.67A
-038 .72A
331.70
281.70
-039 .63A
-040 .70A
-041 .48A
-042 1.08A.
-049 .37A.
-057 0.32A.
-006 .37A.
-069 0.32A -007 .37A. 41 WD
-068 0.05A. -008 .37A.
-067 0.32A -009 .37A. 39 WD
248.30
-064 0.05A.
-061 0.88A.
536.60
-059 0.91A.
-065 0.91A. 36 WD
-012 .98A. #14646
-013 .98A.
576.6
22 WD
-063 0.69A
-014 .75A #14645
-015 .75A.
-016 .75A.
-017 .75A.
488
288.3
-018 .66A.
-019 1.34A.
-020 .76A