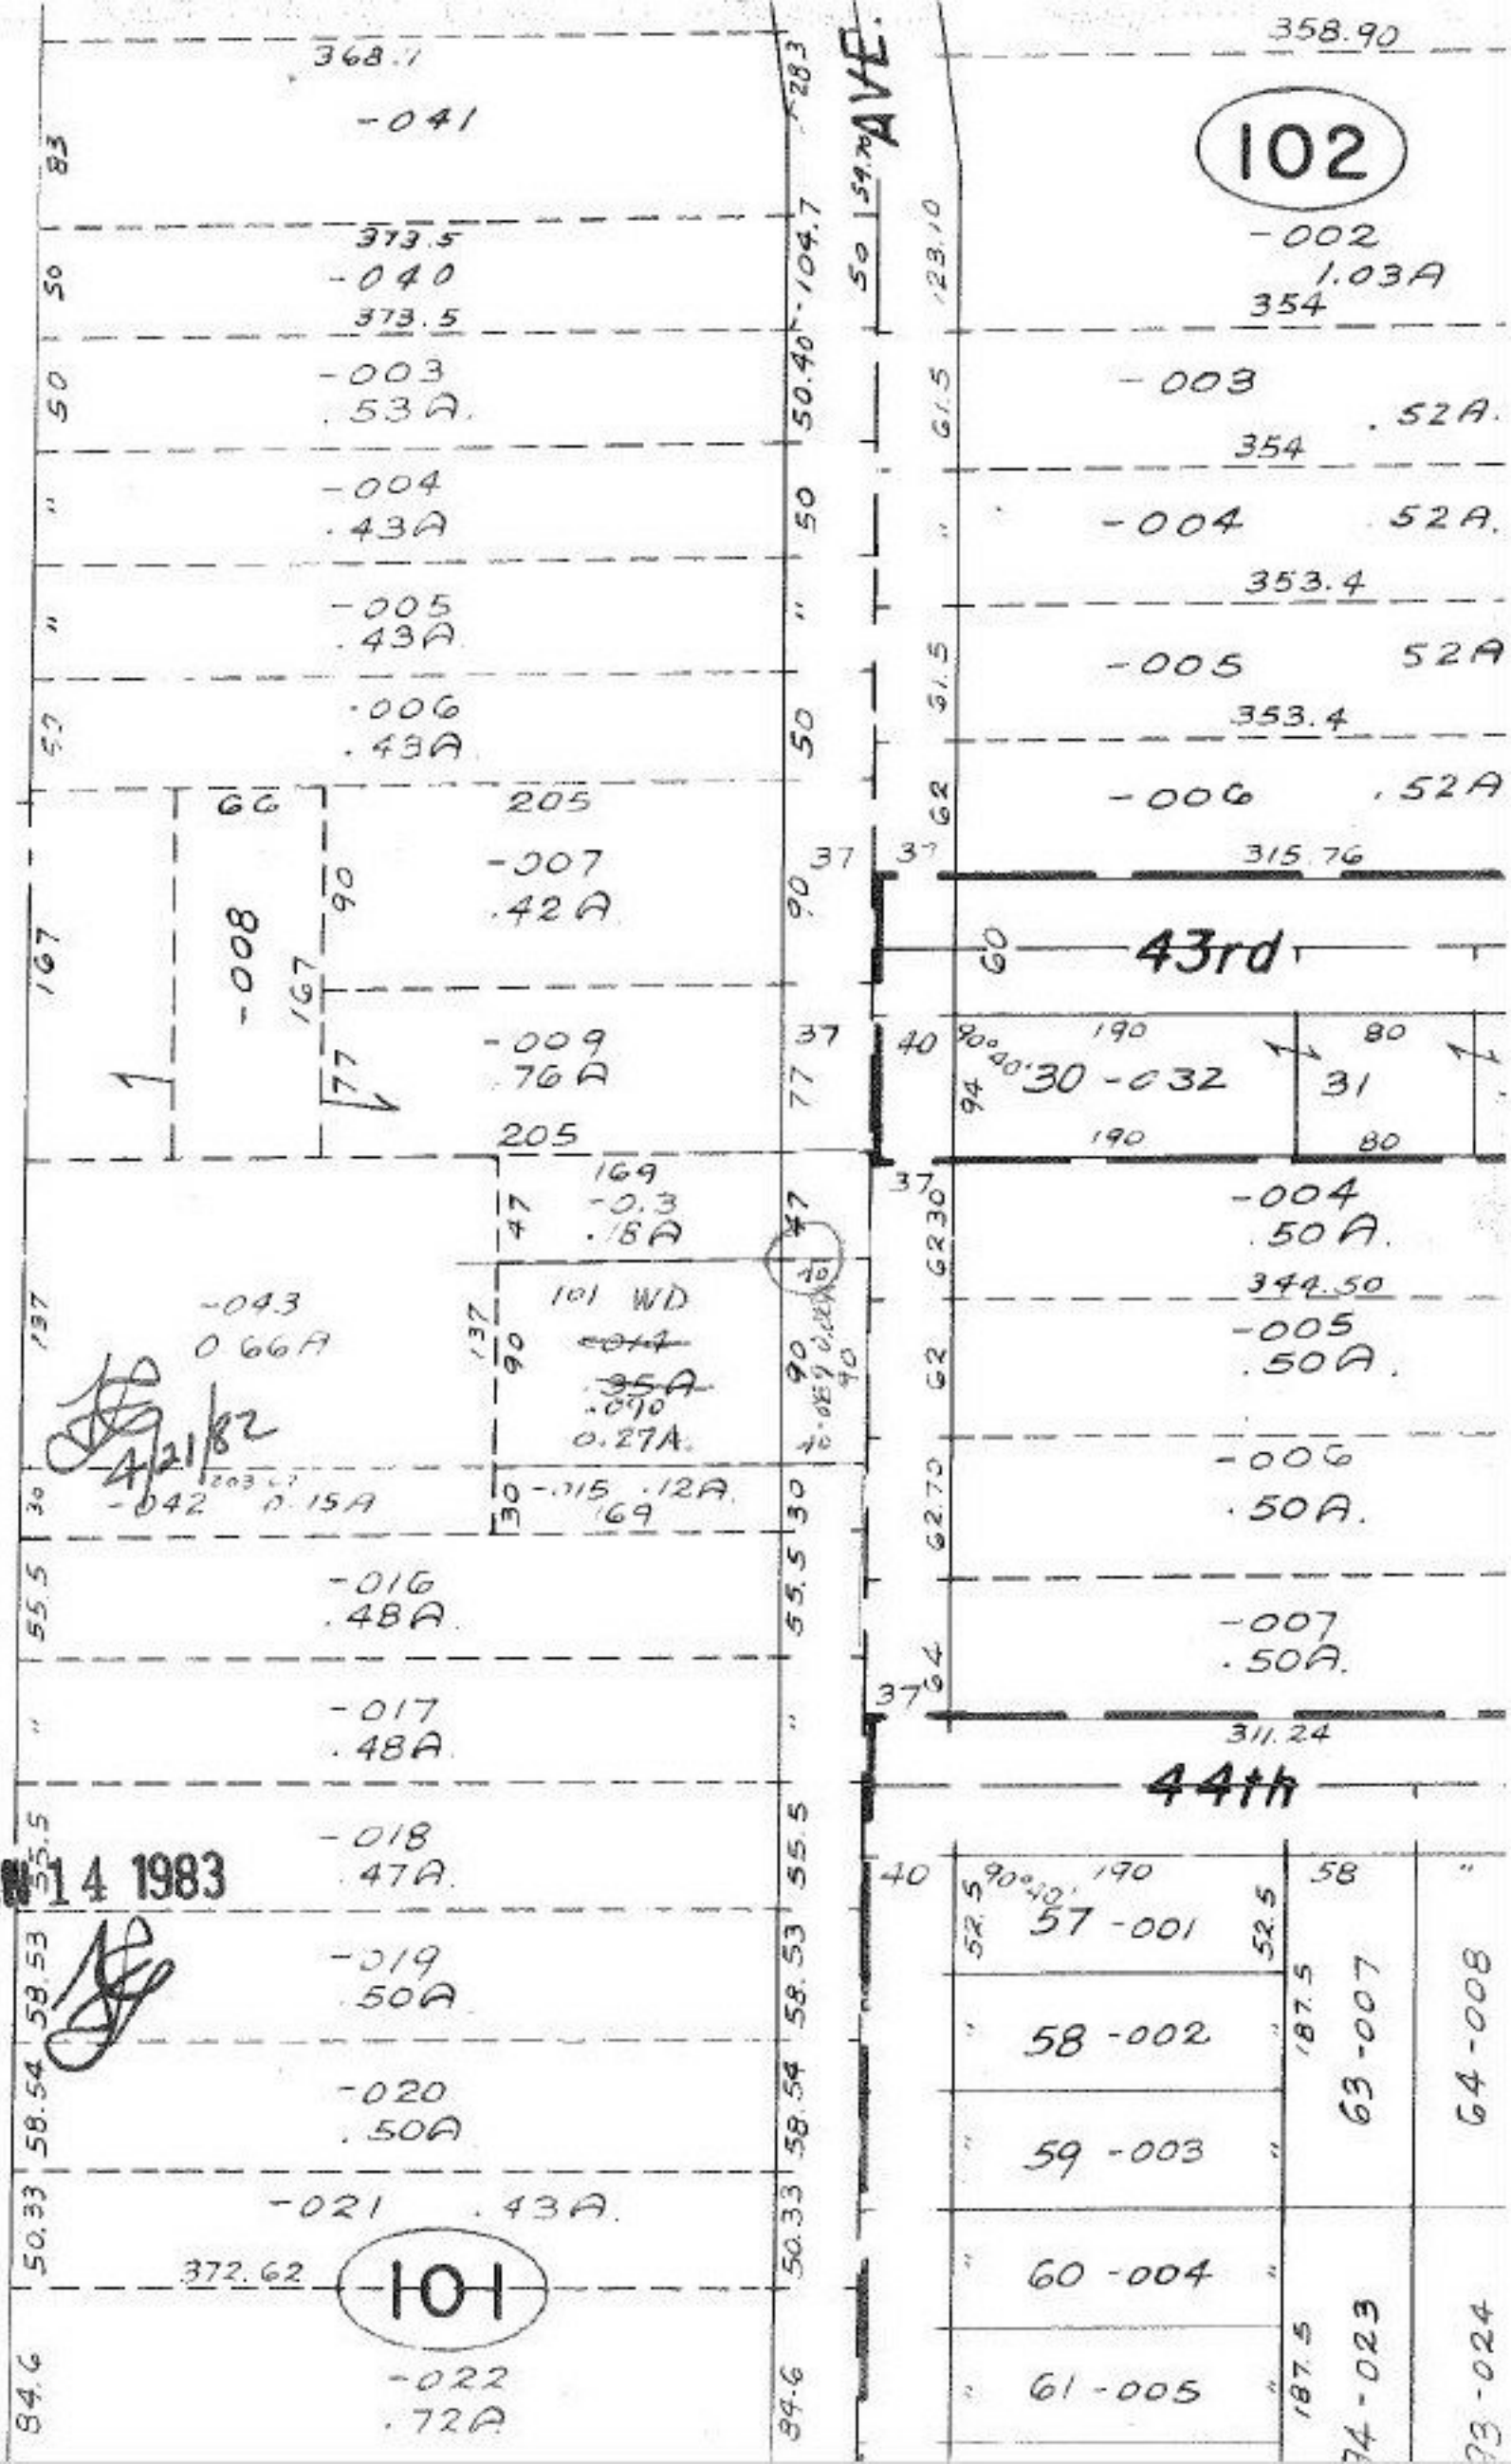

SEE 2-01-003-L

#14649

APPROVED
LORAIN CO.
MAP DEPT.

DATE 4-20-82

PAGE 3 00-108 A

BY T. McNair

VOID

JAN 14 1983

4/21/82