#14659

#14655

PARCEL SIZE CORRECTION

FRONTAGE & DEPTH

APPROVED
LORAIN CO.
MAP DEPT.
DATE 4-26-83
PAGE 5-00-012-A
BY T. McKain
VOID AFTER
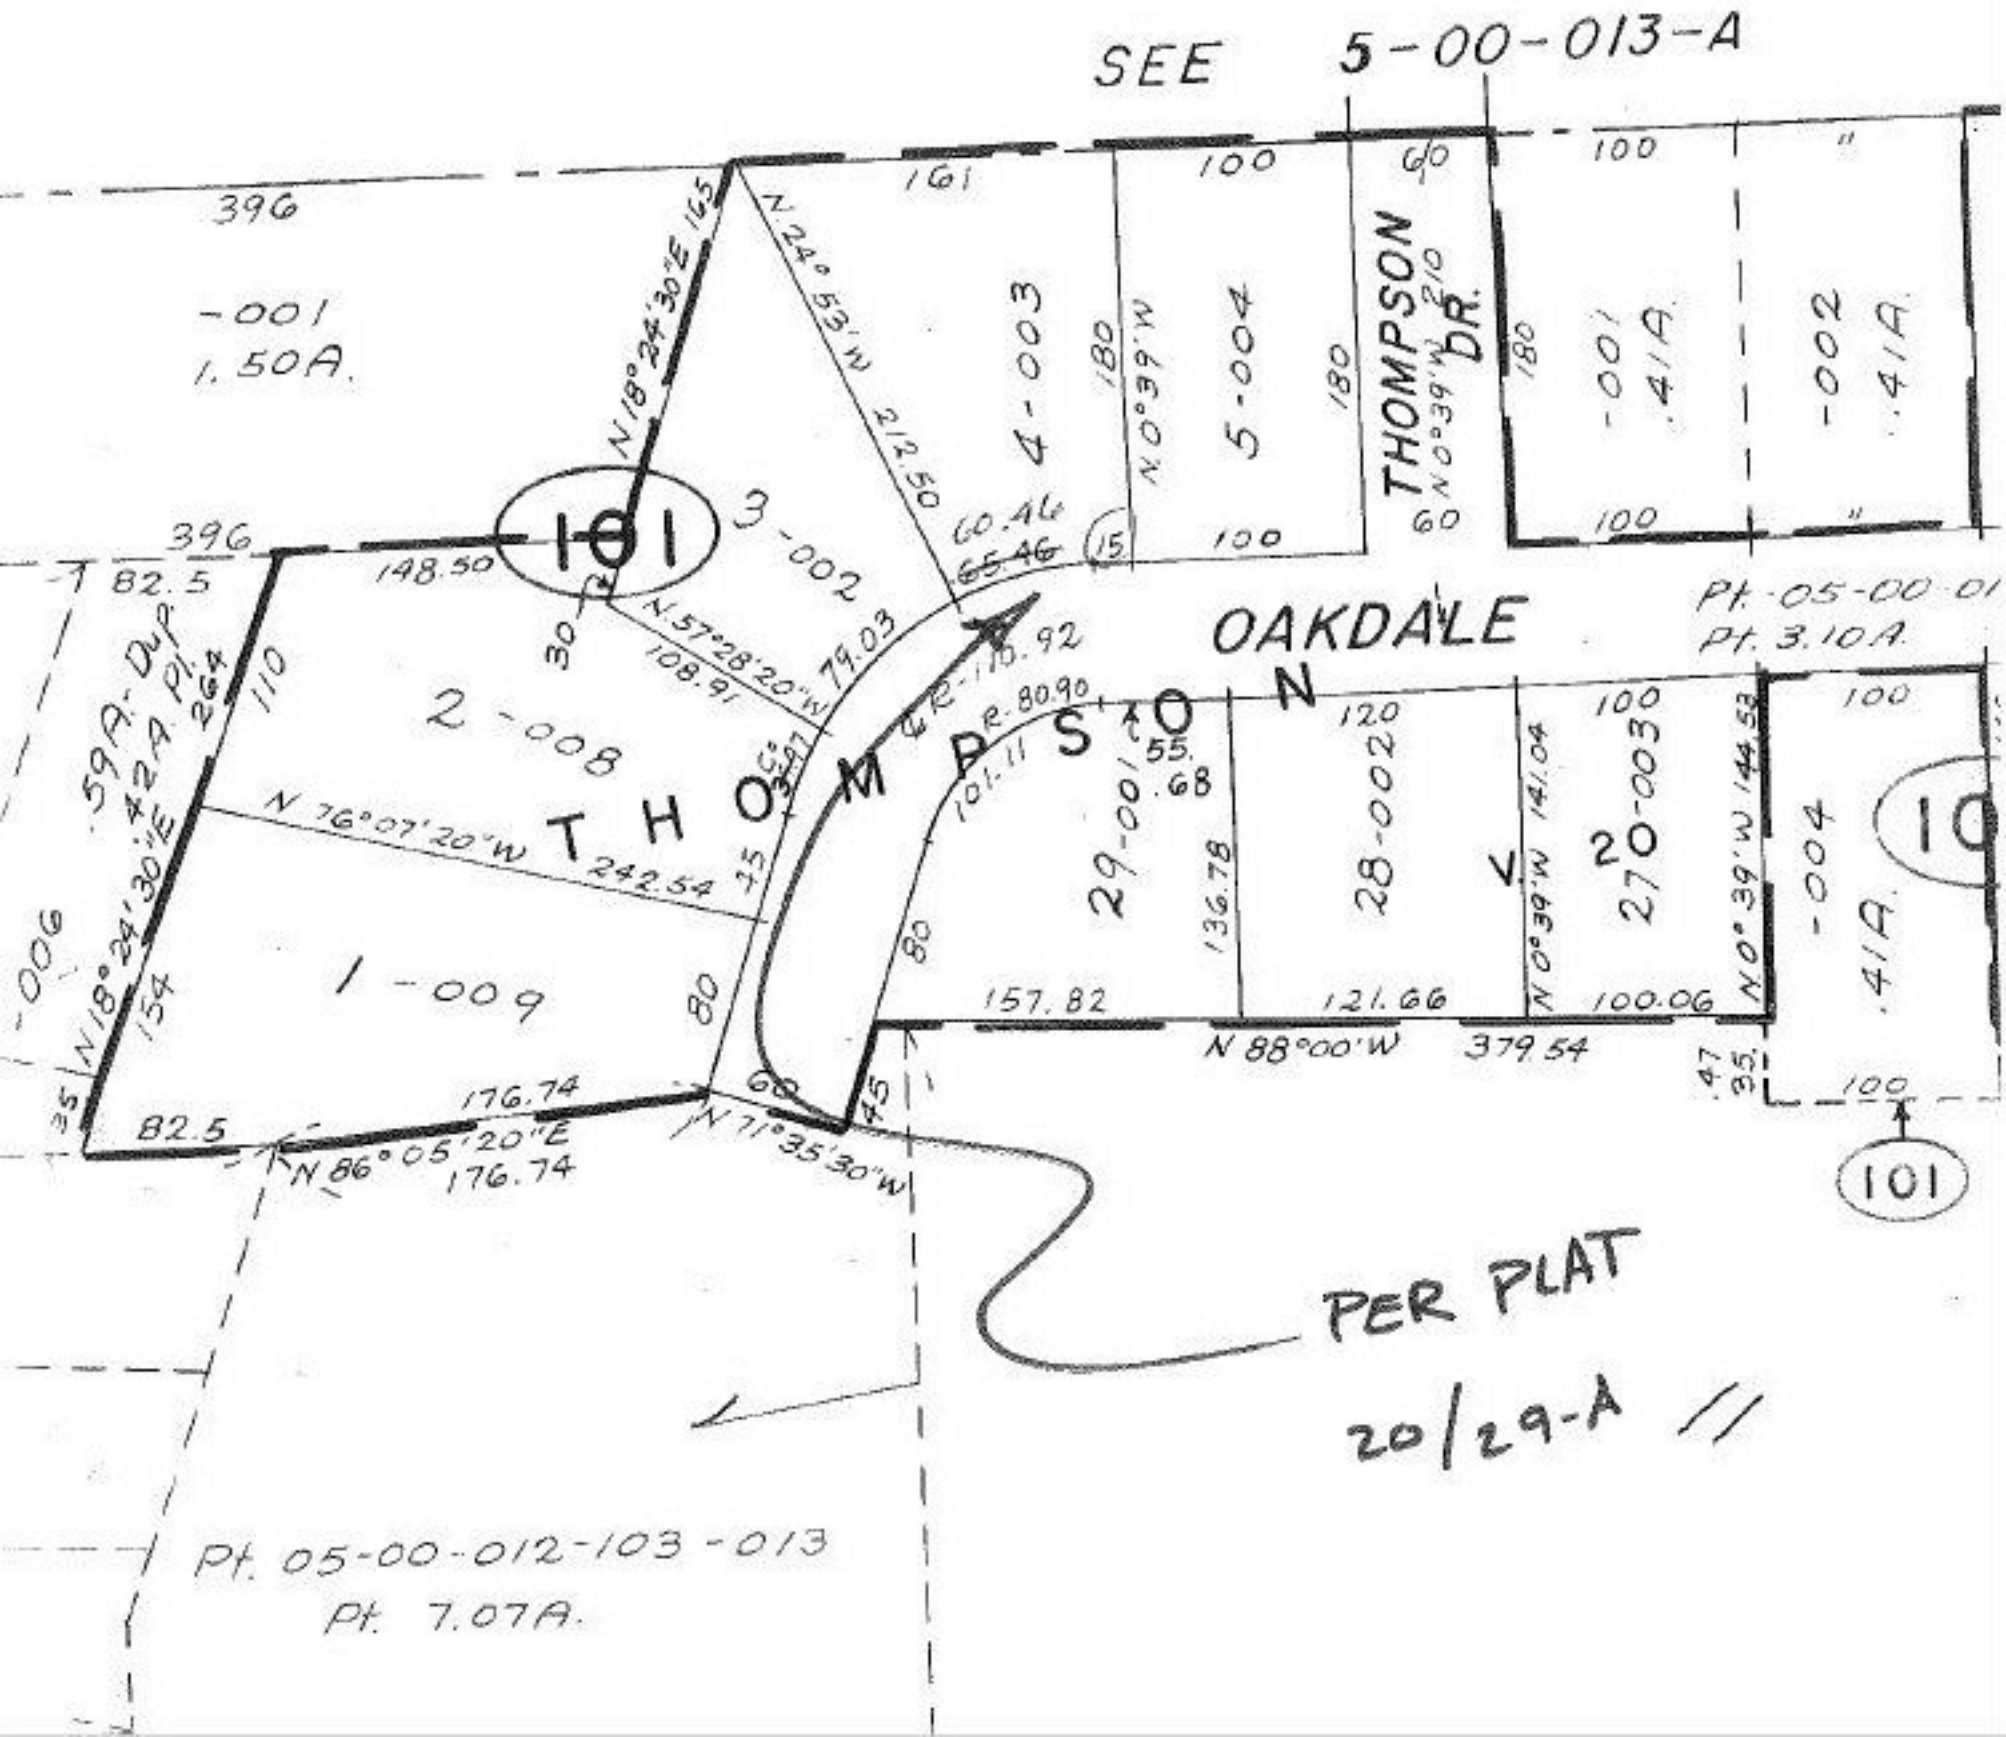
JAN 21 1983