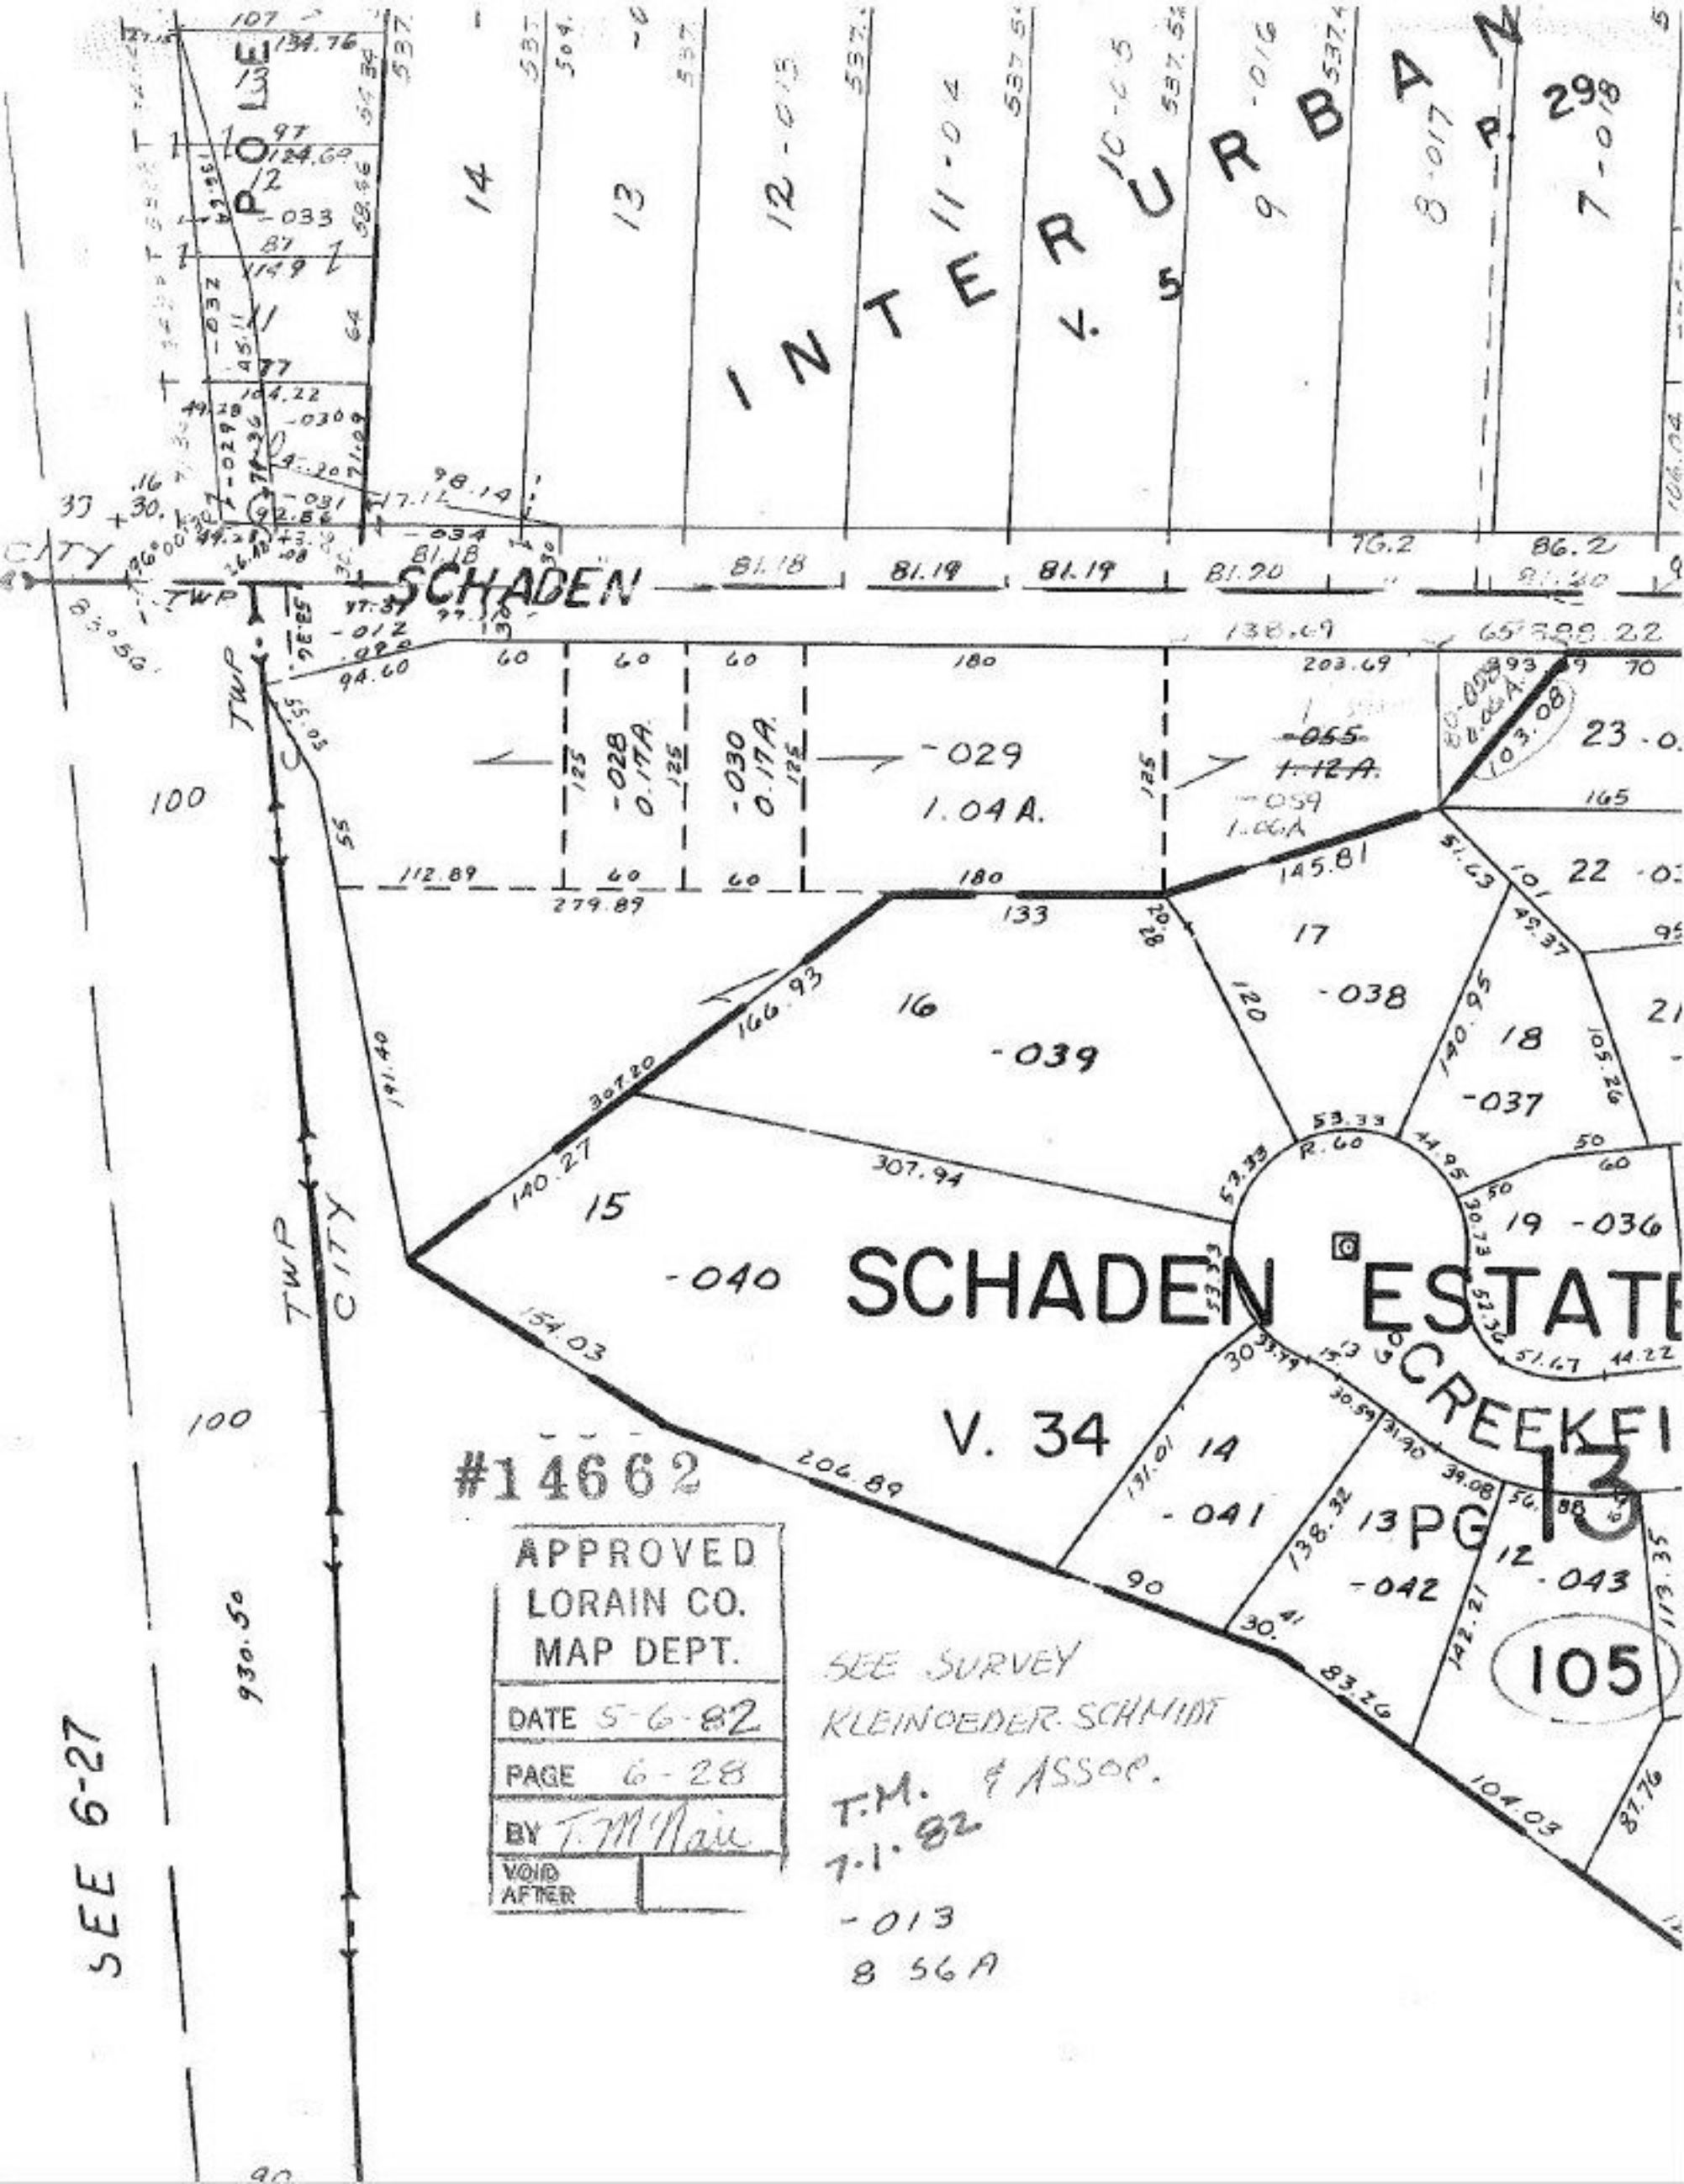

INTERURBAN
V. 5
P. 29
SCHADEN
SCHADEN ESTATE
V. 34
CREEKFI
PG 13
105
#14662
APPROVED
LORAIN CO.
MAP DEPT.
DATE 5-6-82
PAGE 6-28
BY T. McNair
VOID AFTER
SEE SURVEY
KLEINOEDER SCHMIDT
& ASSOC.
T.M.
7.1.82
-013
8 56A
SEE 6-27
CITY
TWP