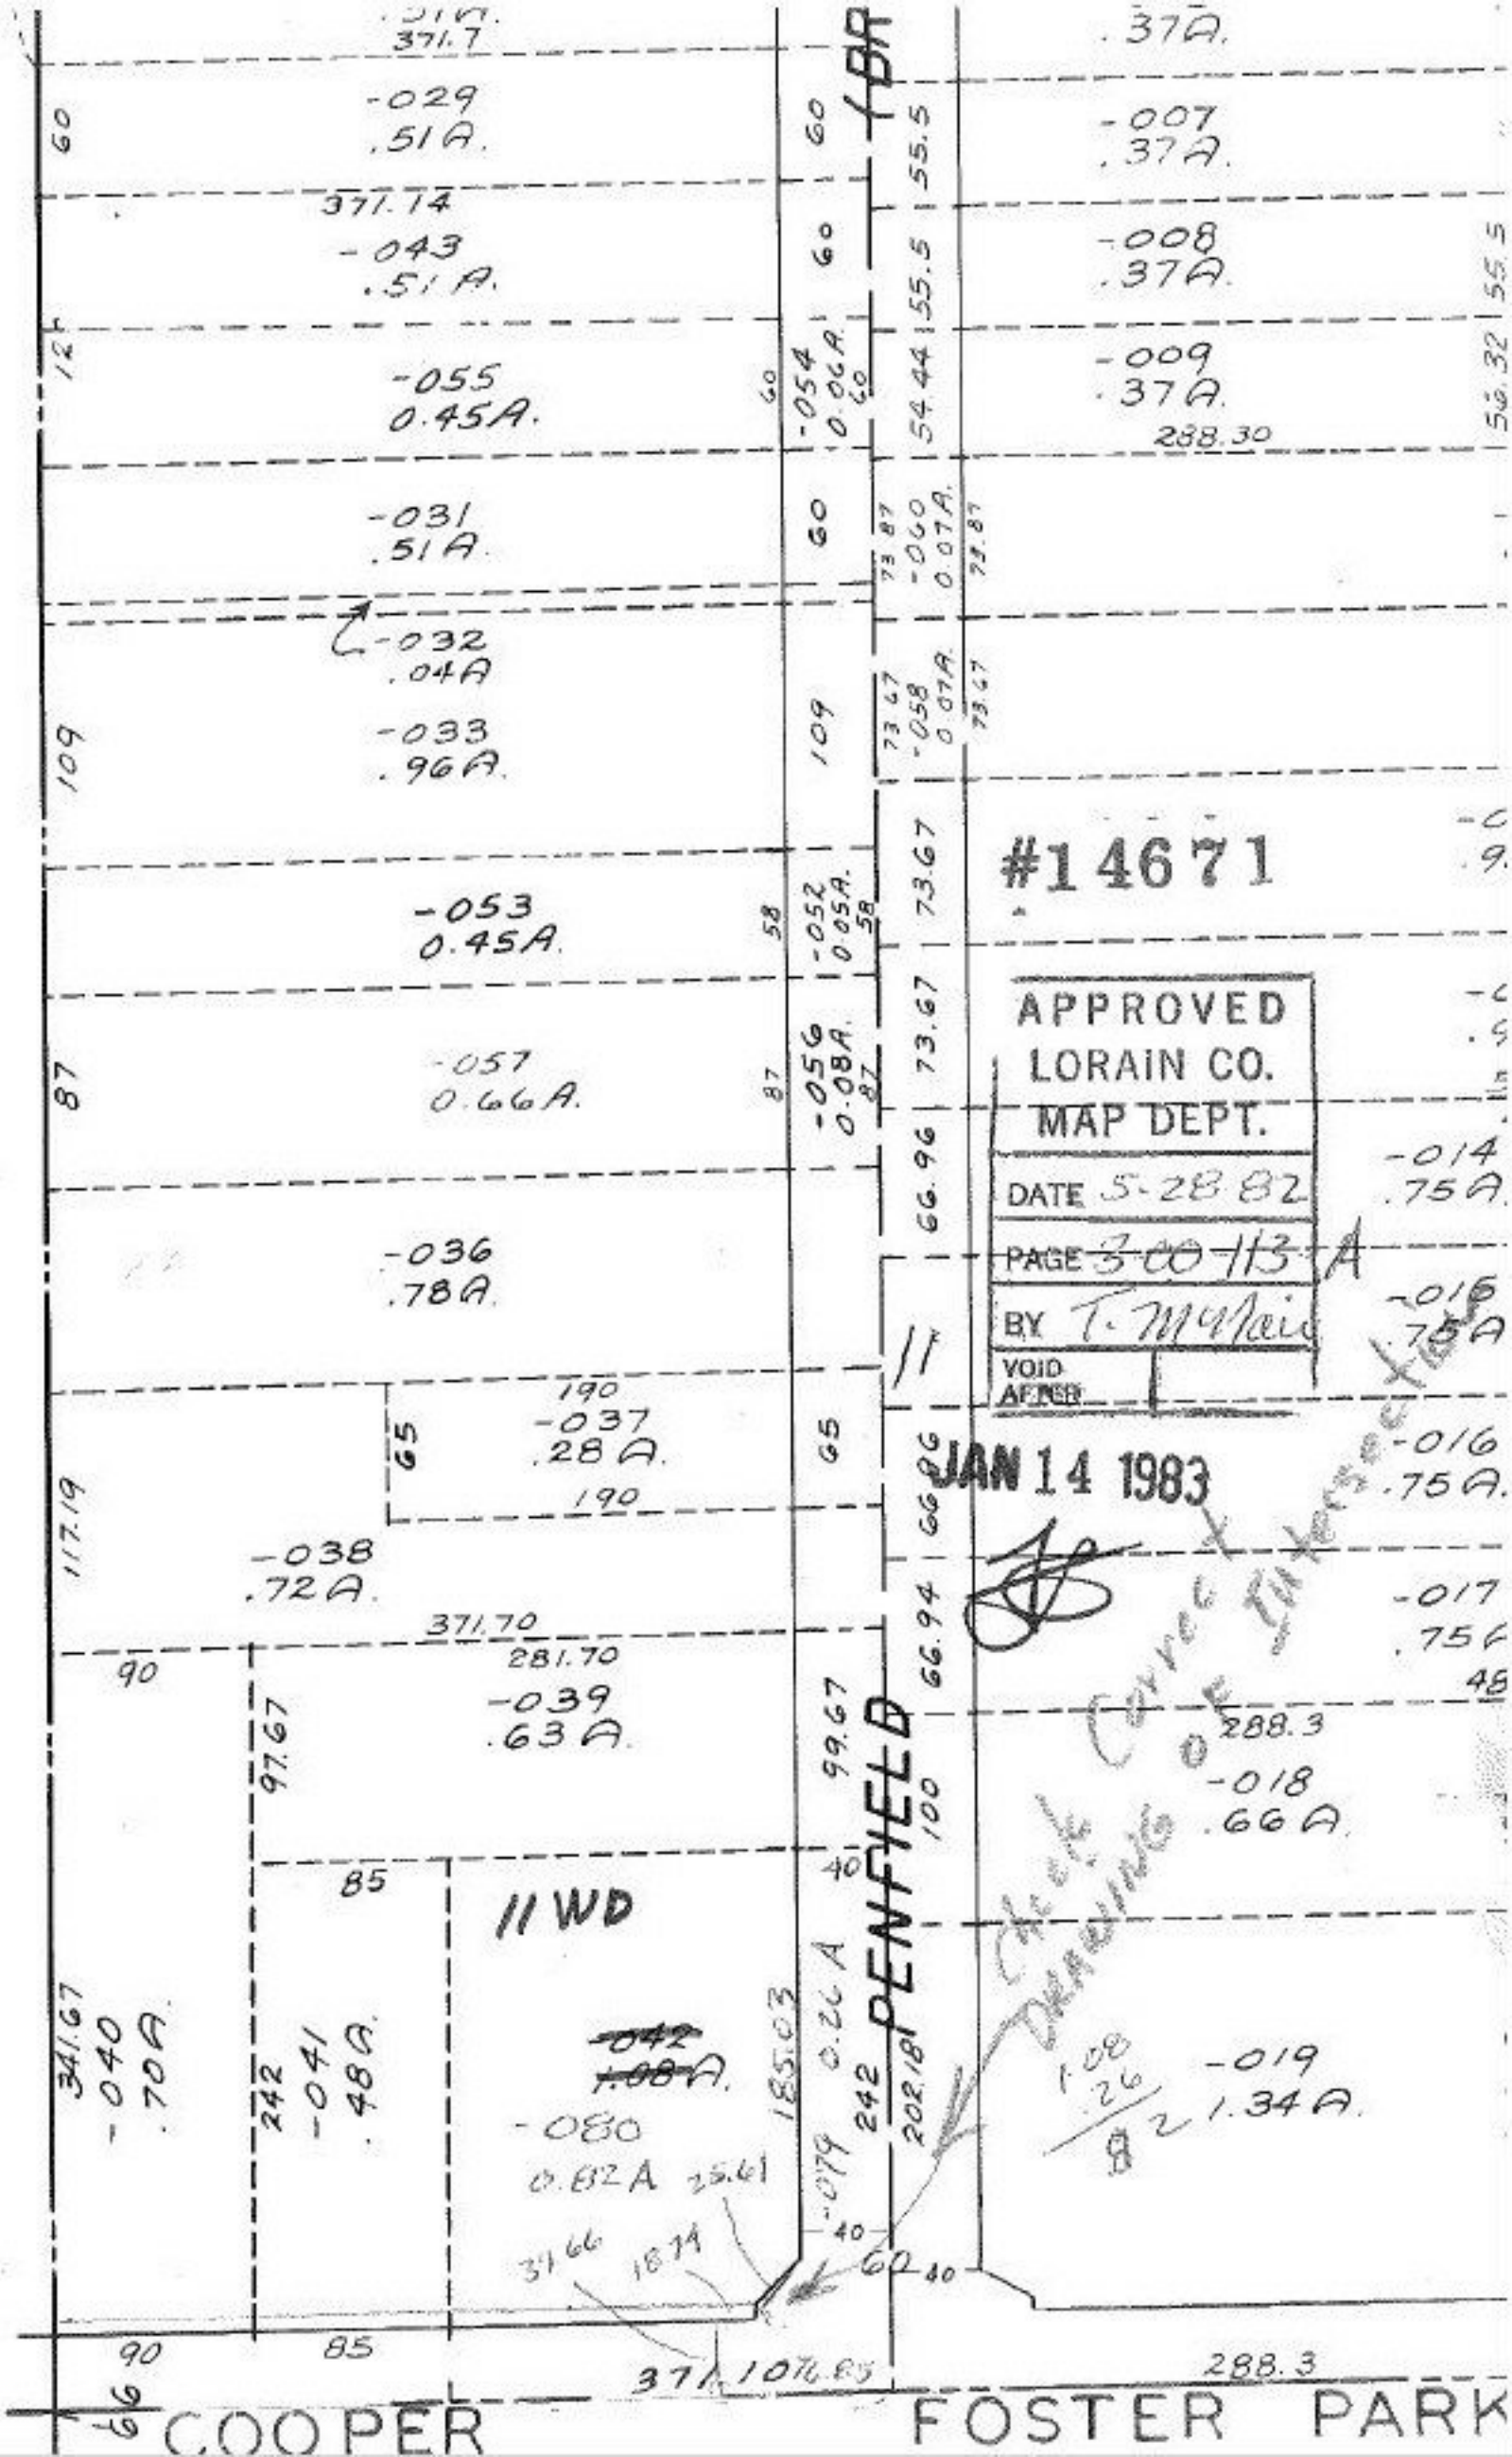

371.7
-029
.51A.
60
371.14
-043
.51A.
-055
0.45A.
-054
0.06A.
-031
.51A.
-032
.04A
-033
.96A.
109
-053
0.45A.
-052
0.05A.
-057
0.66A.
-056
0.08A.
-036
.78A.
190
-037
.28A.
65
117.19
-038
.72A.
371.70
281.70
-039
.63A.
90
97.67
85
11 WD
341.67
-040
.70A.
242
-041
.48A.
-042
1.08A.
-080
0.82A
25.61
37.66
18.74
185.03
0.26A
-079
242
202.18
PENFIELD
100
40
60
55.5
54.44
73.87
-060
0.07A.
73.67
-058
0.07A.
66.96
66.94
99.67
.37A.
-007
.37A.
-008
.37A.
-009
.37A.
288.30
#14671
APPROVED
LORAIN CO.
MAP DEPT.
DATE 5-28-82
PAGE 3-00-113-A
BY T. McNair
VOID AFTER
JAN 14 1983
-014
.75A.
-016
.75A.
-017
.75A.
288.3
-018
.66A.
-019
1.34A.
1.08
.26
82
288.3
Check Correct Drawing of Intersection
COOPER
FOSTER PARK