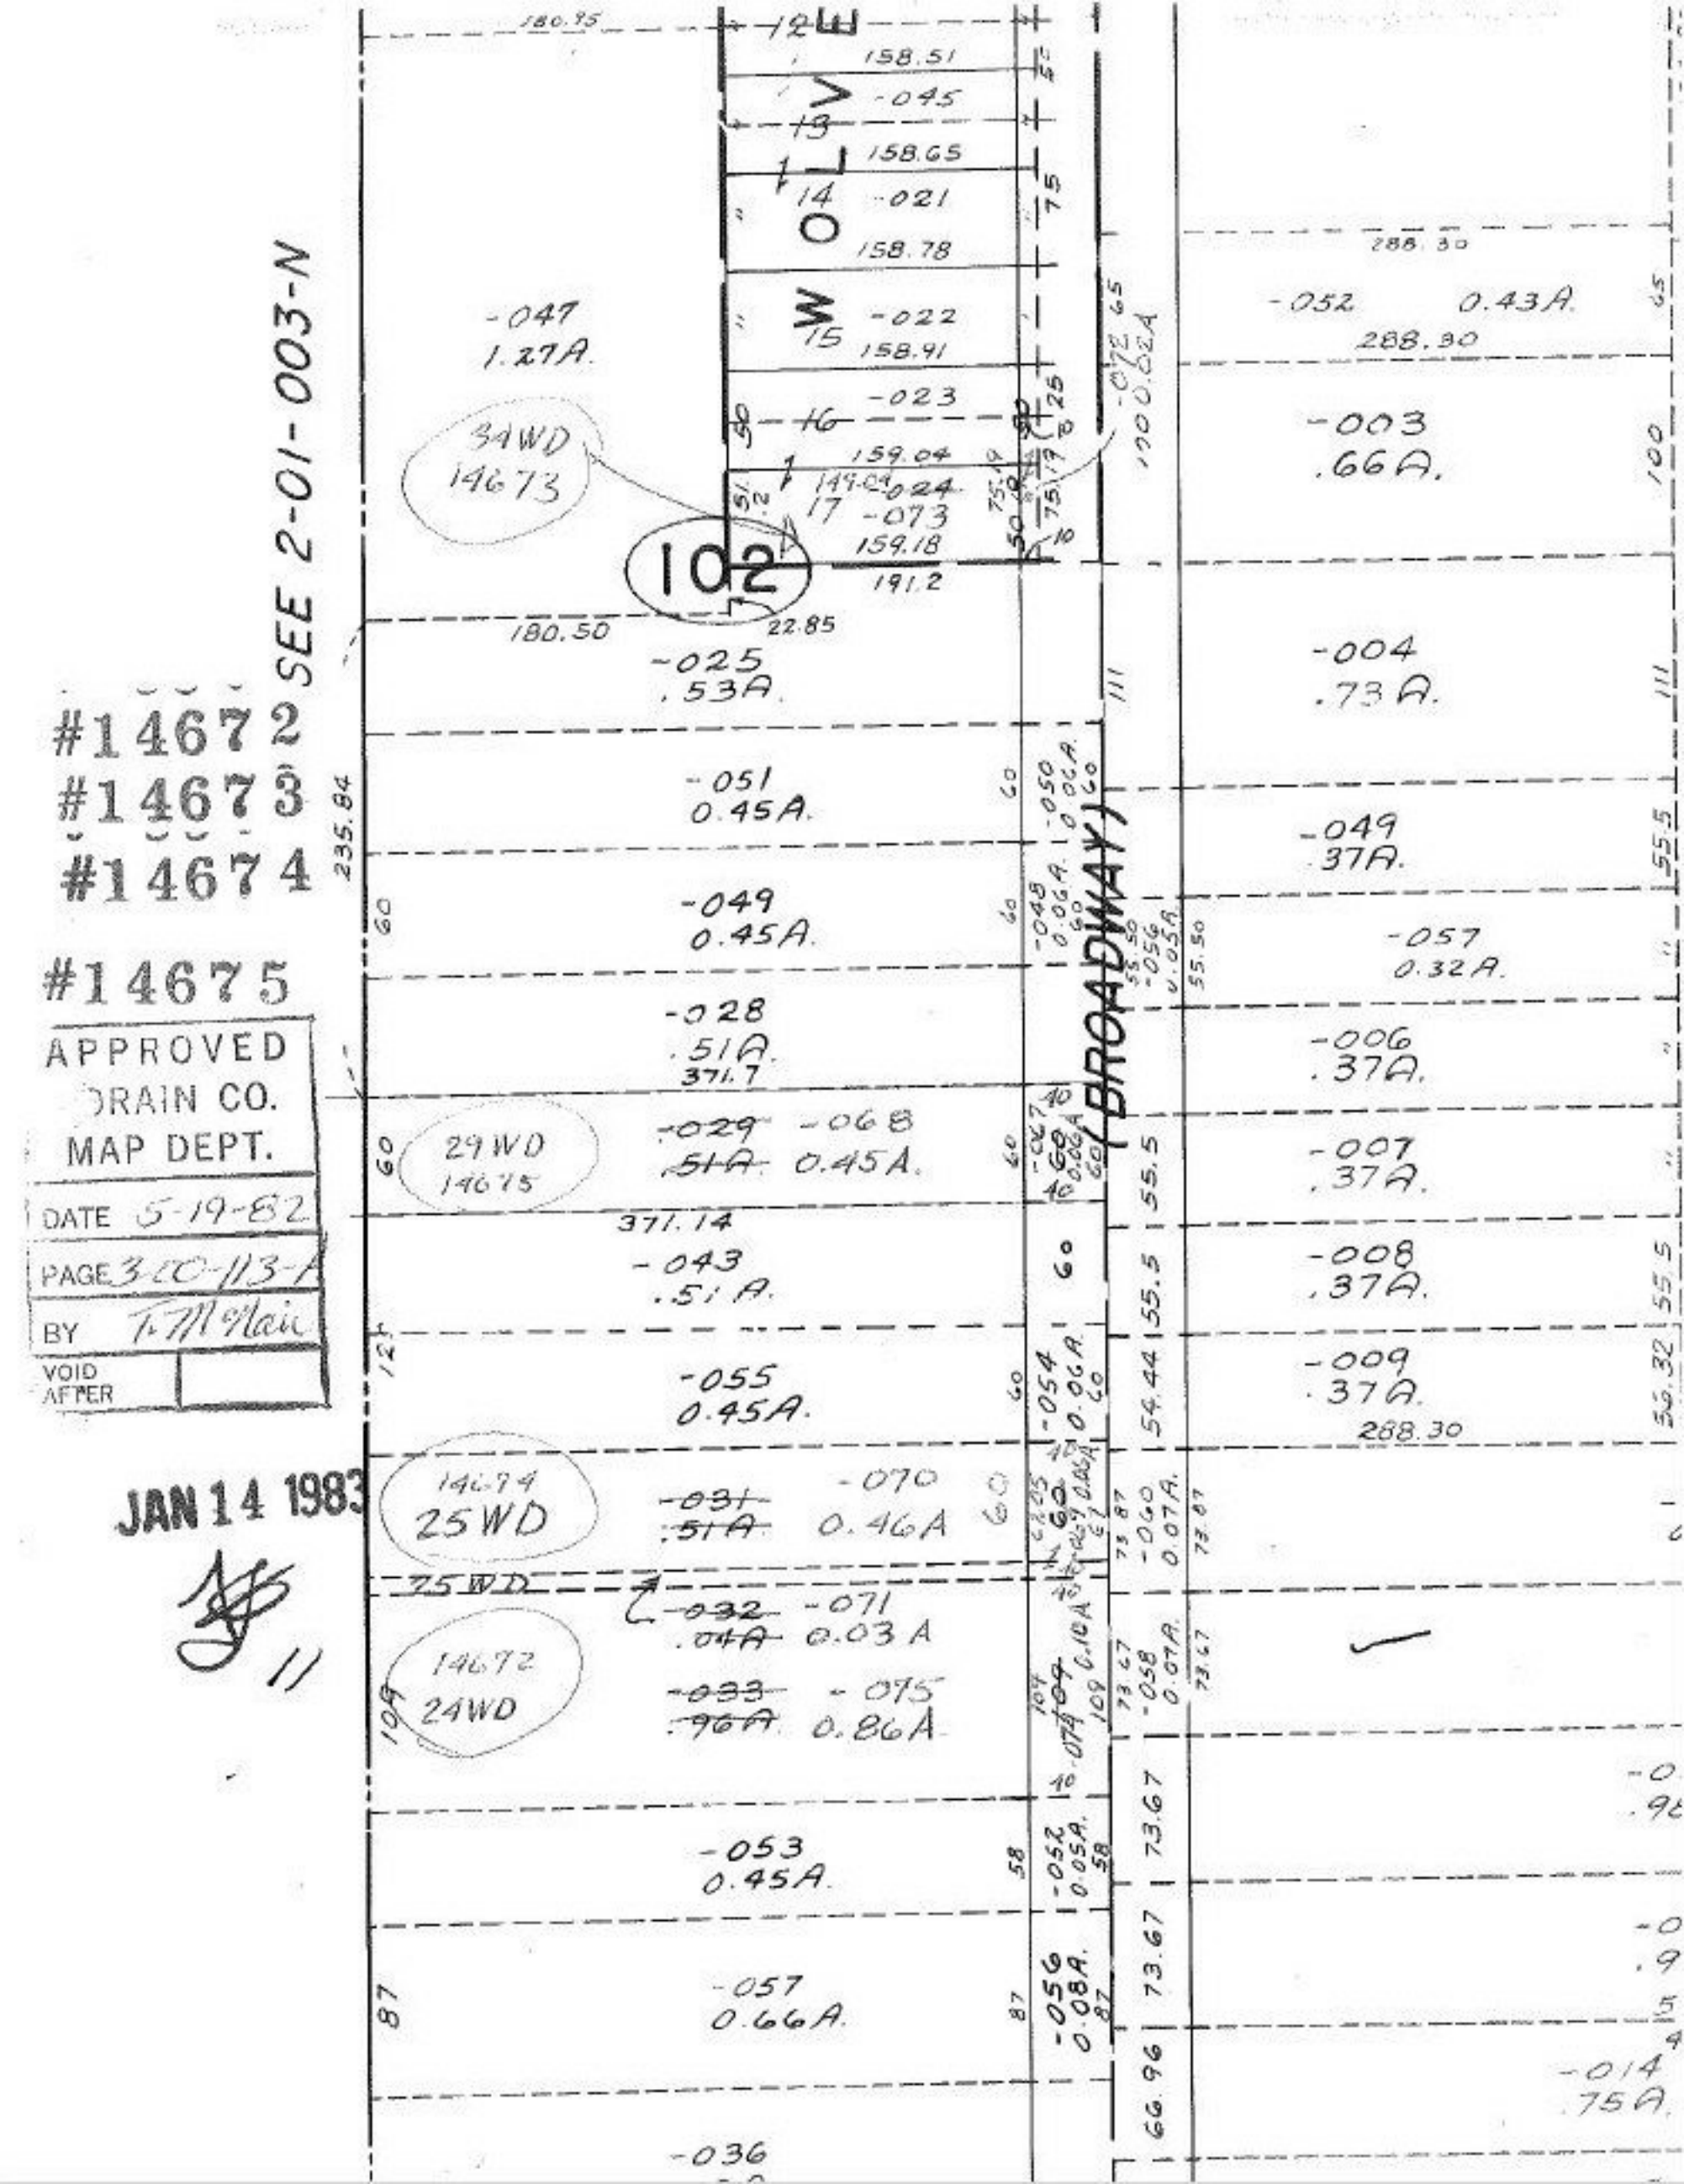

SEE 2-01-003-N
#14672
#14673
#14674
#14675
APPROVED
DRAIN CO.
MAP DEPT.
DATE 5-19-82
PAGE 3-00-113-A
BY T. McNair
VOID AFTER
JAN 14 1983
11
WOLVE
(BROADWAY)
102
34WD 14673
29WD 14675
14674 25WD
14672 24WD
-047 1.27A.
-025 .53A.
-051 0.45A.
-049 0.45A.
-028 .51A.
-029 .51A. -068 0.45A.
-043 .51A.
-055 0.45A.
-031 .51A. -070 0.46A
-032 .04A. -071 0.03A
-033 .96A. -075 0.86A
-053 0.45A.
-057 0.66A.
-036
-052 0.43A.
-003 .66A.
-004 .73A.
-049 .37A.
-057 0.32A.
-006 .37A.
-007 .37A.
-008 .37A.
-009 .37A.
-014 .75A.