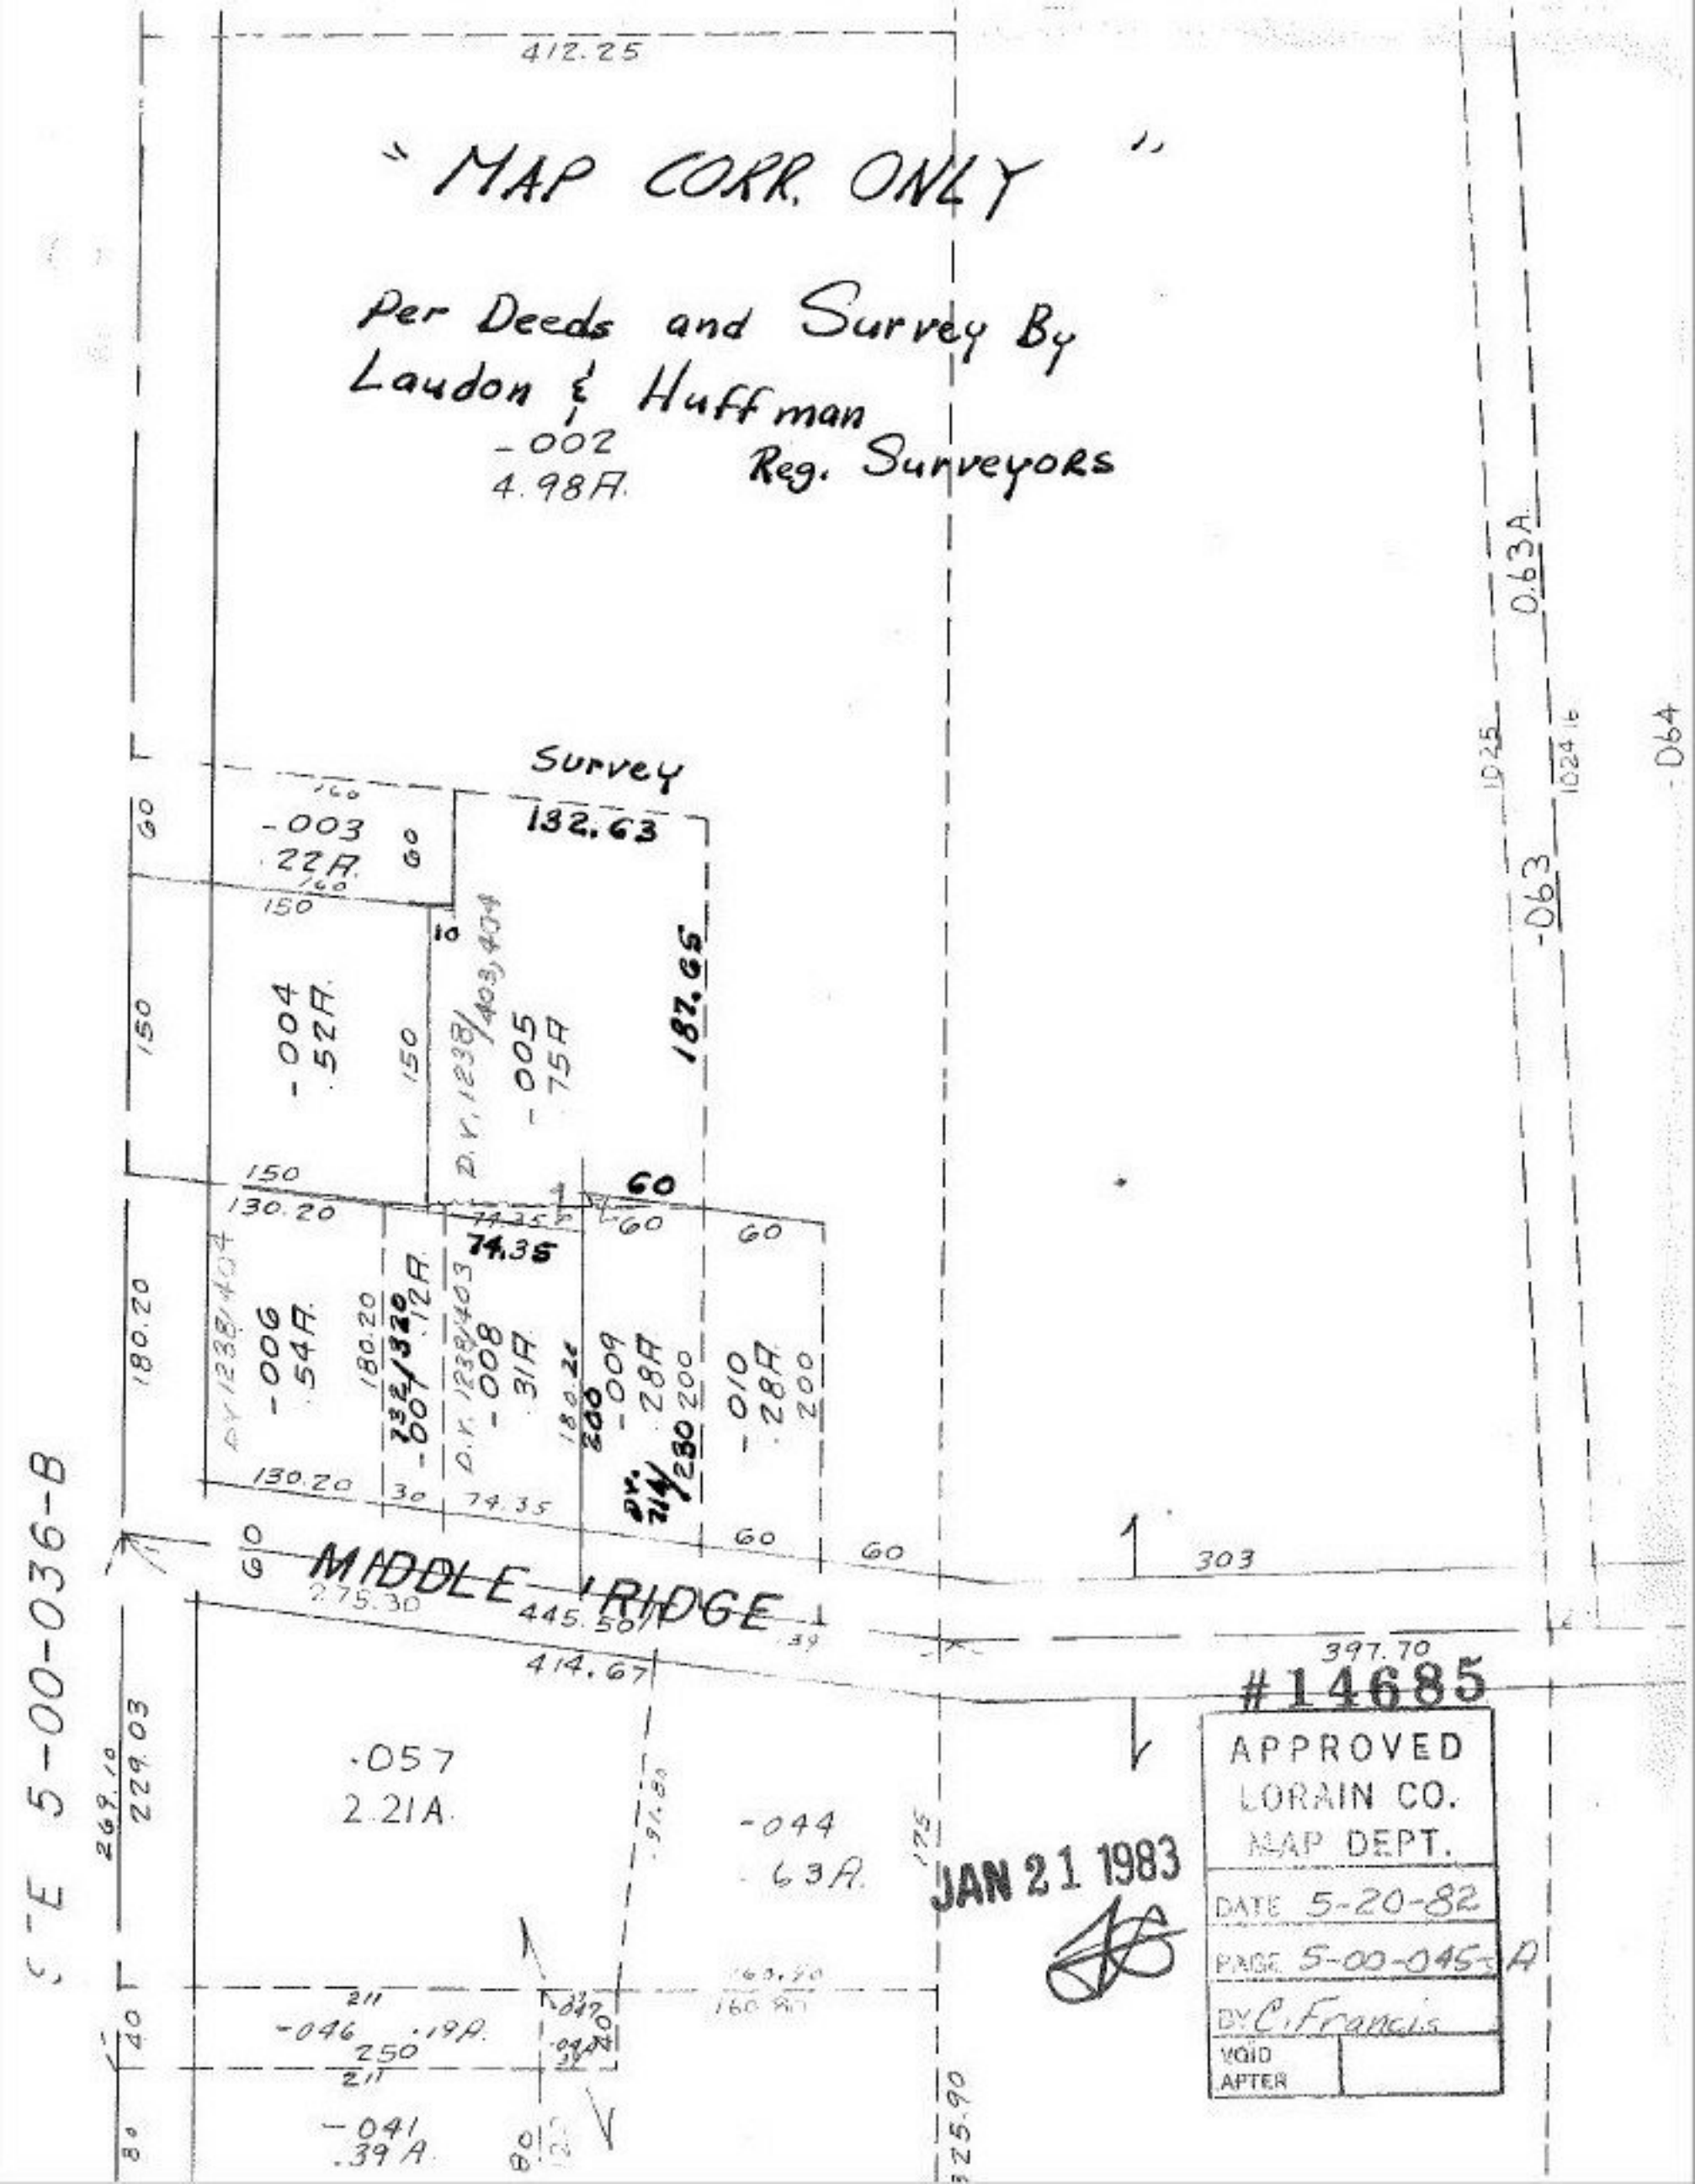

"MAP CORR. ONLY"
Per Deeds and Survey By
Laudon & Huffman
Reg. Surveyors
-002
4.98A.
412.25
Survey
132.63
-003
.22A.
-004
.52A.
-005
.75A
187.65
D.V. 1238/403, 404
-006
.54A.
-007
.12A.
-008
.31A.
-009
.28A
-010
.28A
74.35
130.20
180.20
MIDDLE RIDGE
275.30
445.50
414.67
397.70
303
-057
2.21A.
-044
.63A.
-046
.19A.
-041
.39A.
0.63A.
-063
-064
#14685
APPROVED
LORAIN CO.
MAP DEPT.
DATE 5-20-82
PAGE 5-00-045-A
BY C. Francis
VOID
AFTER
JAN 21 1983
5-00-036-B