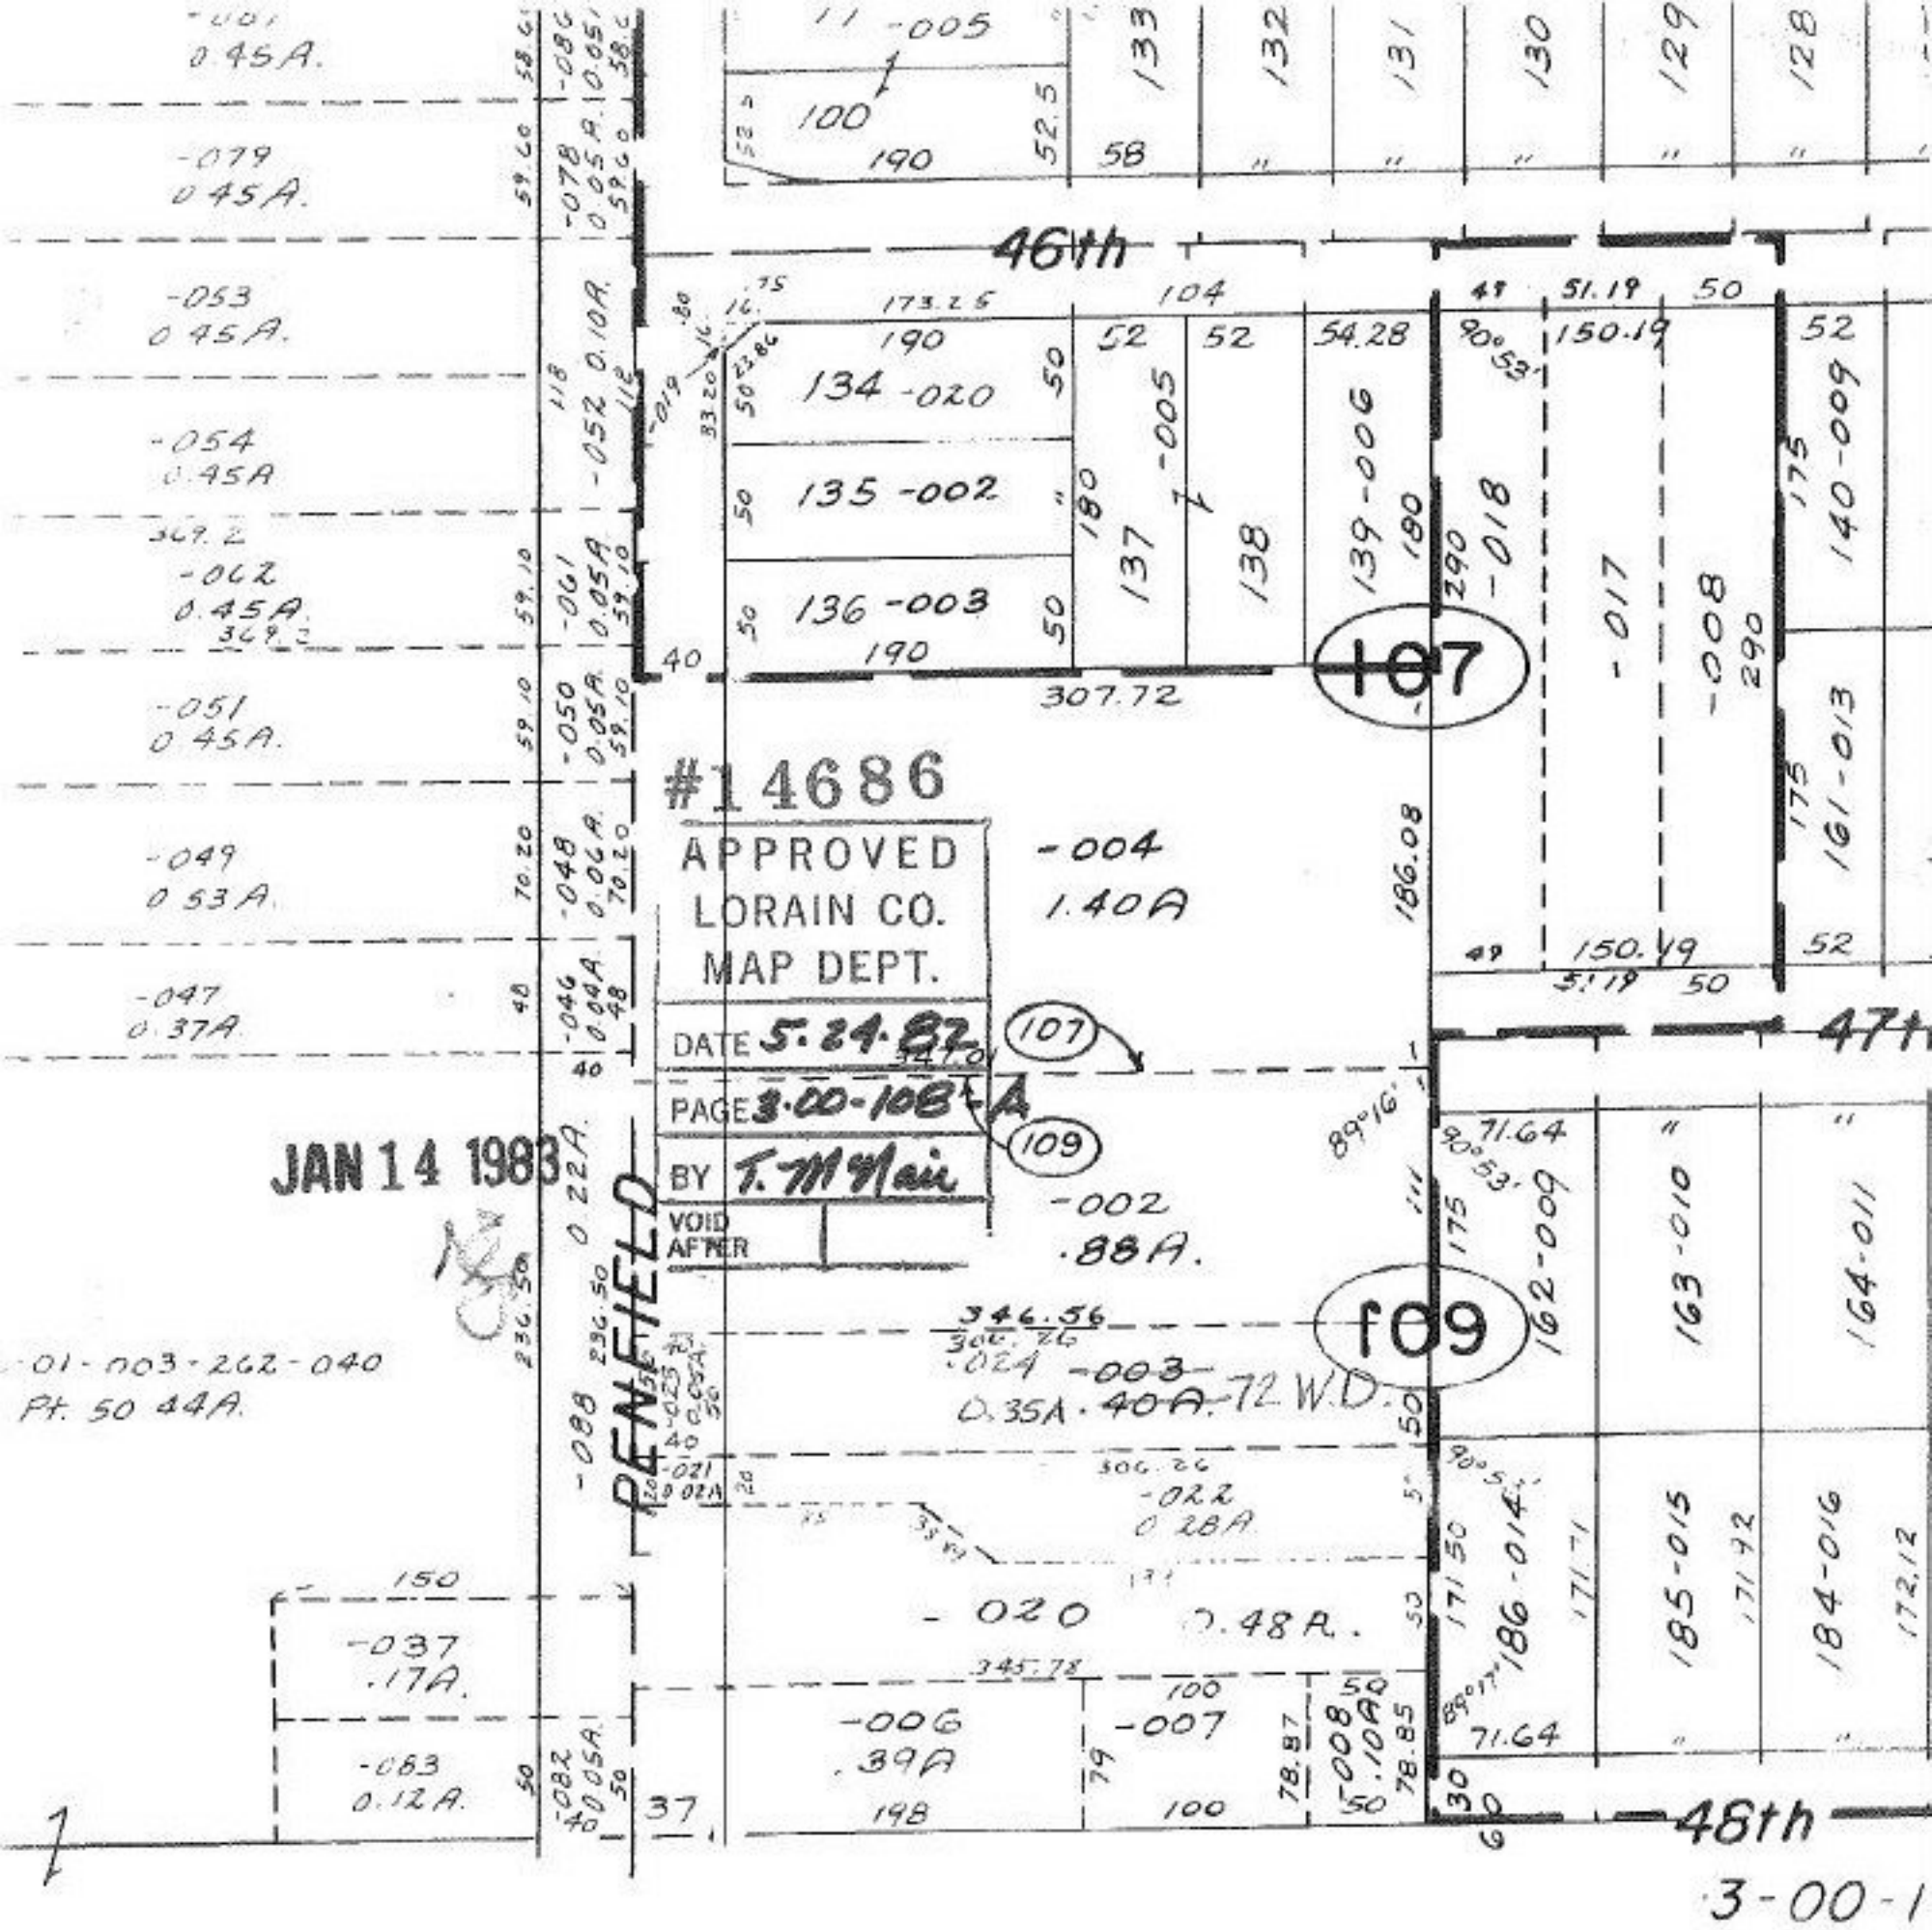

SHEFFIELD TWP.

SCALE: 1" = 100'

A