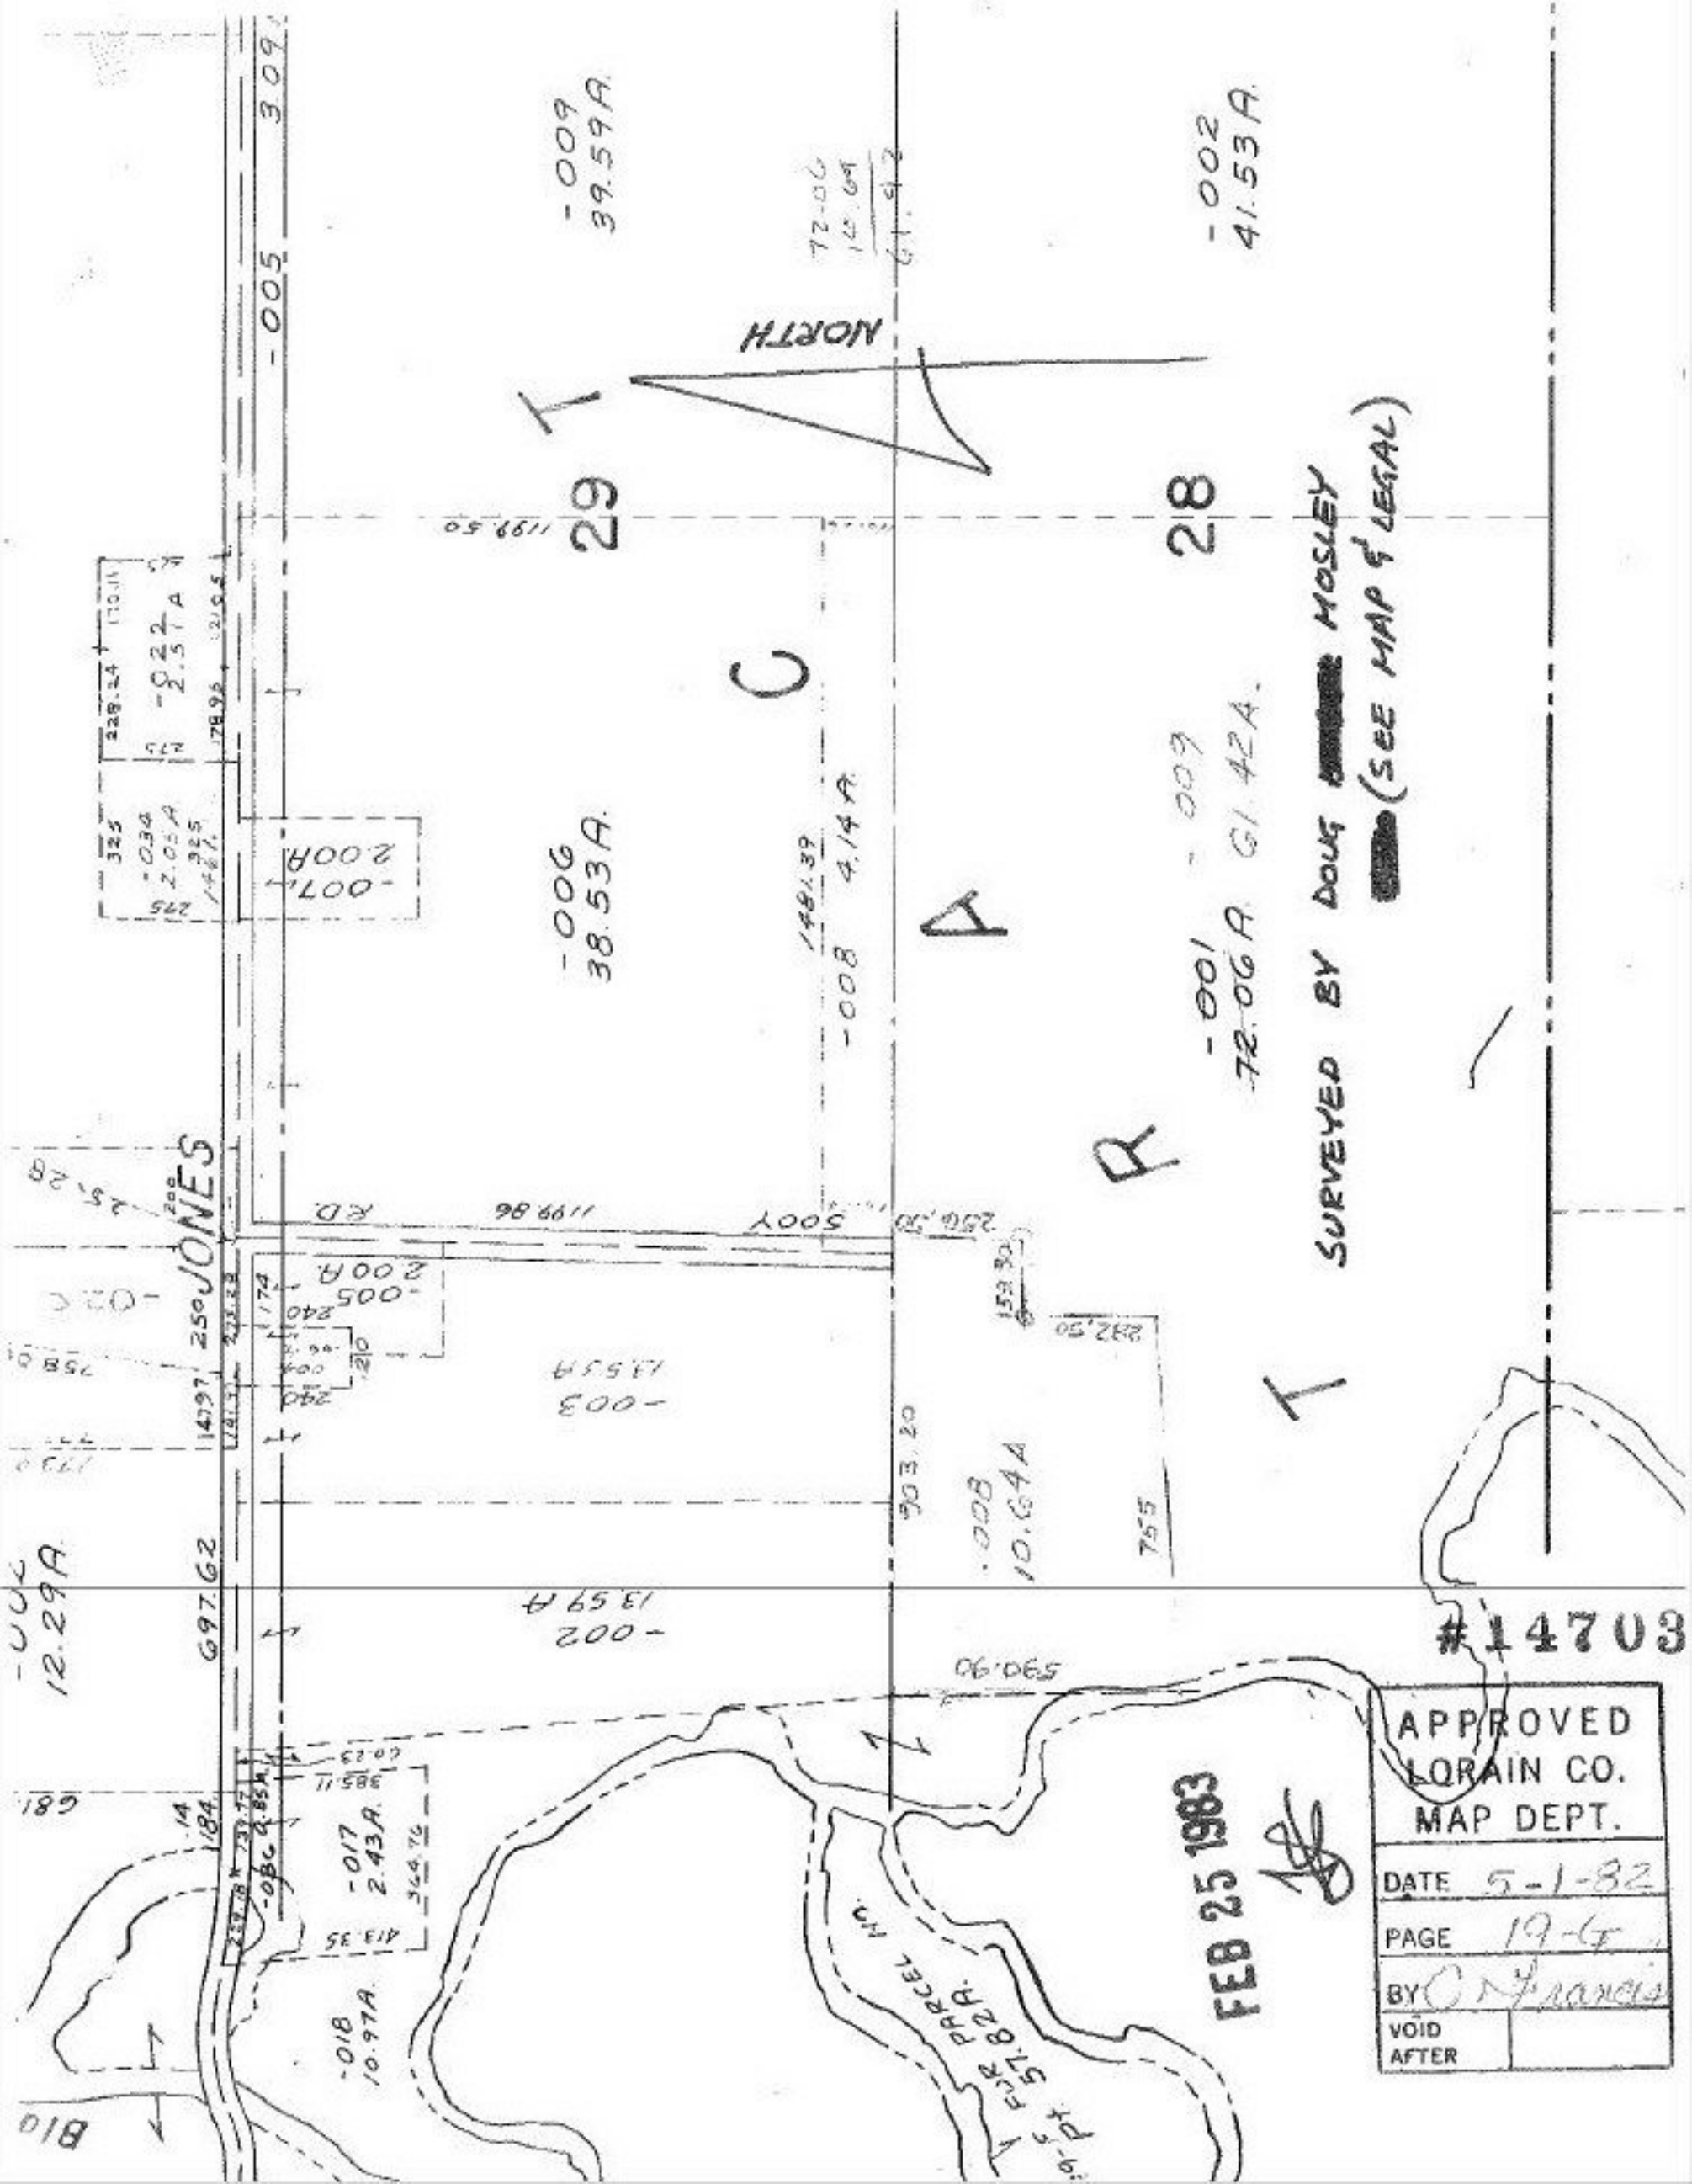

NORTH
29
28
C
A
R
T
T
JONES
SURVEYED BY DOUG [redacted] MOSLEY
[redacted] (SEE MAP & LEGAL)
-009 39.59A
-002 41.53A
-006 38.53A
-001 72.06A
-009 61.42A
-008 4.14A
-005 2.00A
-007 2.00A
-003 13.53A
-008 10.64A
-002 13.59A
-017 2.43A
-018 10.97A
-022 2.51A
-034 2.05A
-005 3.09
697.62
12.29A
#14703
APPROVED
LORAIN CO.
MAP DEPT.
DATE 5-1-82
PAGE 19-G
BY C. Francis
VOID AFTER
FEB 25 1983