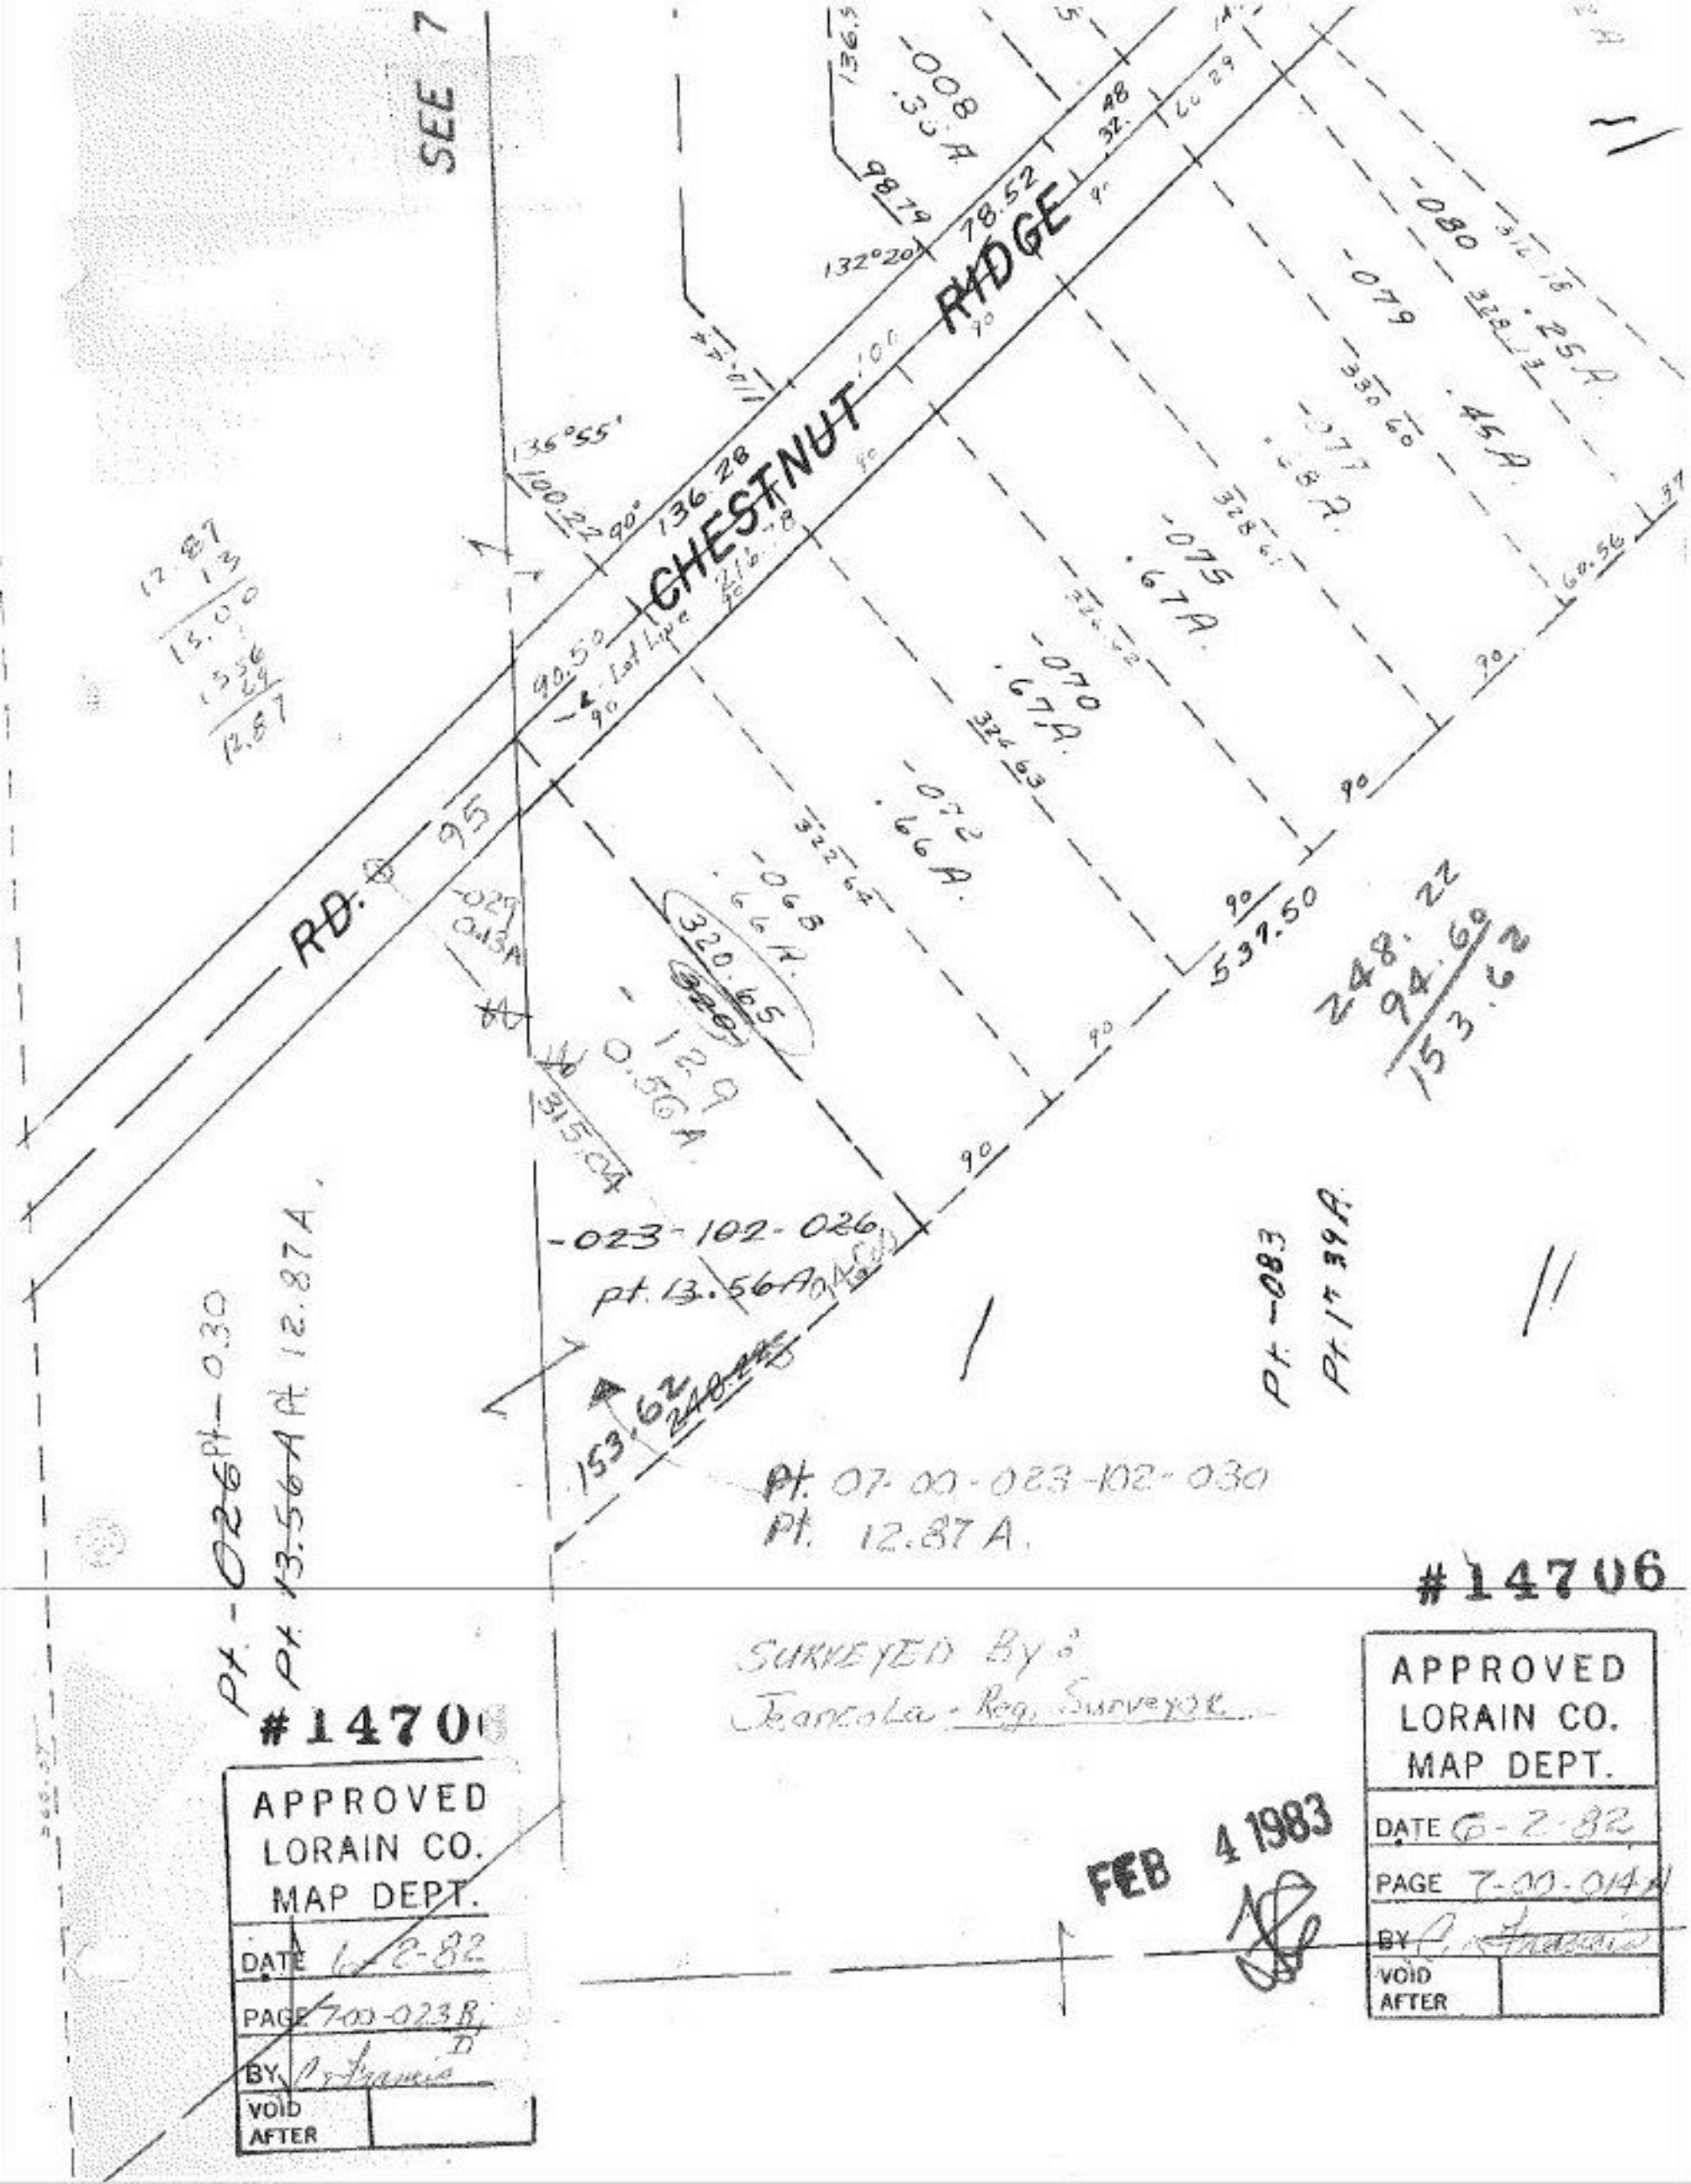
SEE 7
CHESTNUT RIDGE
RD. 95
136.28
78.52
132°20'
135°55'
100.22
90.50
Lot Line
-008 .30 A.
-080 .25 A.
-079 .45 A.
-077 .68 A.
-075 .67 A.
-070 .67 A.
-072 .66 A.
-068 .66 A.
320.65
-129 0.56 A.
315.04
537.50
248.22
94.60
153.62
-029 0.13 A
-023-102-026
pt. 13.56 A
Pt. -083
Pt. 17.39 A.
Pt. 07-00-023-102-030
Pt. 12.87 A.
Pt. -026 Pt. -030
Pt. 13.56 A Pt. 12.87 A.
12.87
13
13.00
13.56
12.87
#14706
SURVEYED By:
Jeancola - Reg. Surveyor
FEB 4 1983
APPROVED
LORAIN CO.
MAP DEPT.
DATE 6-2-82
PAGE 7-00-014 A
BY C. Francis
VOID AFTER
#14706
APPROVED
LORAIN CO.
MAP DEPT.
DATE 6-2-82
PAGE 7-00-023 B, D
BY C. Francis
VOID AFTER