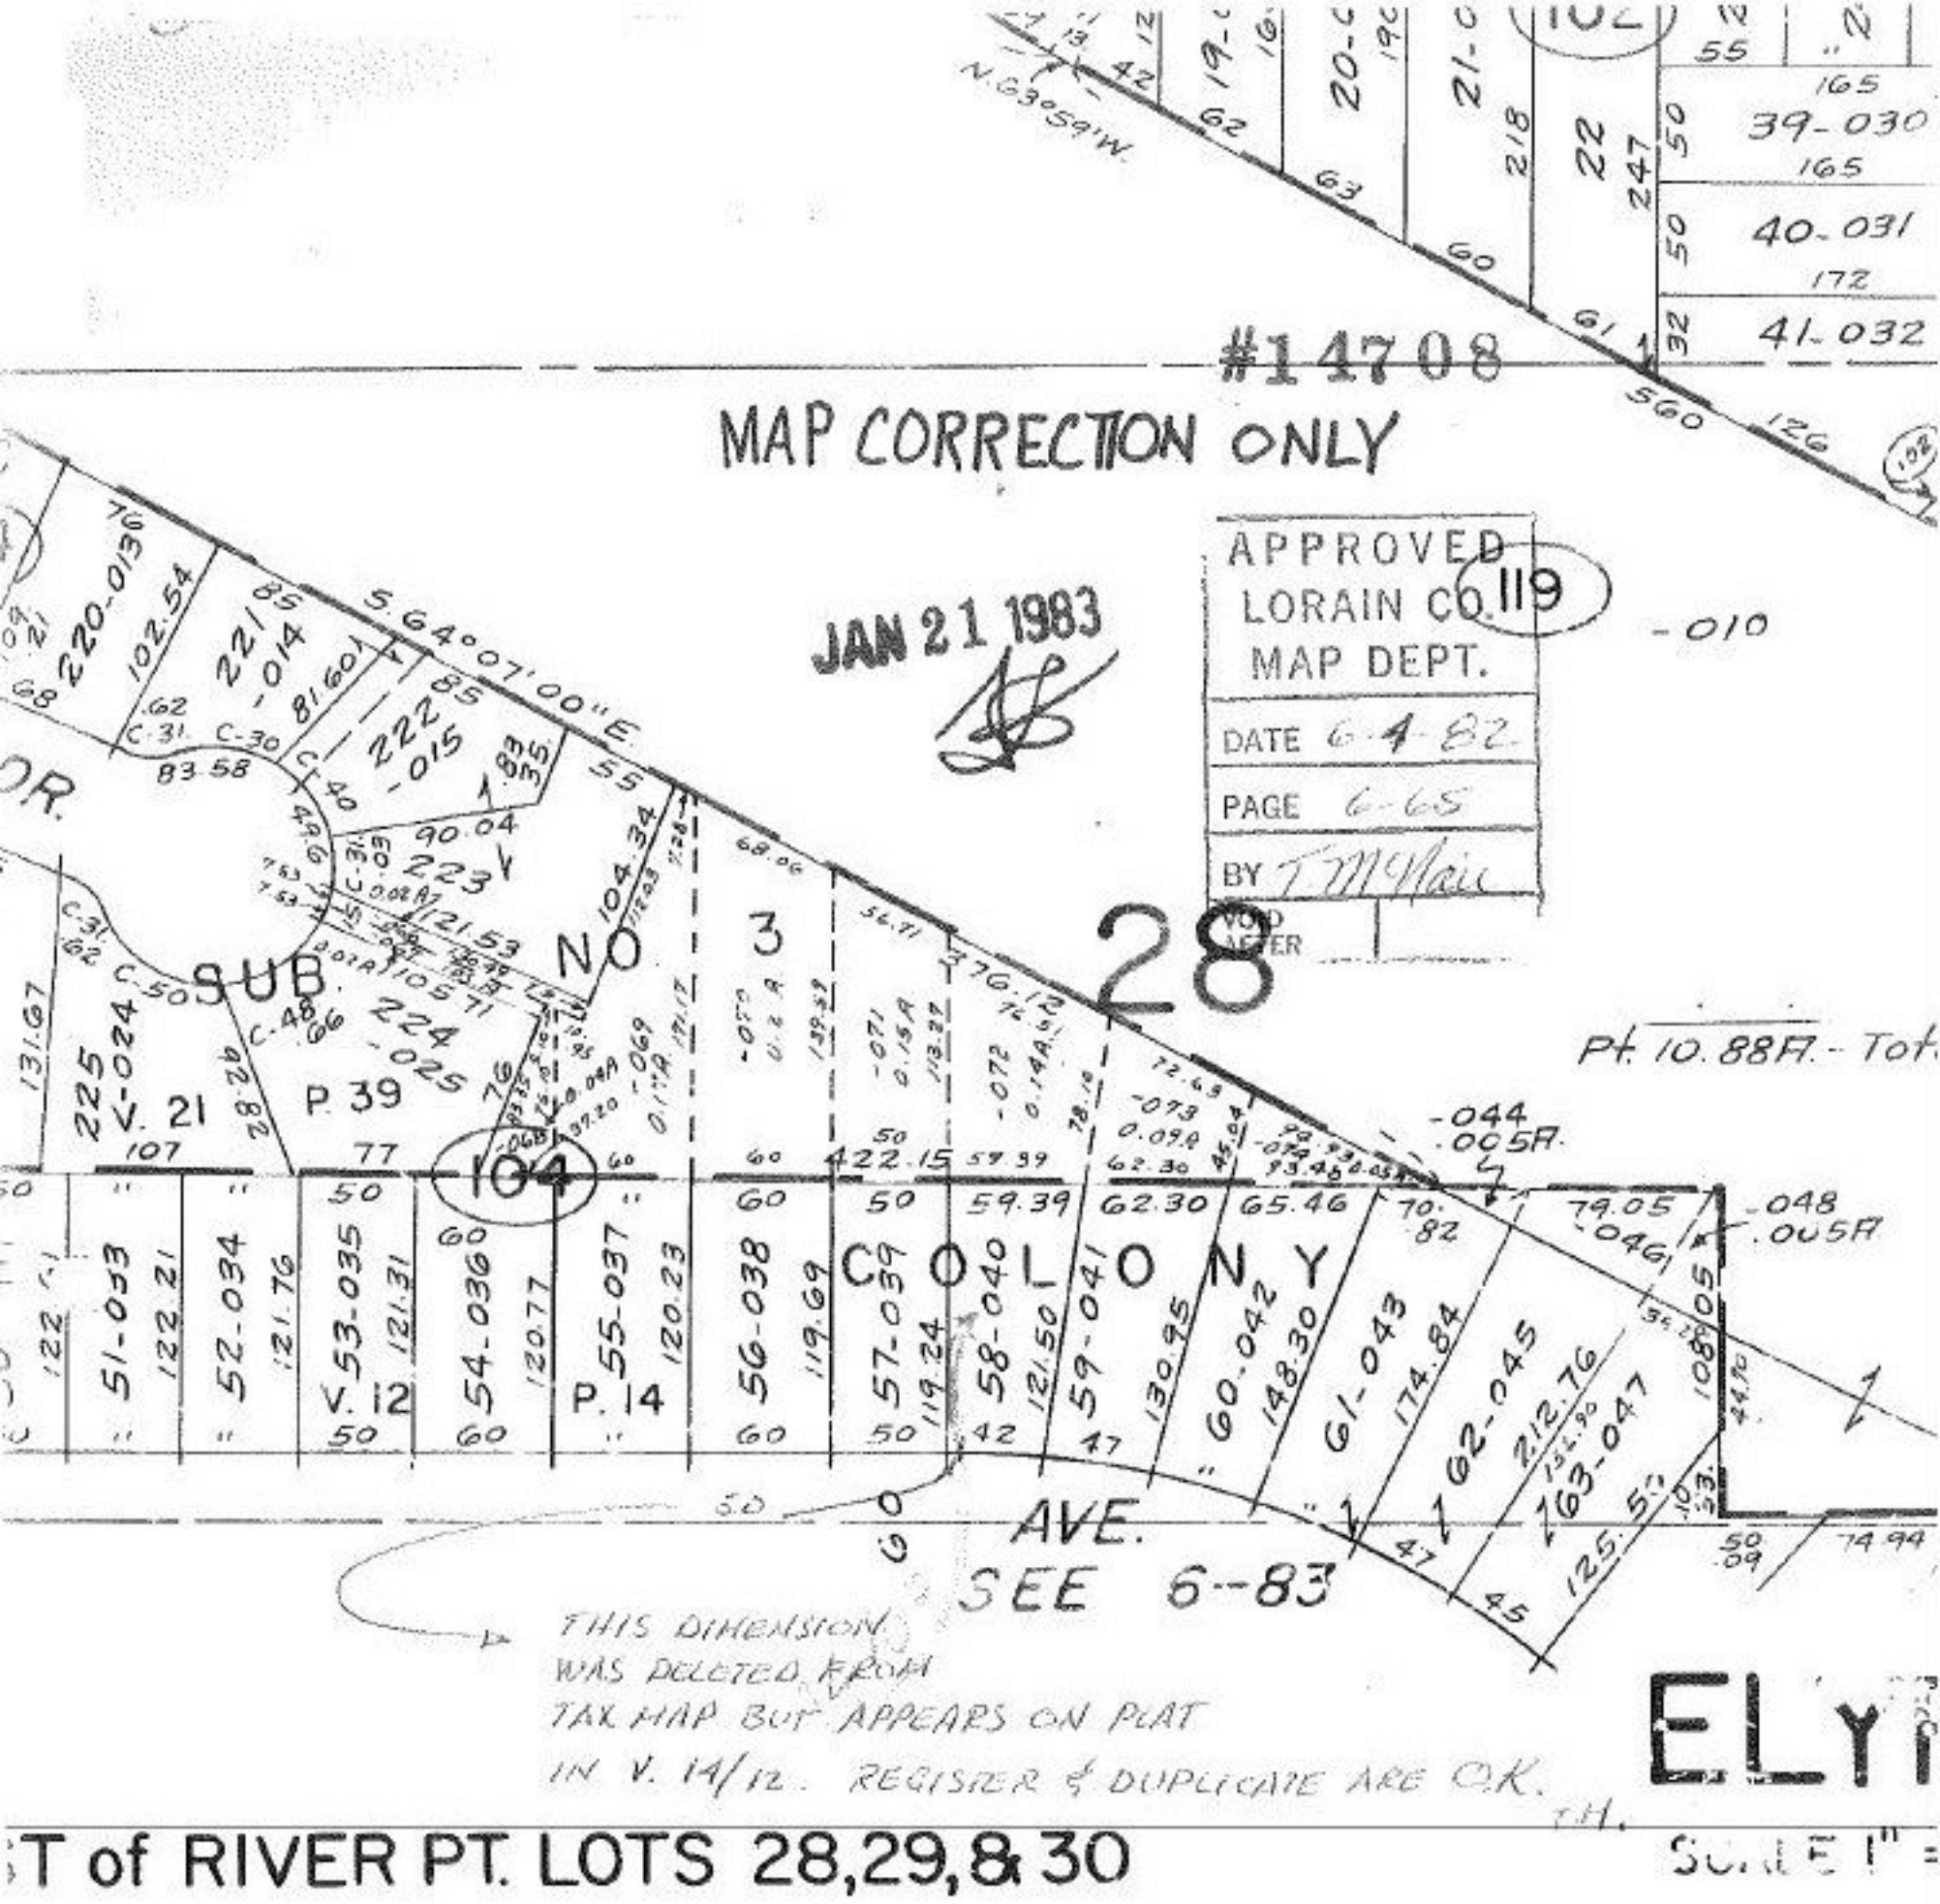
#14708
MAP CORRECTION ONLY
JAN 21 1983
APPROVED
LORAIN CO. 119
MAP DEPT.
DATE 6-4-82
PAGE 6-65
BY T McNair
VOID AFTER
28
SUB NO 3
COLONY
AVE.
SEE 6-83
Pt. 10.88A. - Tot
THIS DIMENSION WAS DELETED FROM TAX MAP BUT APPEARS ON PLAT IN V. 14/12. REGISTER & DUPLICATE ARE O.K.
ELY
T of RIVER PT. LOTS 28,29,& 30
SCALE 1" =