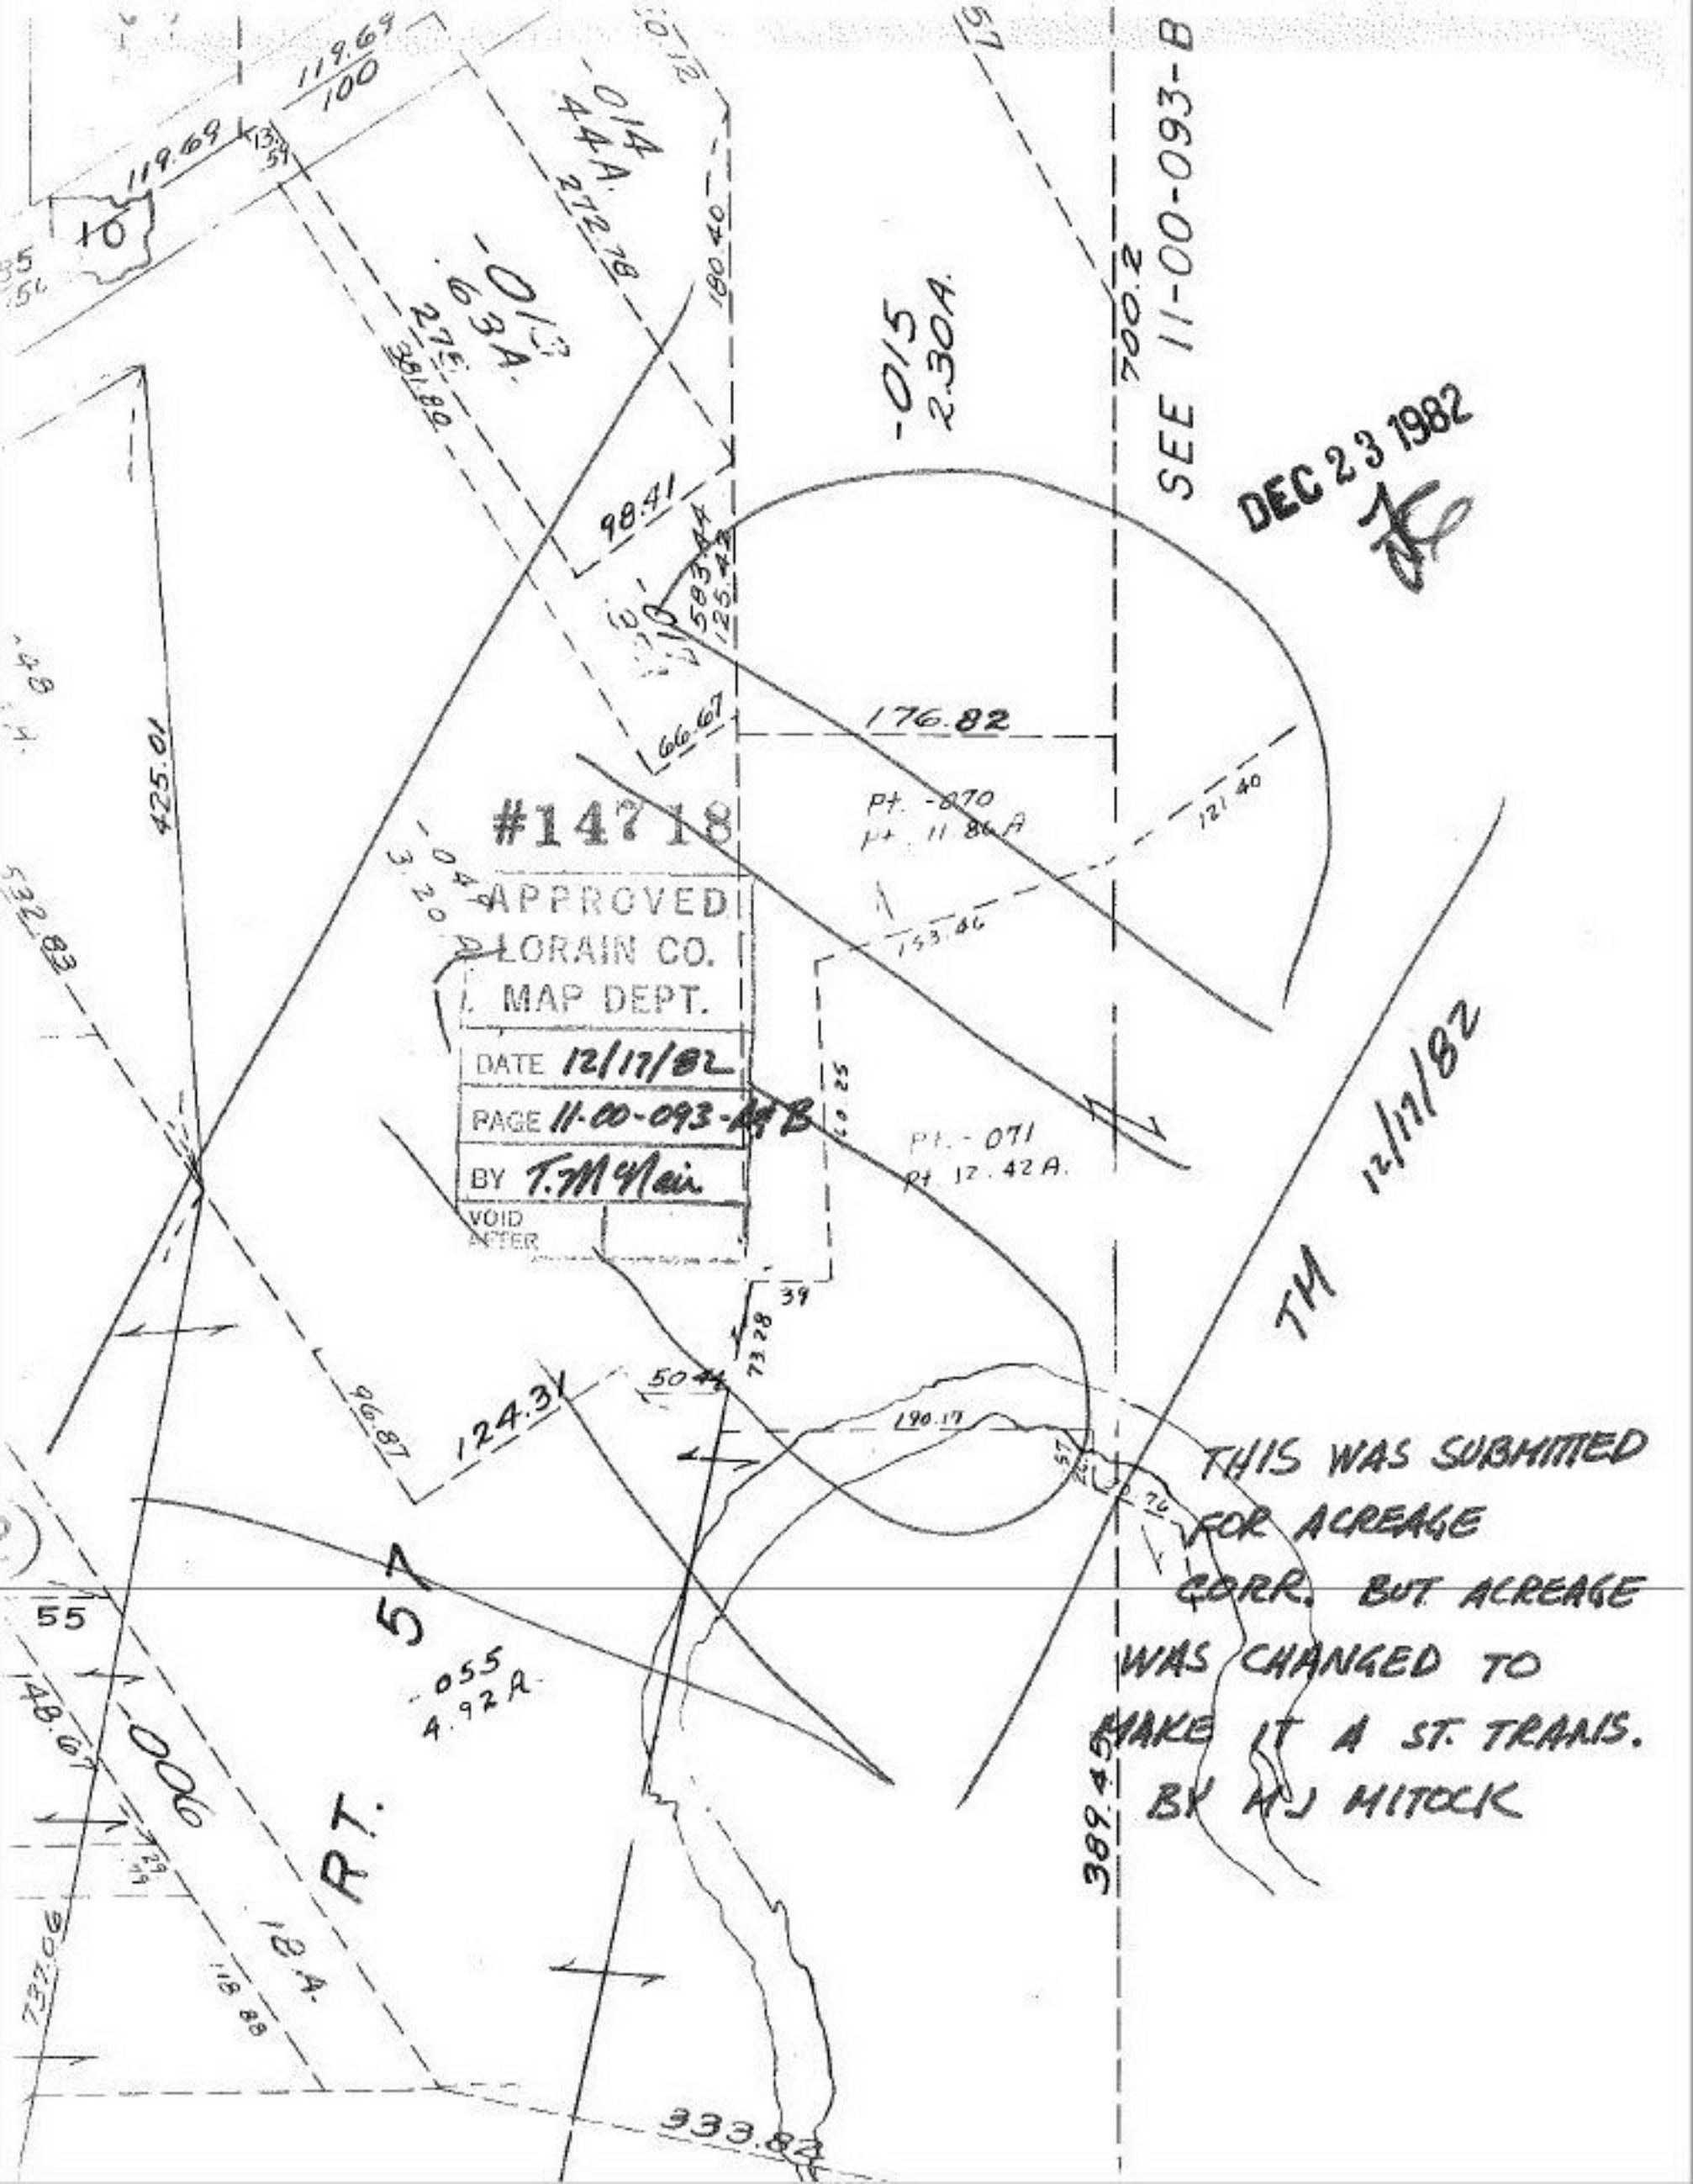

SEE 11-00-093-B
DEC 23 1982
#14718
APPROVED
LORAIN CO.
MAP DEPT.
DATE 12/17/82
PAGE 11-00-093-A&B
BY T.McNair
VOID AFTER
-014 44A.
-013 .63A.
-015 2.30A.
-006 18A.
-055 4.92A
-047 3.20
Pt. -070 Pt. 11.86A
Pt. -071 Pt. 12.42A.
176.82
98.41
66.67
124.31
96.87
425.01
333.82
389.45
700.2
TM 12/17/82
RT. 57
THIS WAS SUBMITTED FOR ACREAGE CORR. BUT ACREAGE WAS CHANGED TO MAKE IT A ST. TRANS. BY MJ MITOCK