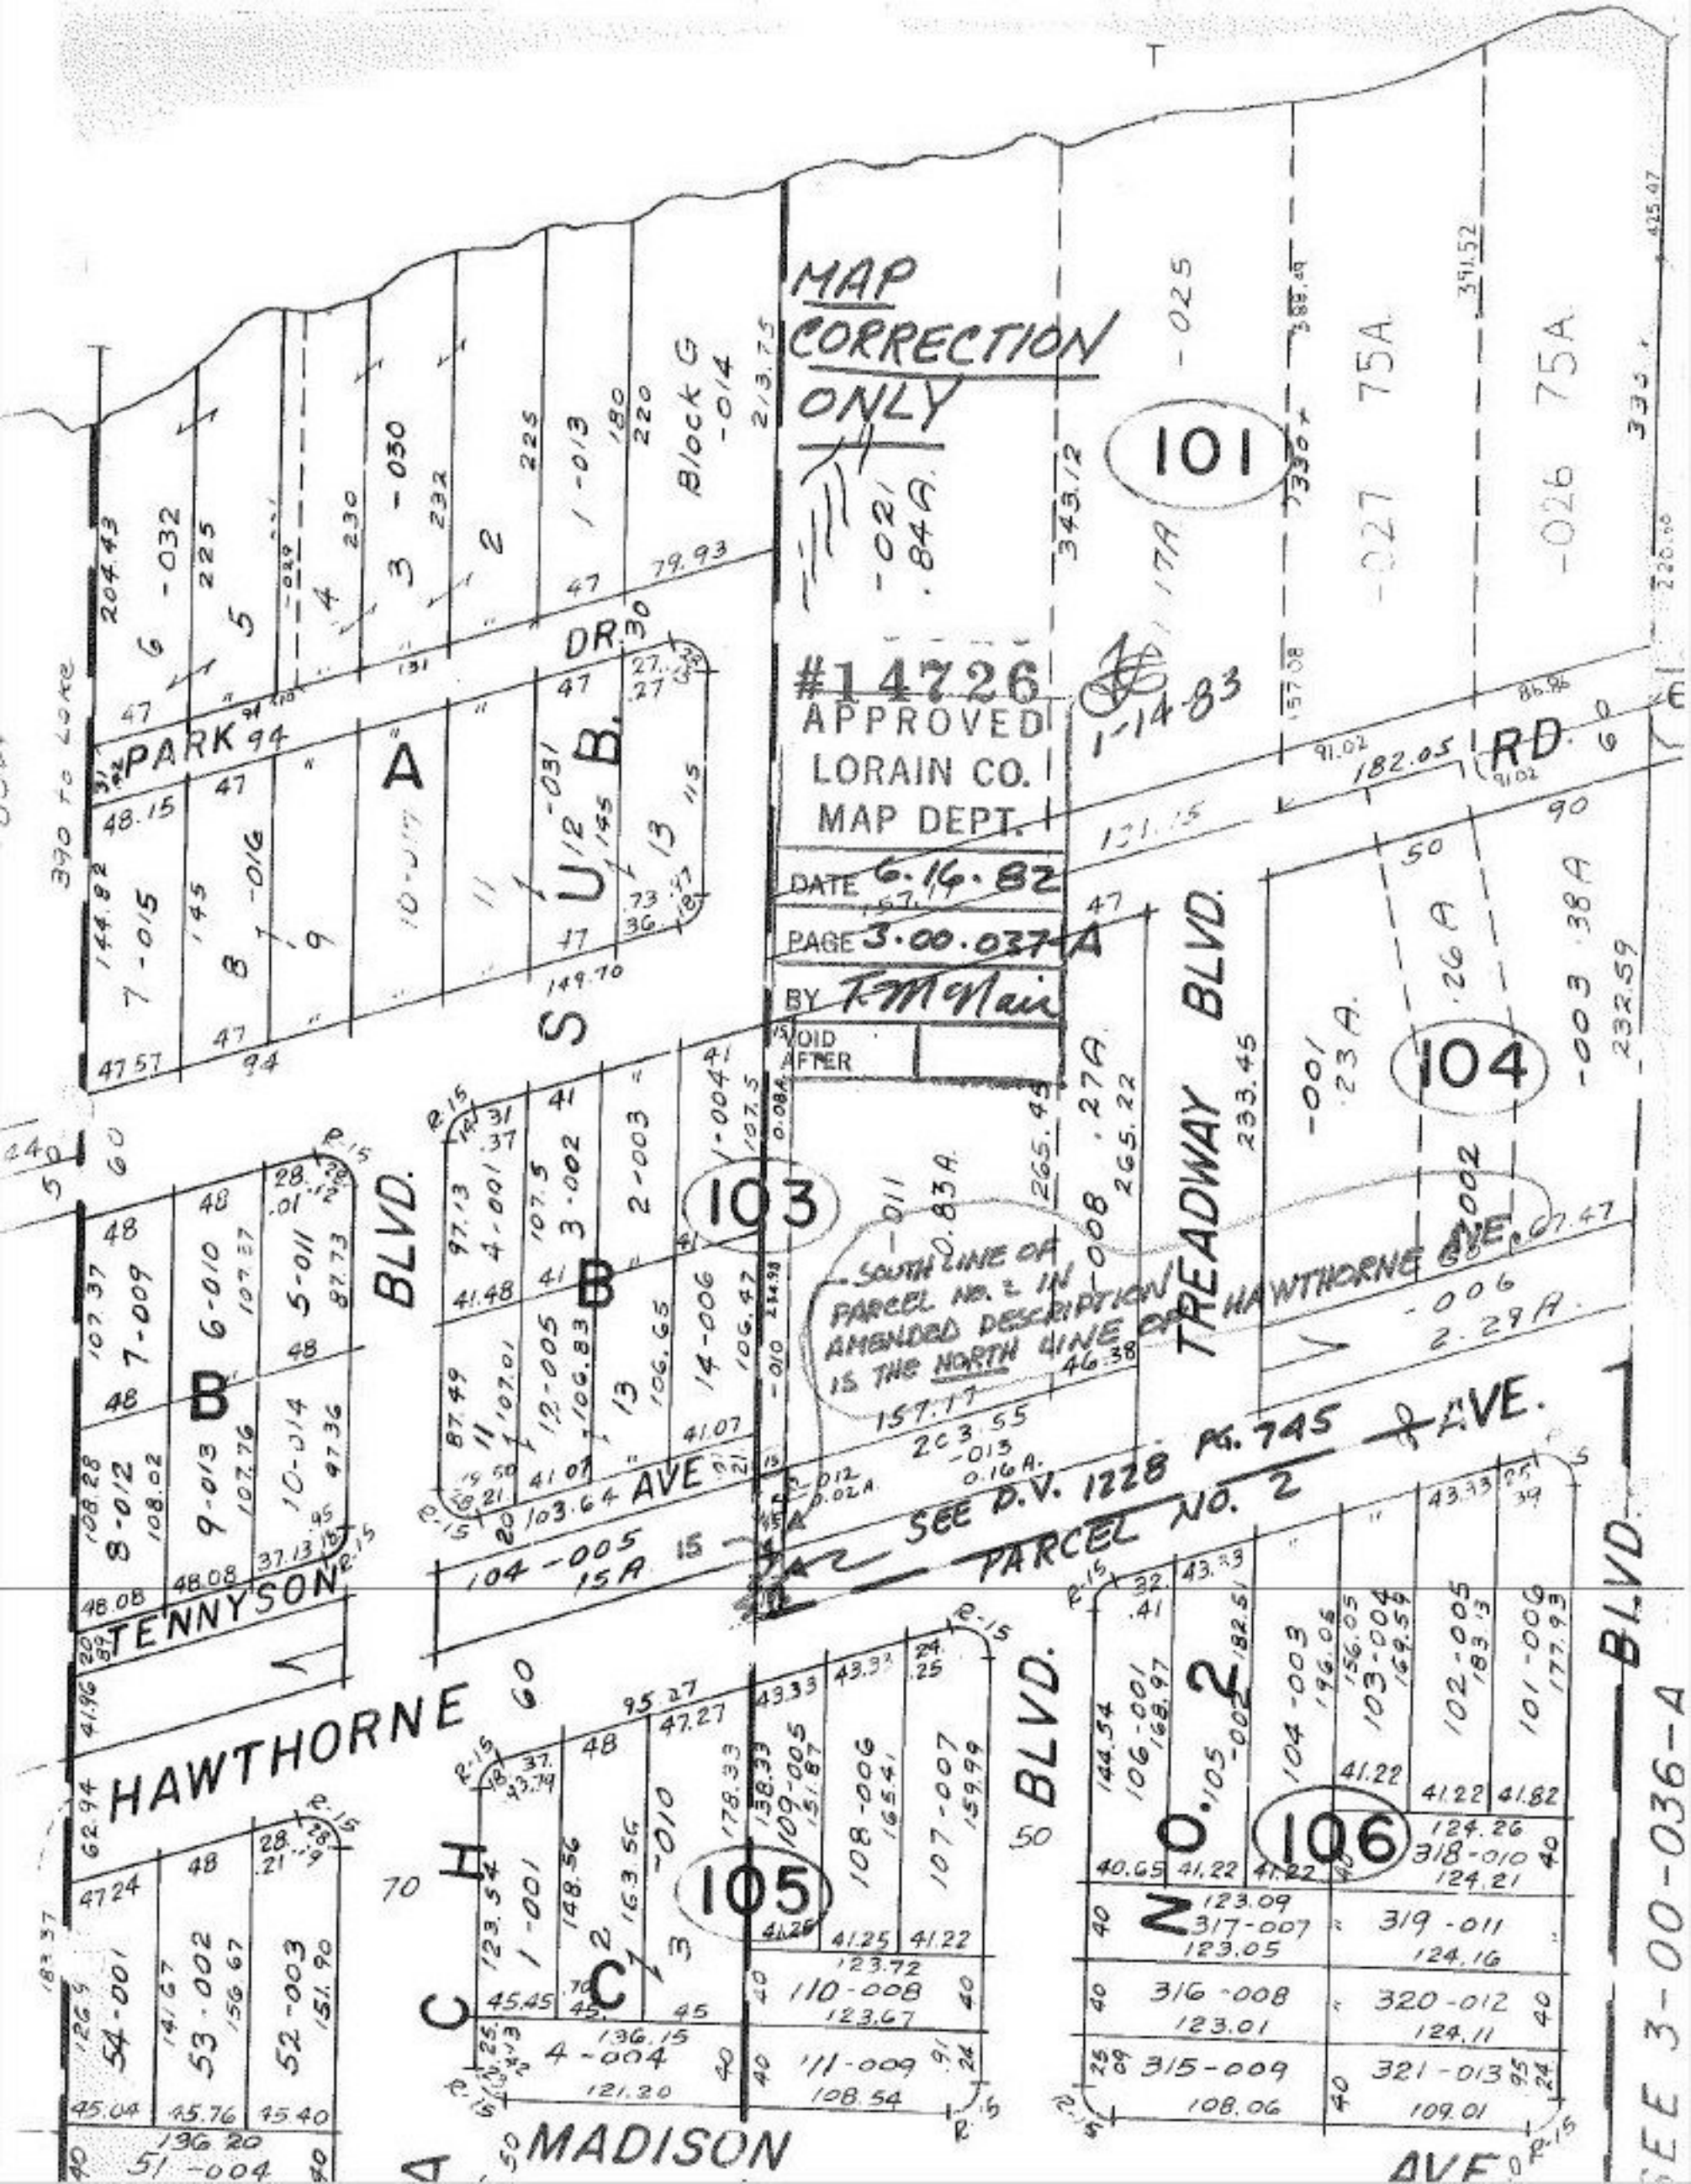
MAP CORRECTION ONLY
#14726
APPROVED
LORAIN CO.
MAP DEPT.
DATE 6.16.82
PAGE 3.00.037-A
BY T.M. Nair
VOID AFTER
1-14-83
SOUTH LINE OF PARCEL NO. 2 IN AMENDED DESCRIPTION IS THE NORTH LINE OF HAWTHORNE AVE.
SEE D.V. 1228 PG. 745
PARCEL NO. 2
101
103
104
105
106
PARK
DR.
TENNYSON
HAWTHORNE
MADISON
AVE
TREADWAY BLVD.
RD.
BLVD.
SEE 3-00-036-A