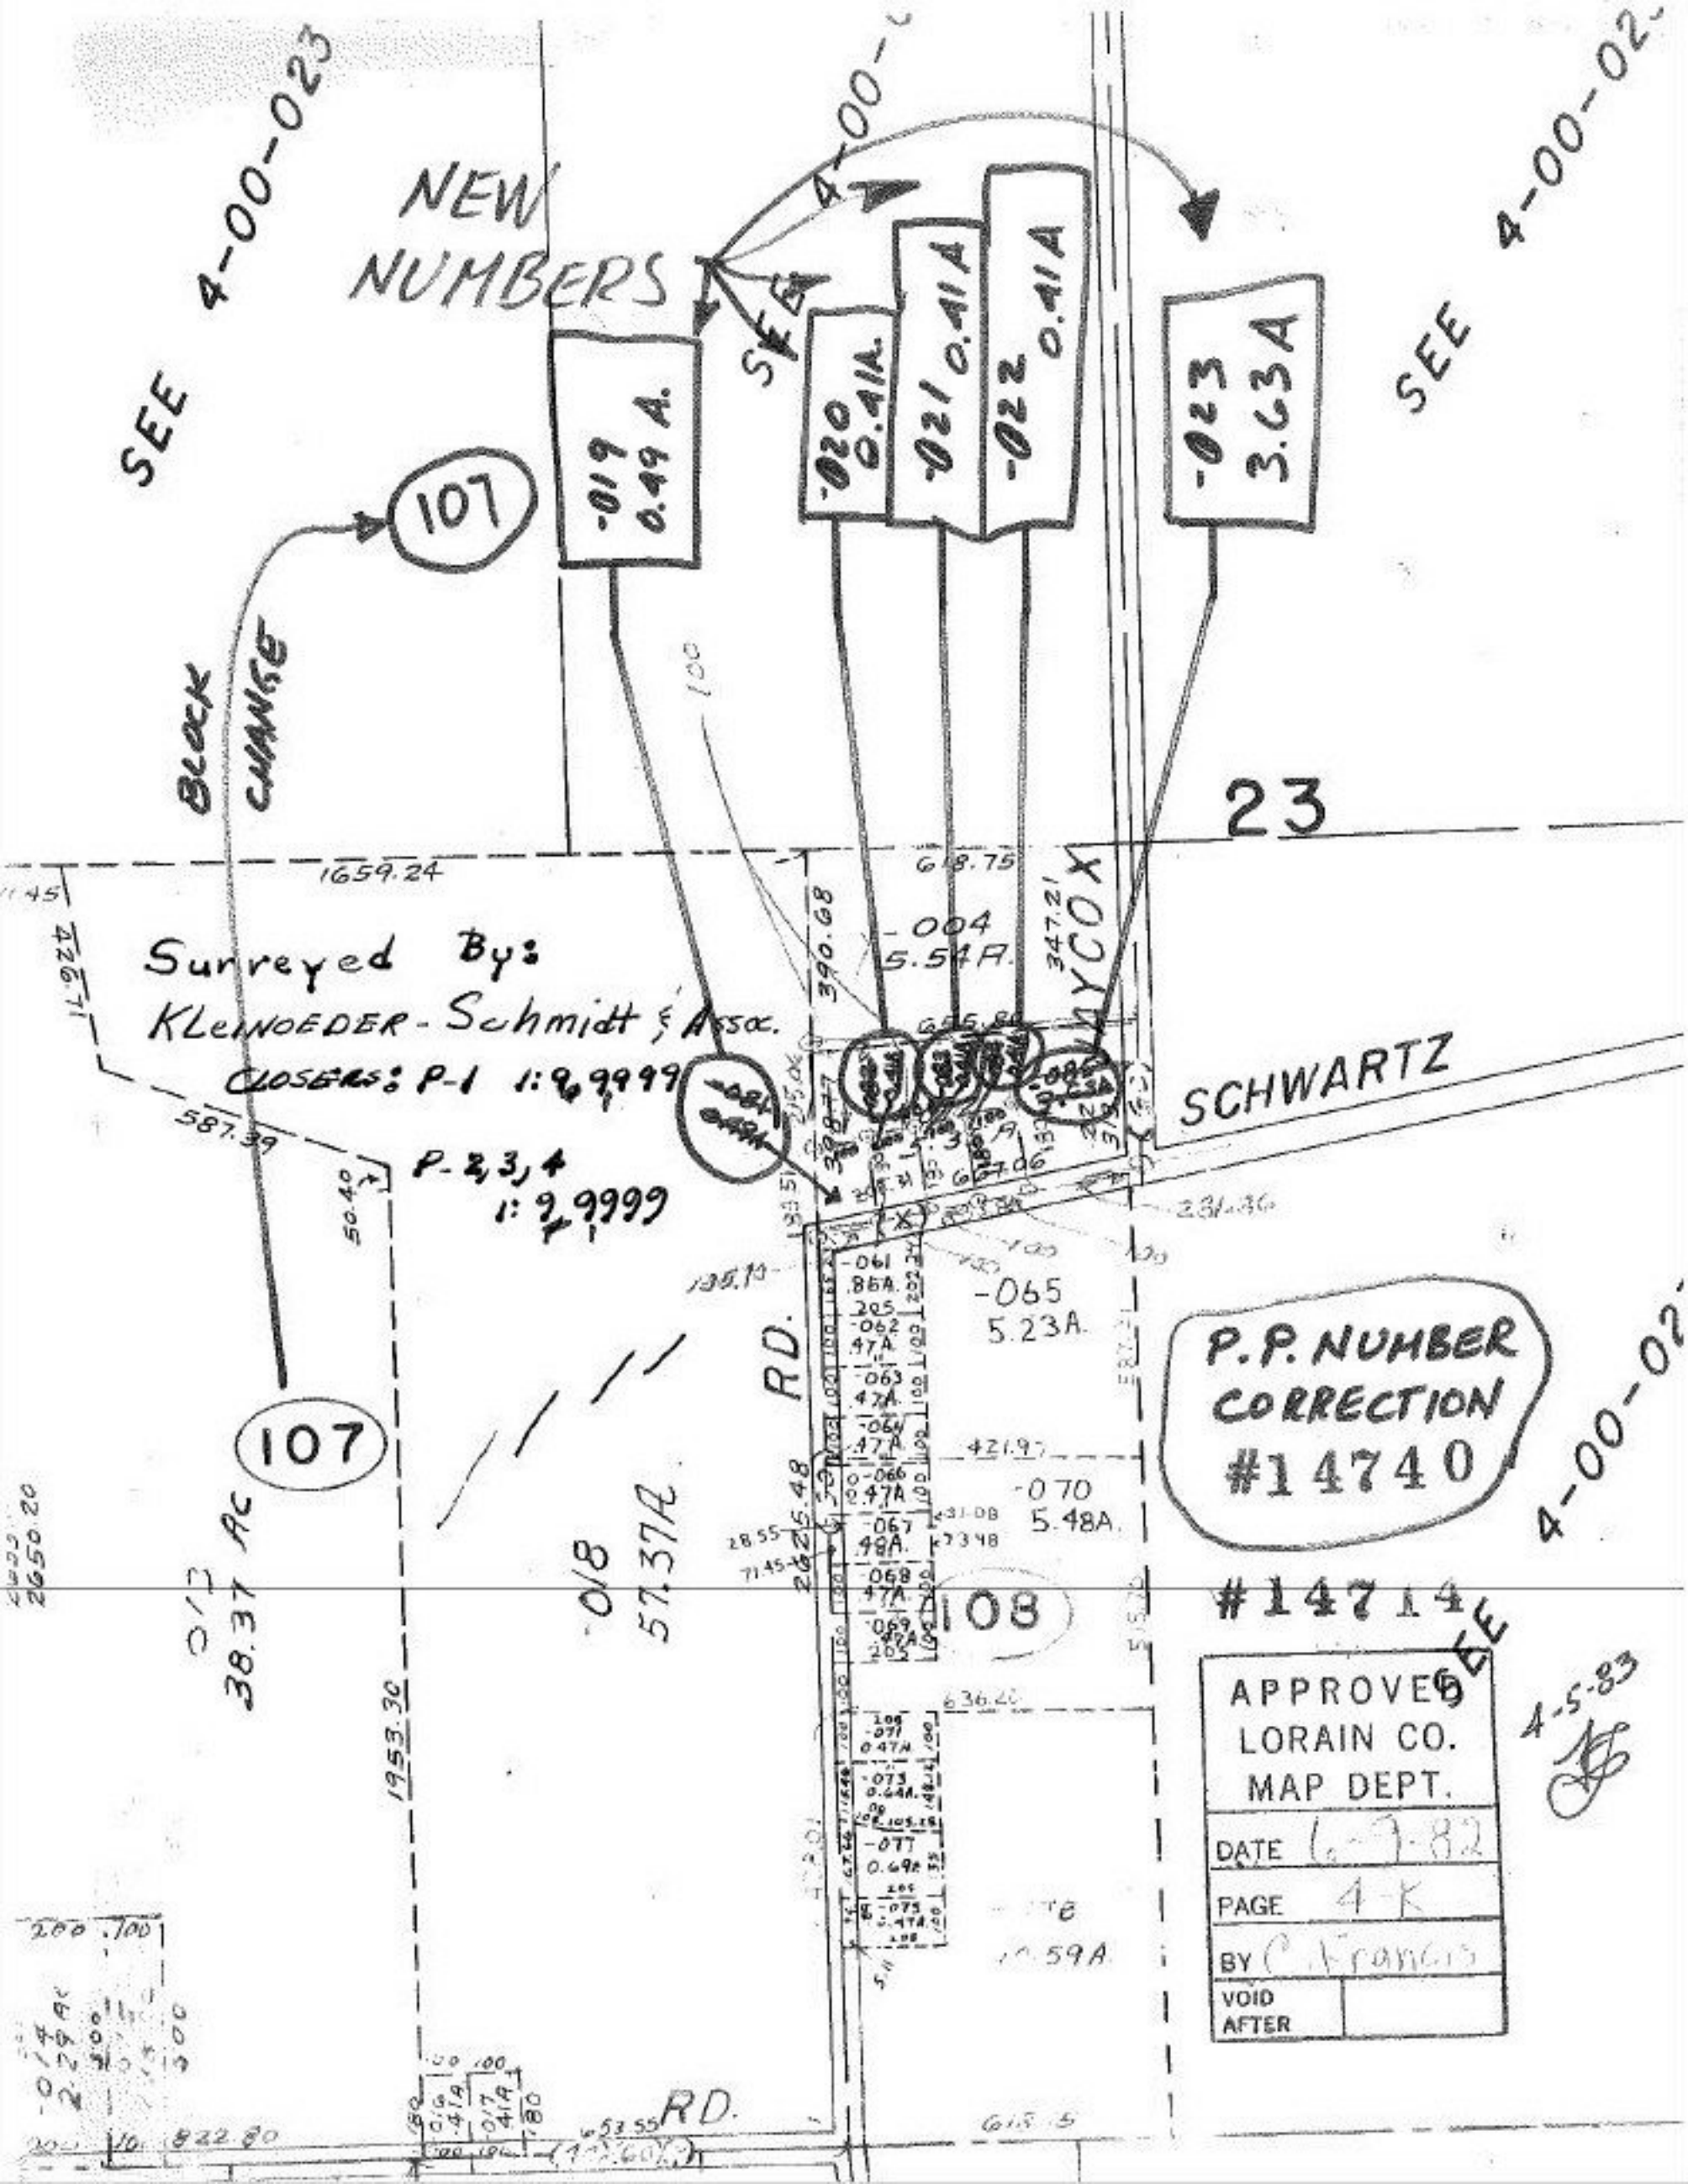

SEE 4-00-023
NEW NUMBERS
SEE 4-00-023
SEE 4-00-023
-019 0.49 A.
-020 0.41A.
-021 0.41 A
-022 0.41 A
-023 3.63 A
107
BLOCK CHANGE
23
1659.24
618.75
390.68
347.21
-004 5.54A.
MYCOX
Surveyed By:
KLEINOEDER-Schmidt & Assoc.
CLOSERS: P-1 1:9,9999
P-2,3,4 1:9,9999
SCHWARTZ
587.39
50.40
-061 .86A.
-062 .47A.
-063 .47A.
-064 .47A.
-066 .47A.
-067 .48A.
-068 .47A.
-069 .47A.
-065 5.23A.
-070 5.48A.
RD.
107
P.P. NUMBER CORRECTION #14740
4-00-02
#14714
108
-018 57.37A
-013 38.37 AC
1953.30
636.20
-071 0.47A
-073 0.64A.
-077 0.69A
-075 0.47A.
10.59A
SEE
4-5-83
APPROVED LORAIN CO. MAP DEPT.
DATE 6-9-82
PAGE 4-K
BY C. Francis
VOID AFTER
RD.
822.80