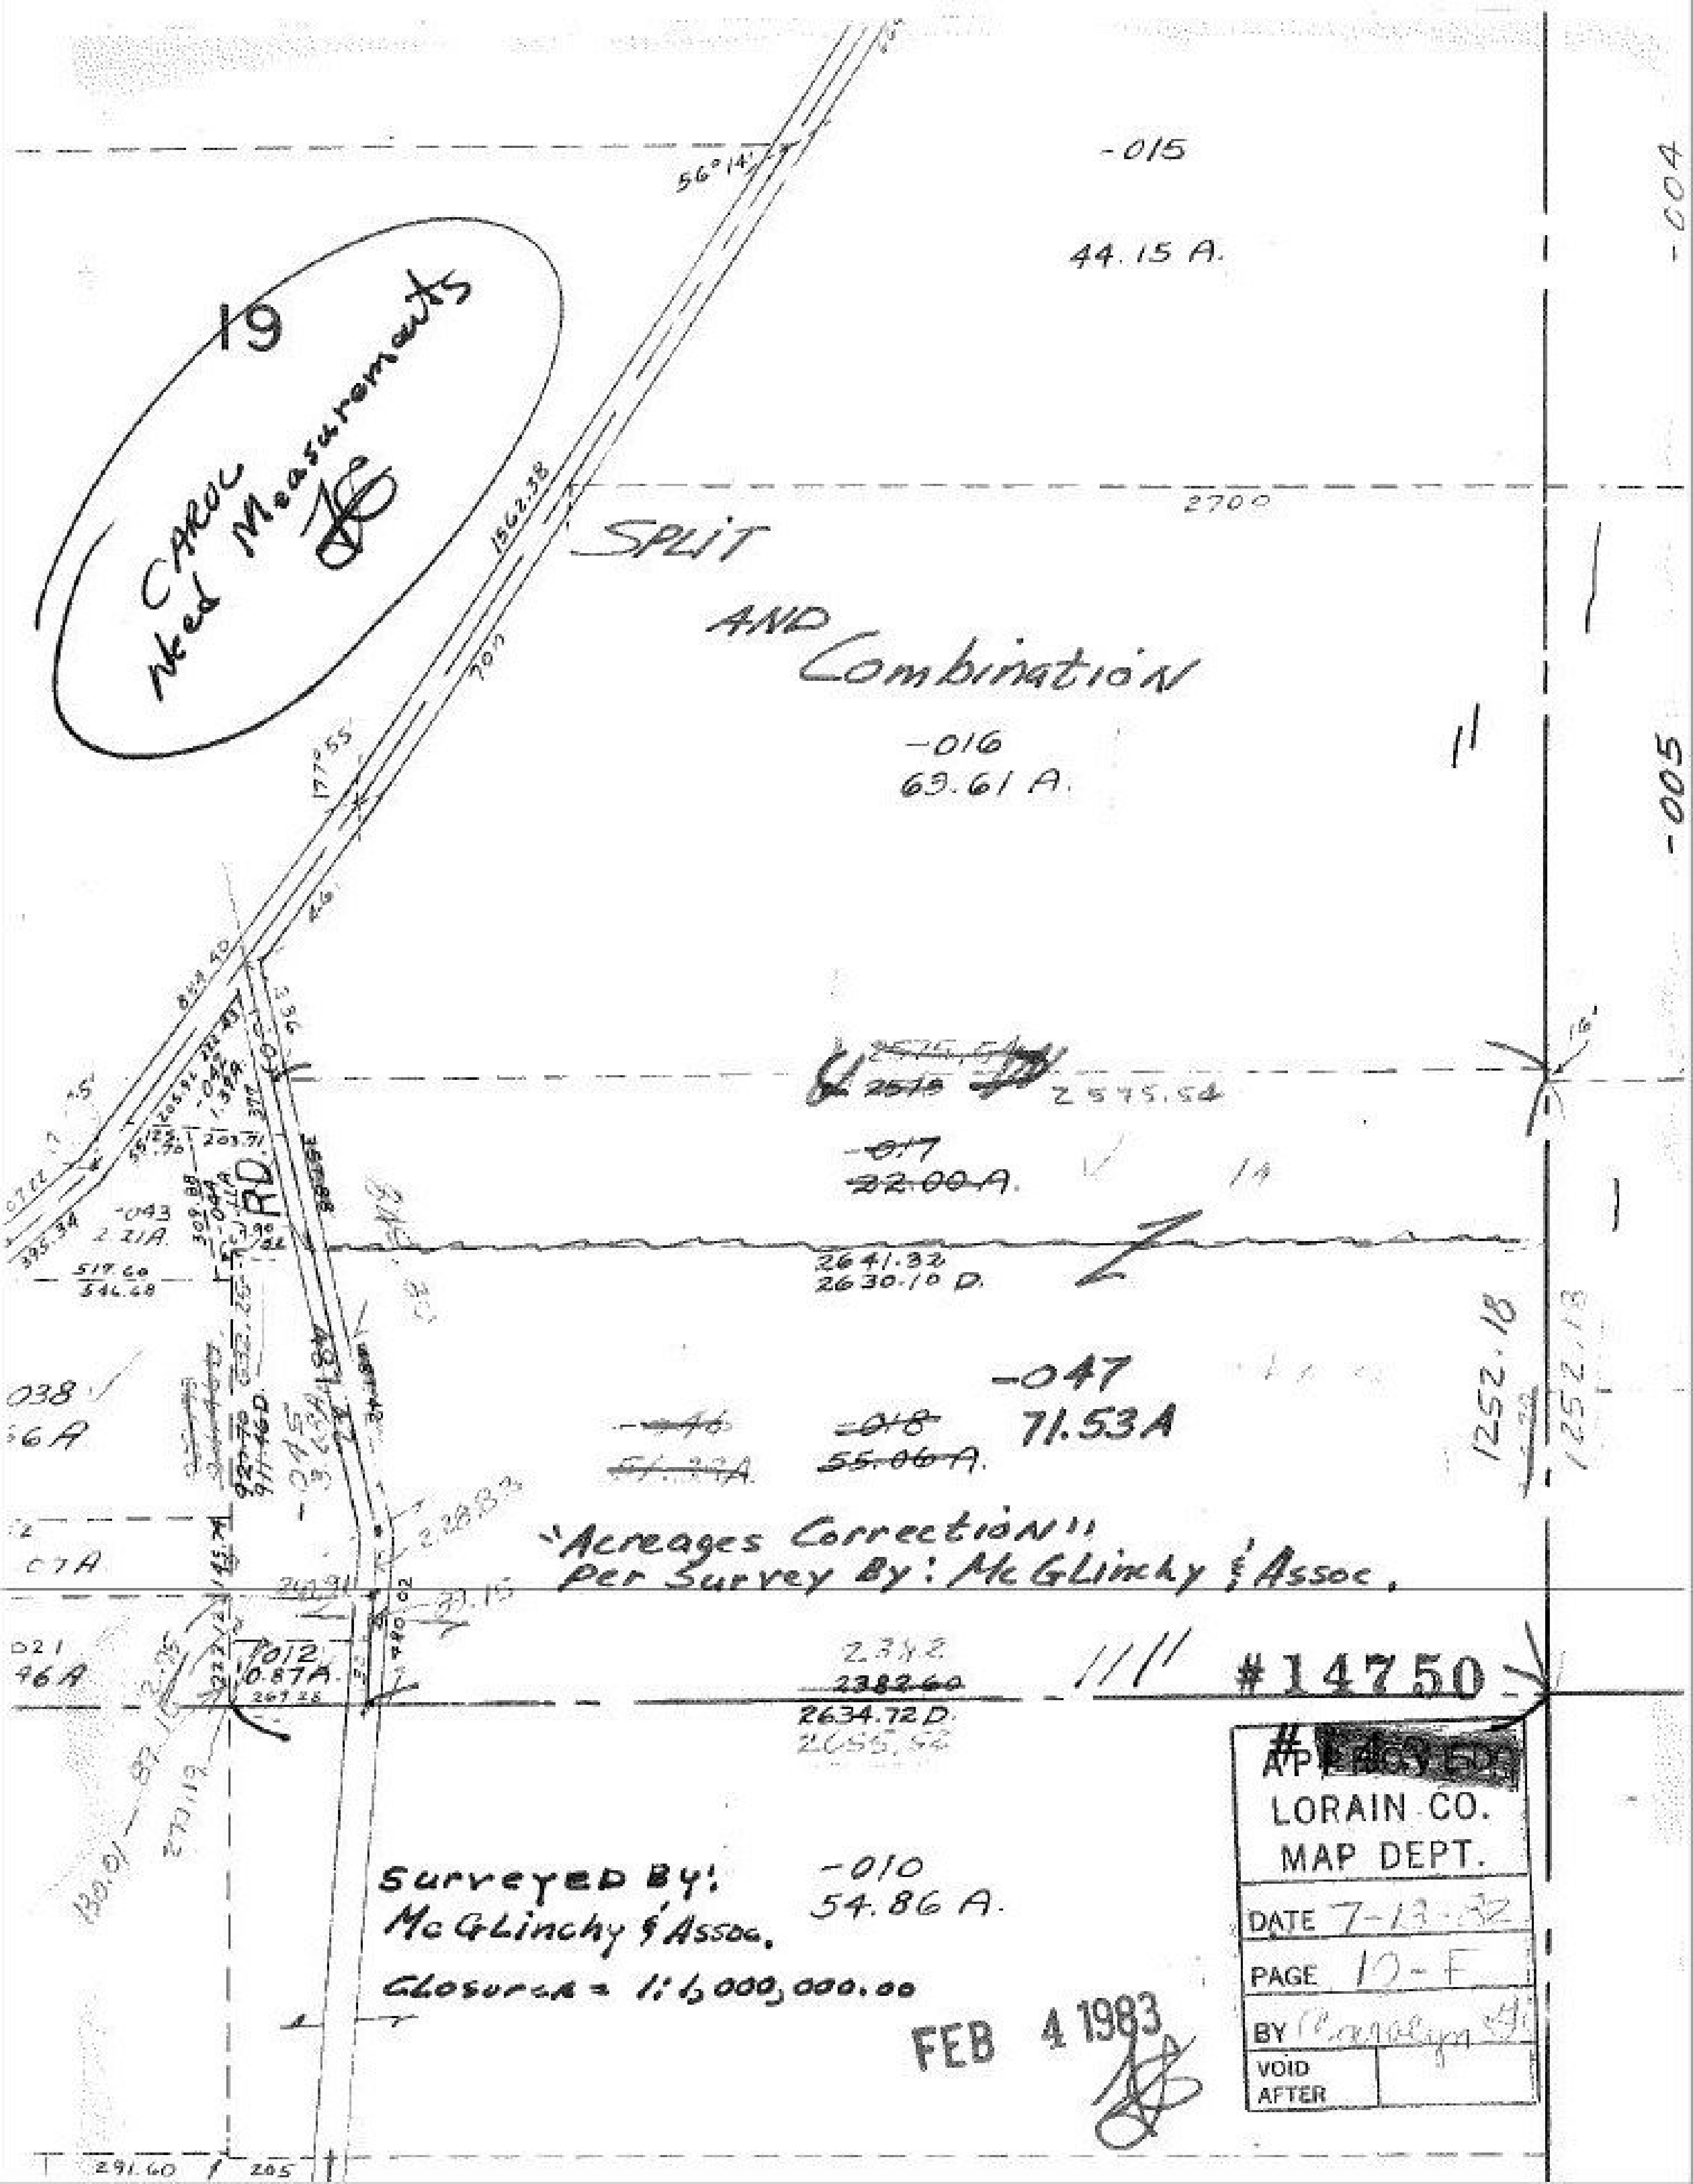
19
CAROL
Need Measurements
56°14'
1562.38
-015
44.15 A.
2700
SPLIT
AND
Combination
-016
63.61 A.
-004
-005
177°55'
2575.54
-017
22.00 A.
2641.32
2630.10 D.
-043
2.21A.
395.34
517.60
546.68
RD.
203.71
038
-047
71.53A
-018
55.06 A.
1252.18
"Acreages Correction"
Per Survey By: McGlinchy & Assoc.
2382.60
2634.72 D.
#14750
-012
0.87A.
021
46A
LORAIN CO.
MAP DEPT.
DATE 7-13-82
PAGE 10-F
BY
VOID
AFTER
Surveyed By:
McGlinchy & Assoc.
-010
54.86 A.
Closure = 1:6,000,000.00
FEB 4 1983
291.60
205