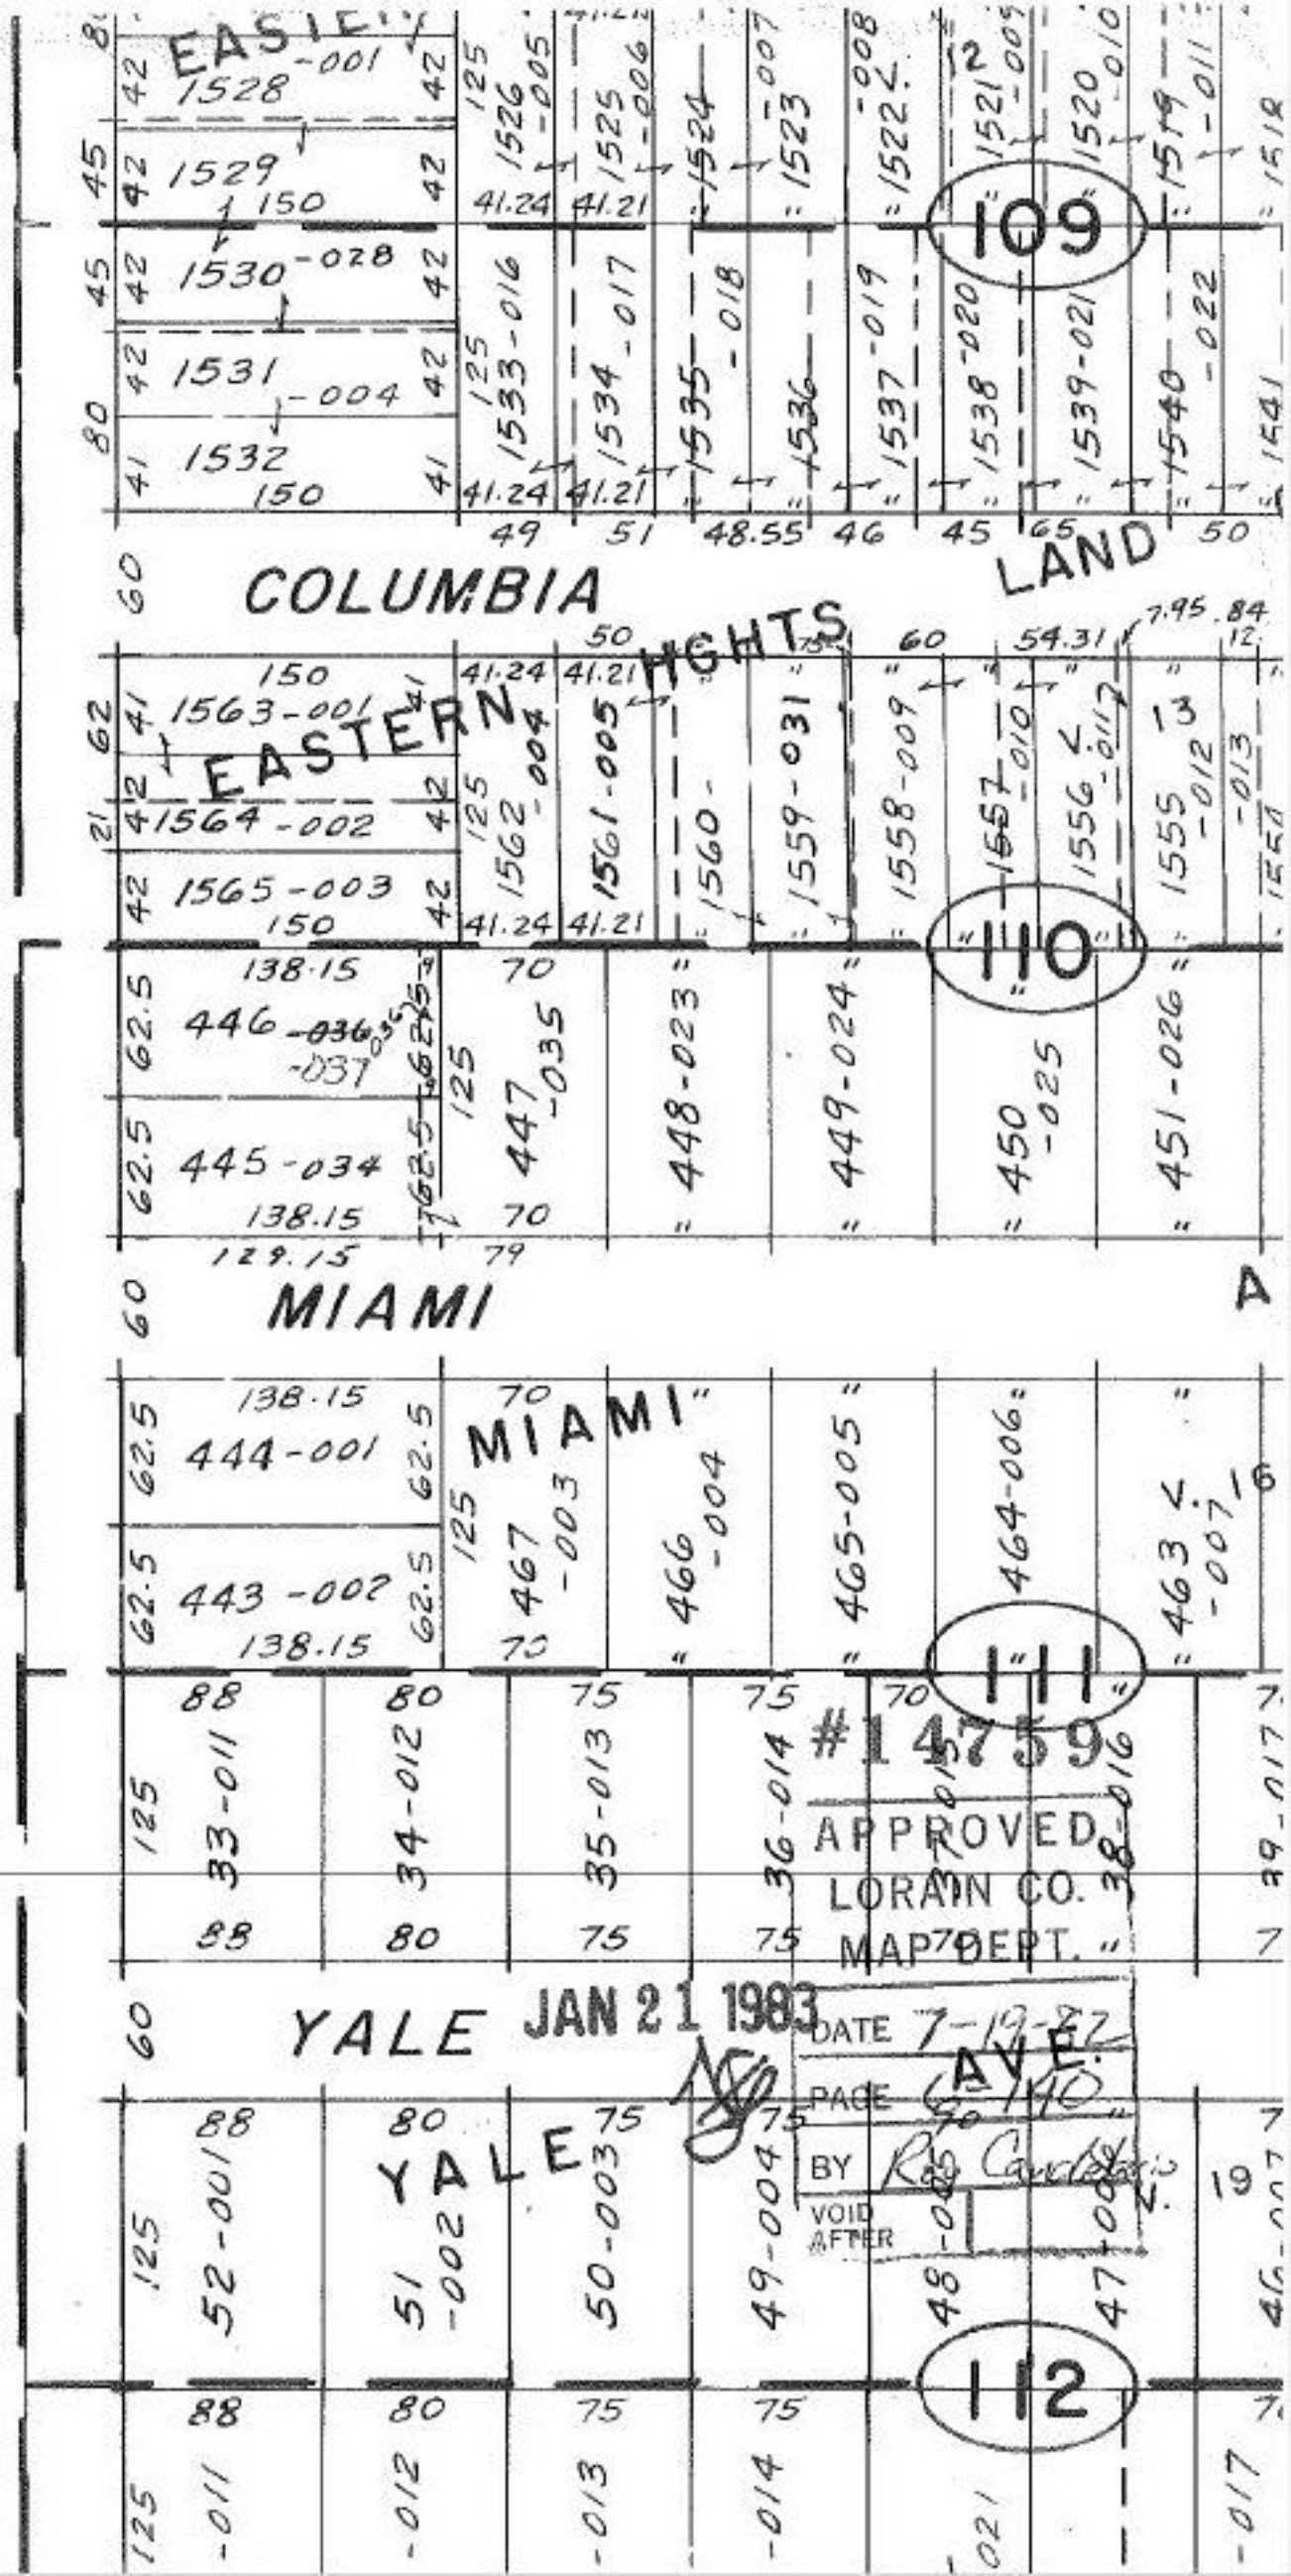
EASTERN
COLUMBIA
LAND
EASTERN HGHTS
MIAMI
MIAMI
YALE
YALE
109
110
111
112
#14759
APPROVED
LORAIN CO.
MAP DEPT.
JAN 21 1983
DATE 7-19-82
PAGE 6-140
BY
VOID AFTER

6-139