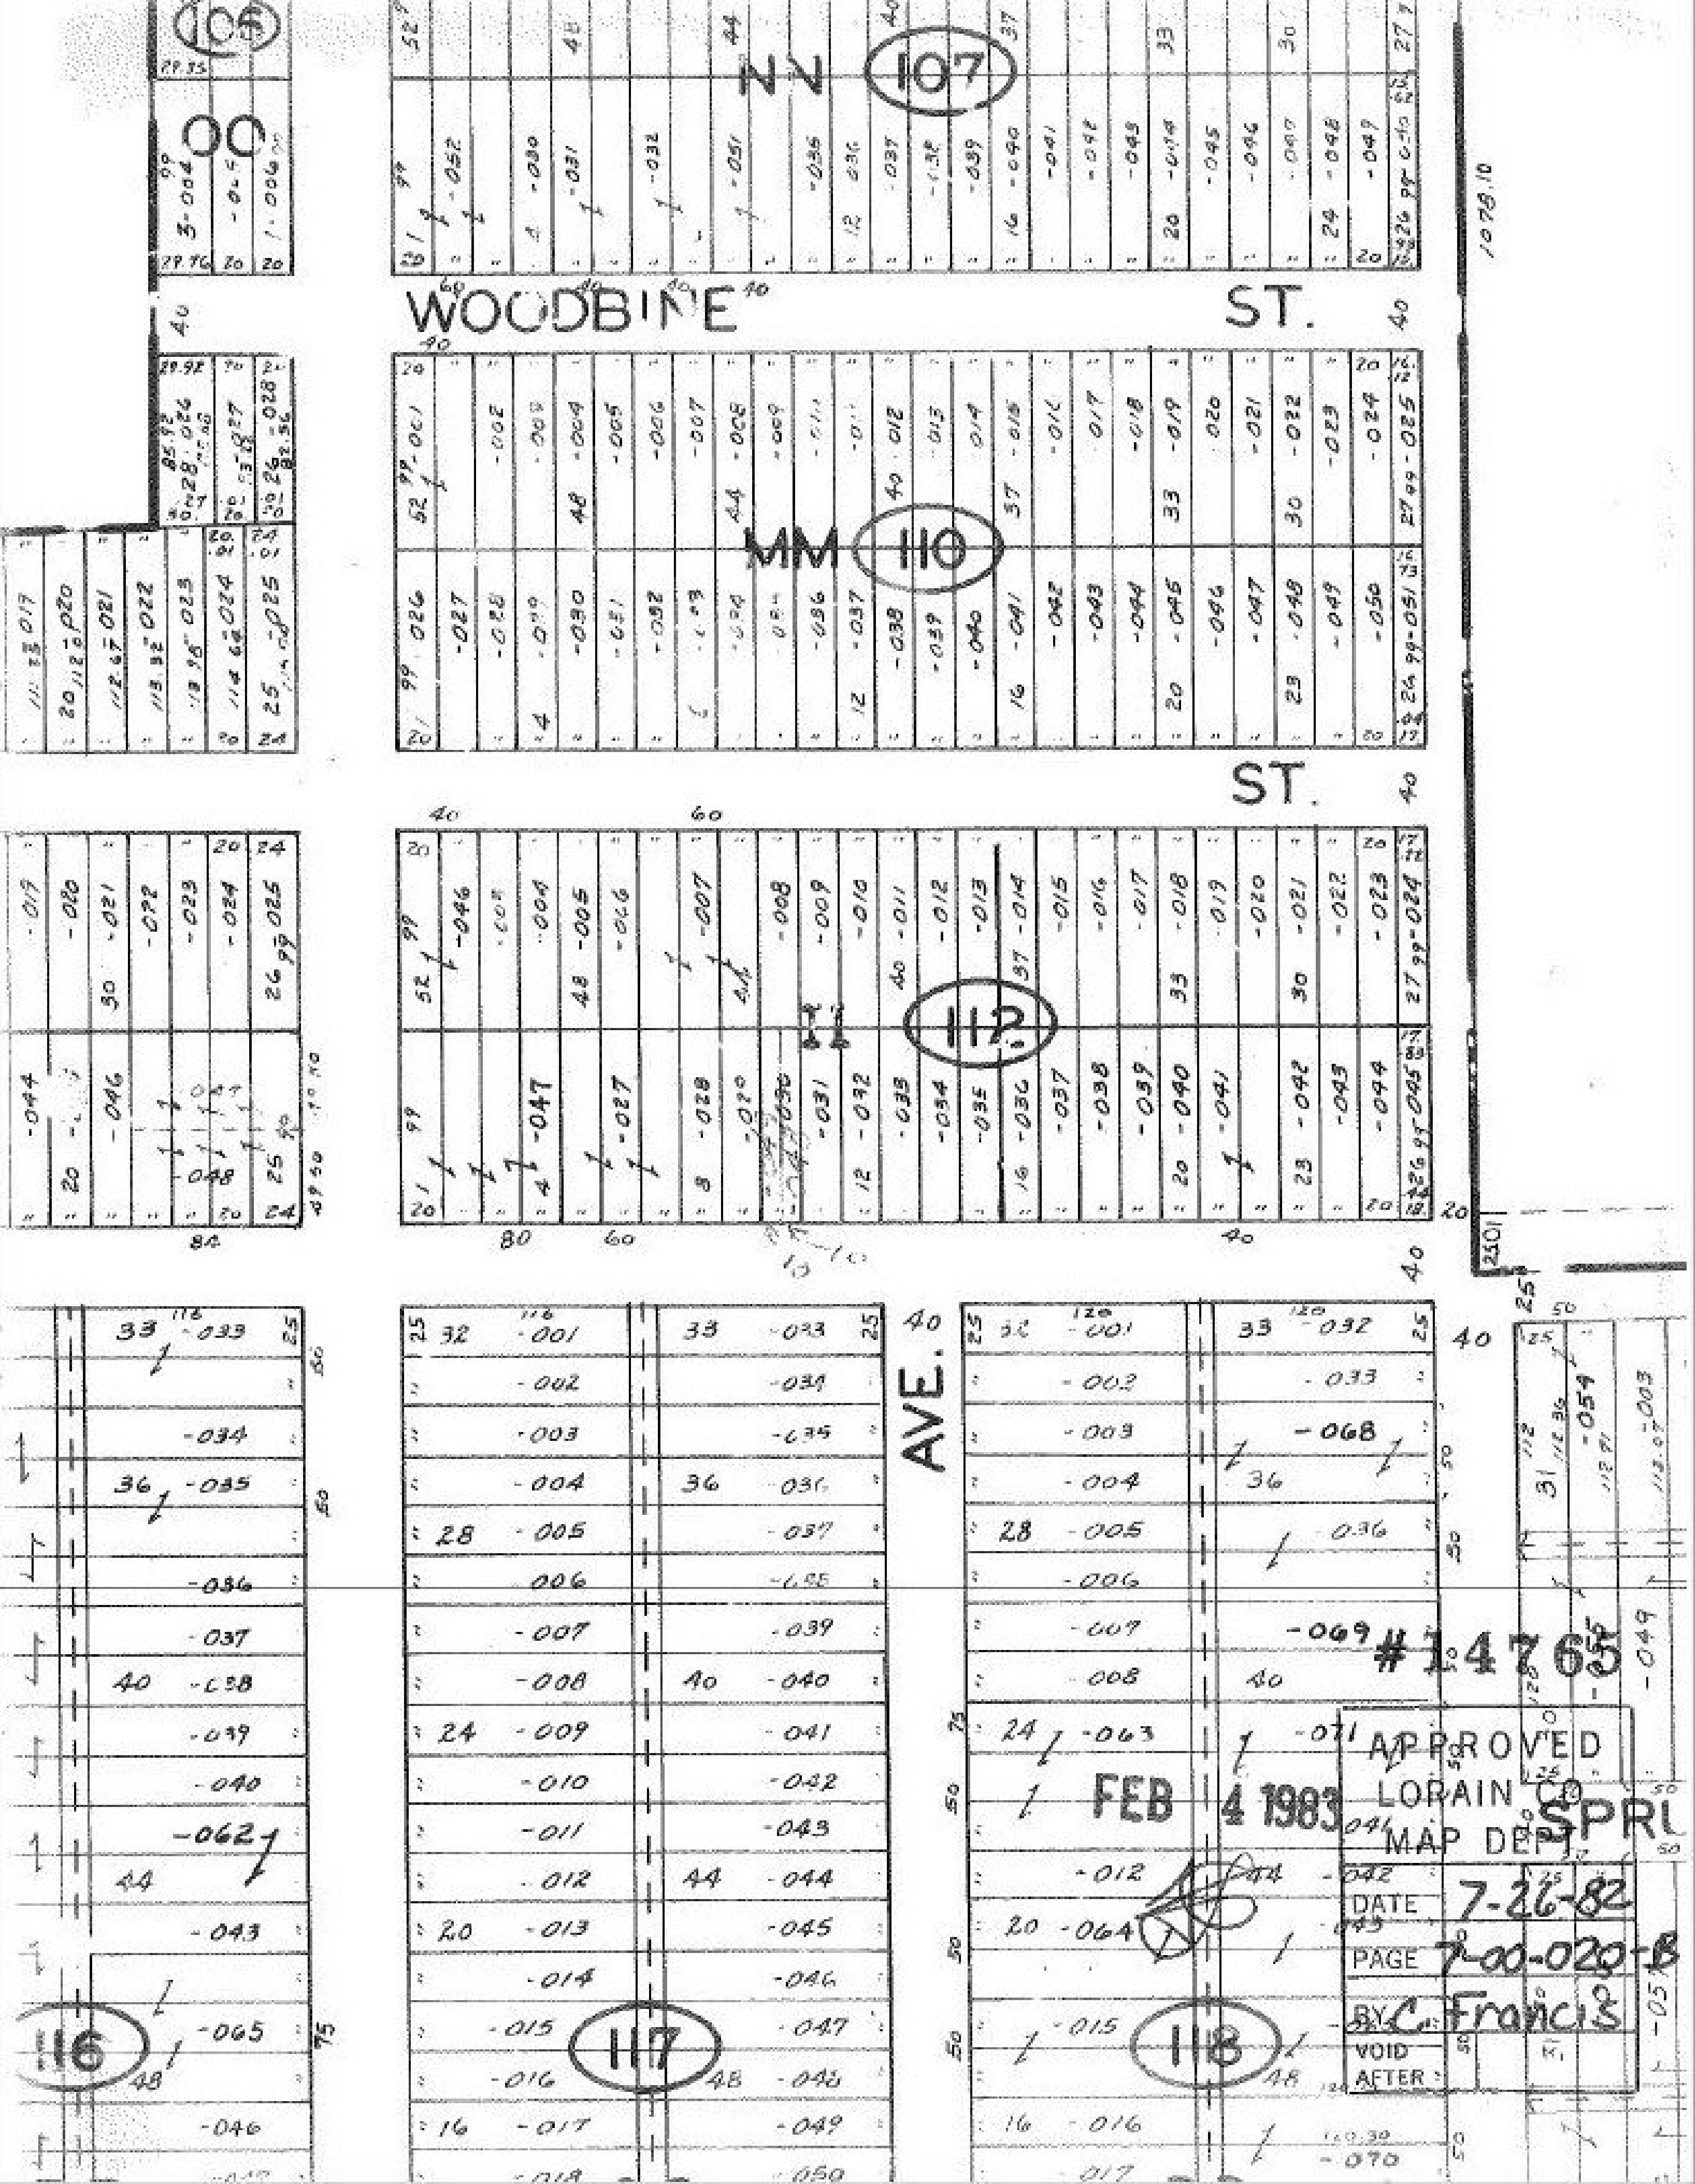
105
OO
NN
107
WOODBINE ST.
MM
110
ST.
112
AVE.
116
117
118
1078.10
#14765
FEB 4 1983
APPROVED
LORAIN CO
MAP DEPT
DATE 7-26-82
PAGE 7-00-020-B
BY C. Francis
VOID AFTER