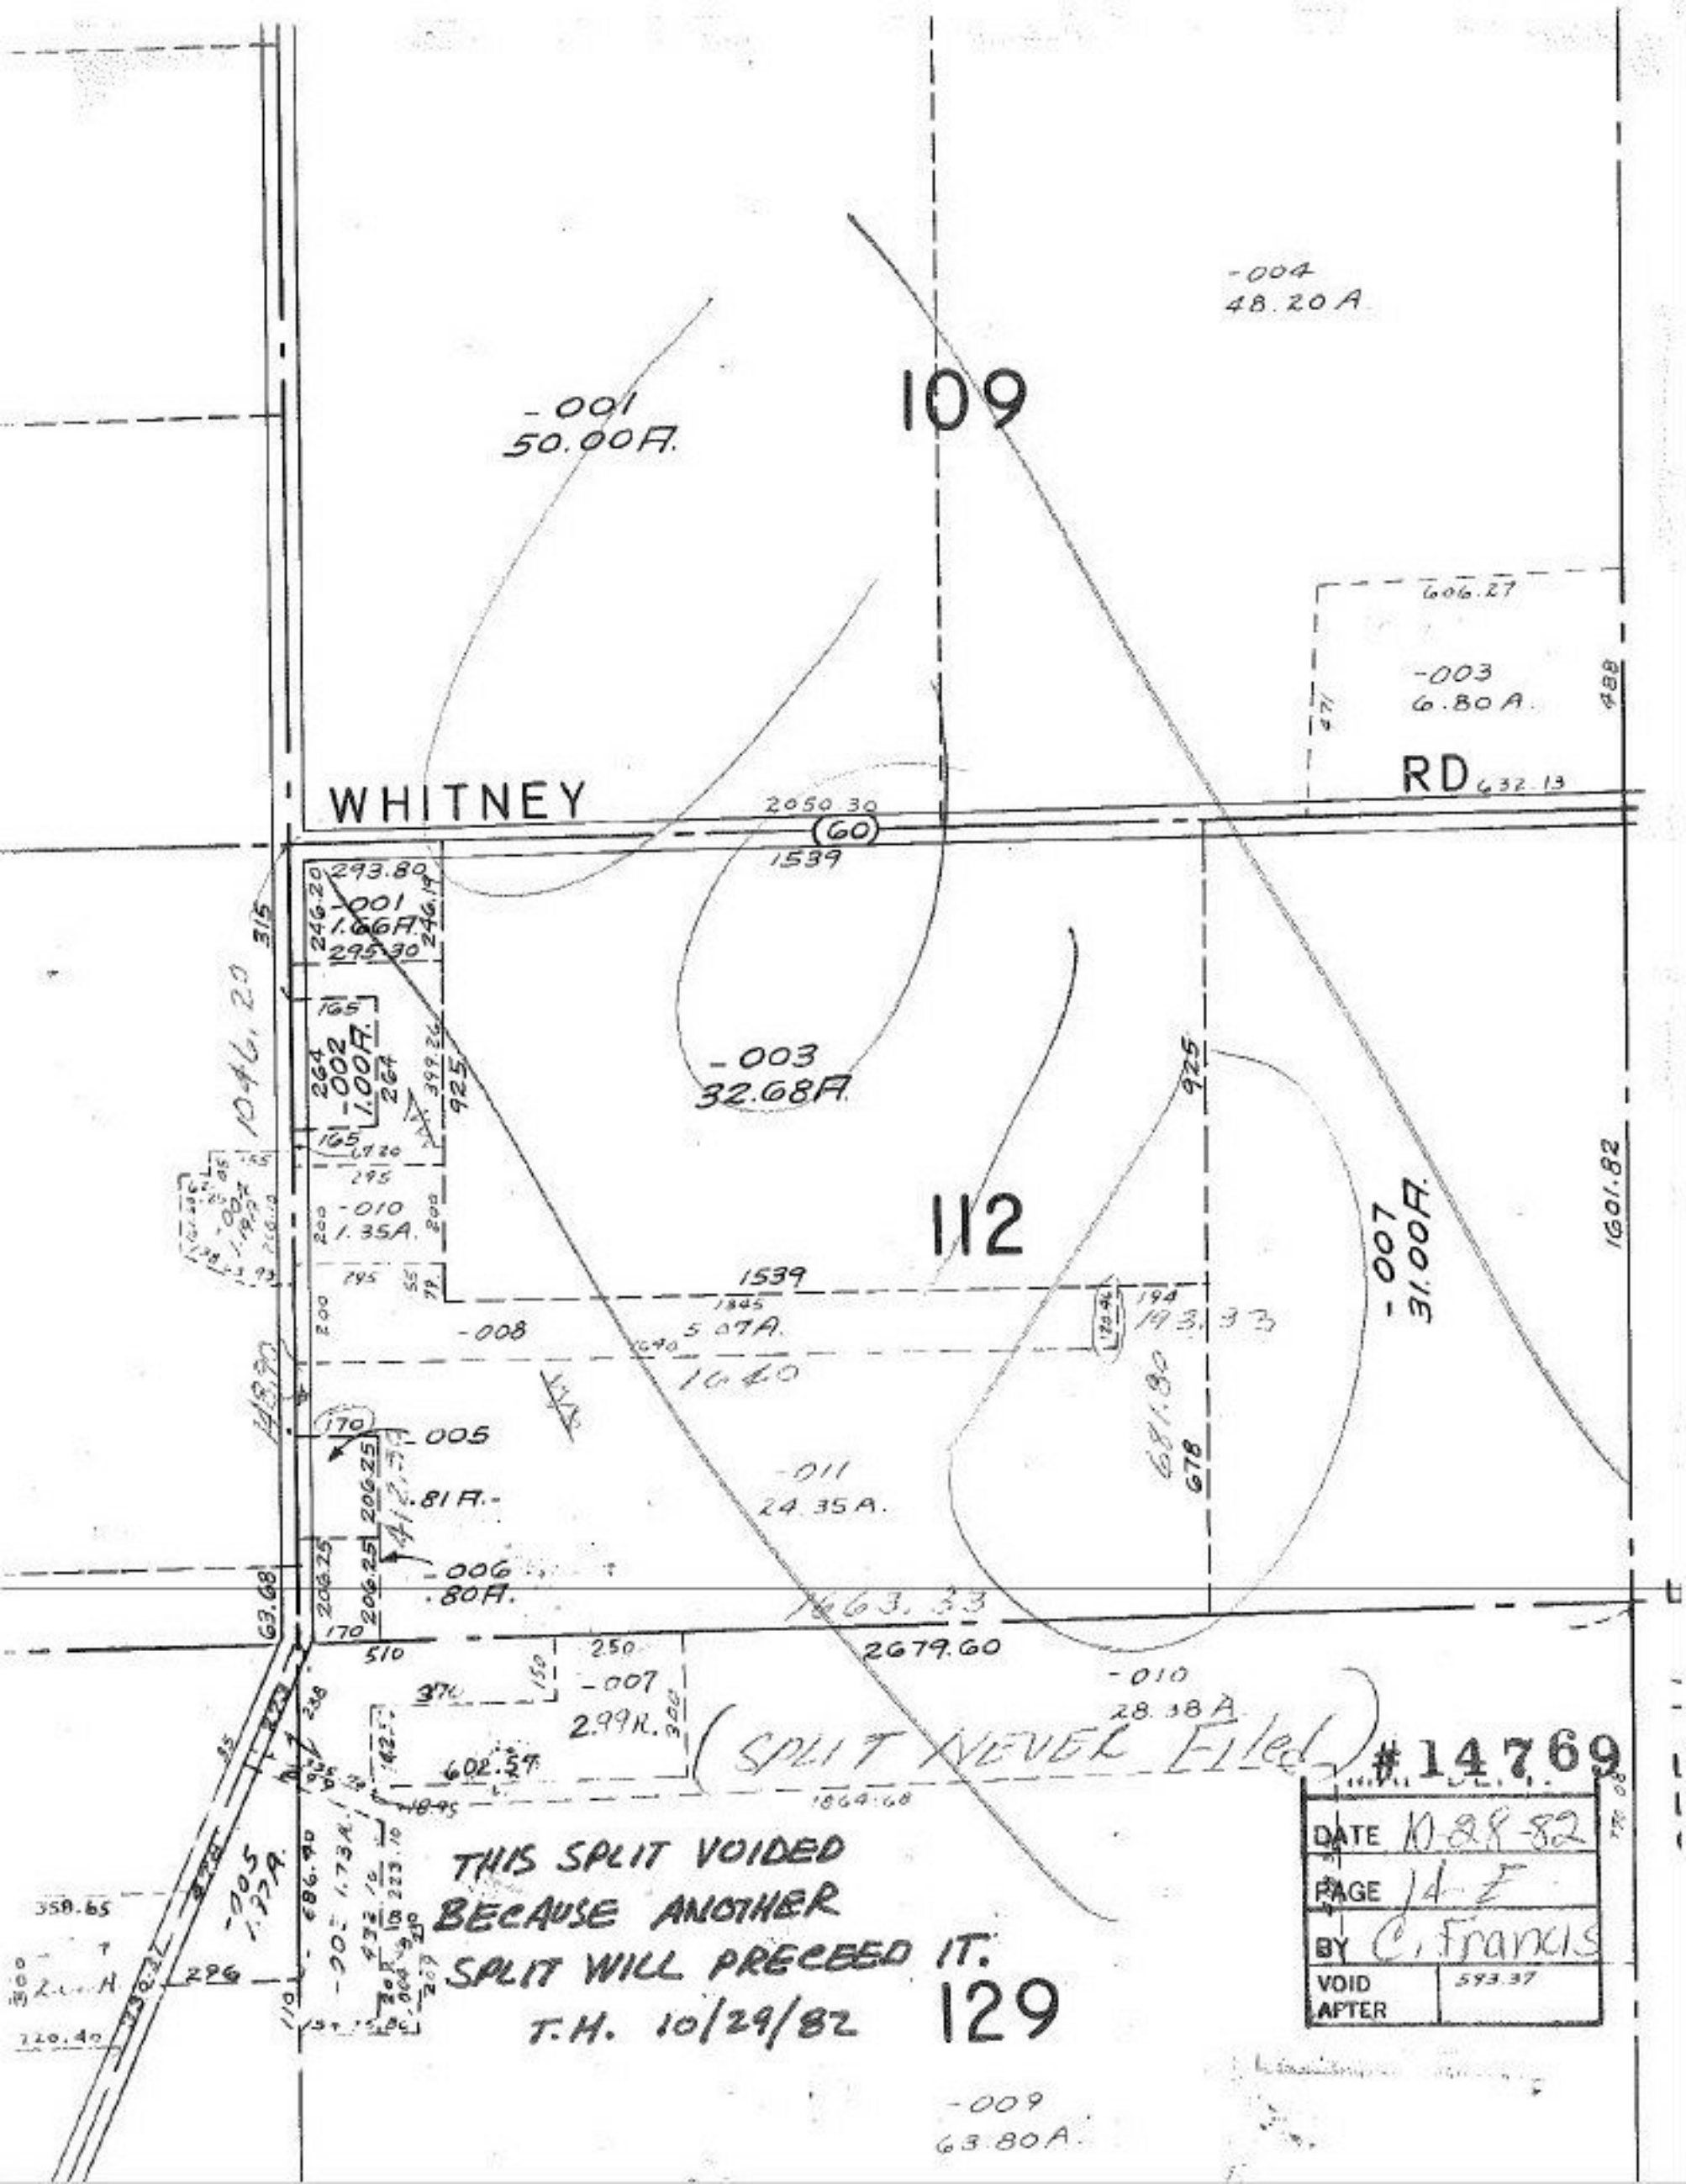

-004
48.20 A
109
-001
50.00A.
606.27
-003
6.80 A.
WHITNEY
RD
632.13
2050.30
(60)
1539
293.80
-001
1.66A.
295.30
-003
32.68A.
112
-010
1.35A.
1539
-008
5.07A.
1640
-007
31.00A.
1601.82
-005
.81A.
-006
.80A.
-011
24.35A.
1663.33
2679.60
-007
2.99A.
602.57
-010
28.38A
(SPLIT NEVER Filed)
#14769
DATE 10-28-82
PAGE 14-E
BY C. Francis
VOID AFTER 593.37
THIS SPLIT VOIDED
BECAUSE ANOTHER
SPLIT WILL PRECEED IT.
T.H. 10/29/82
129
-009
63.80A.