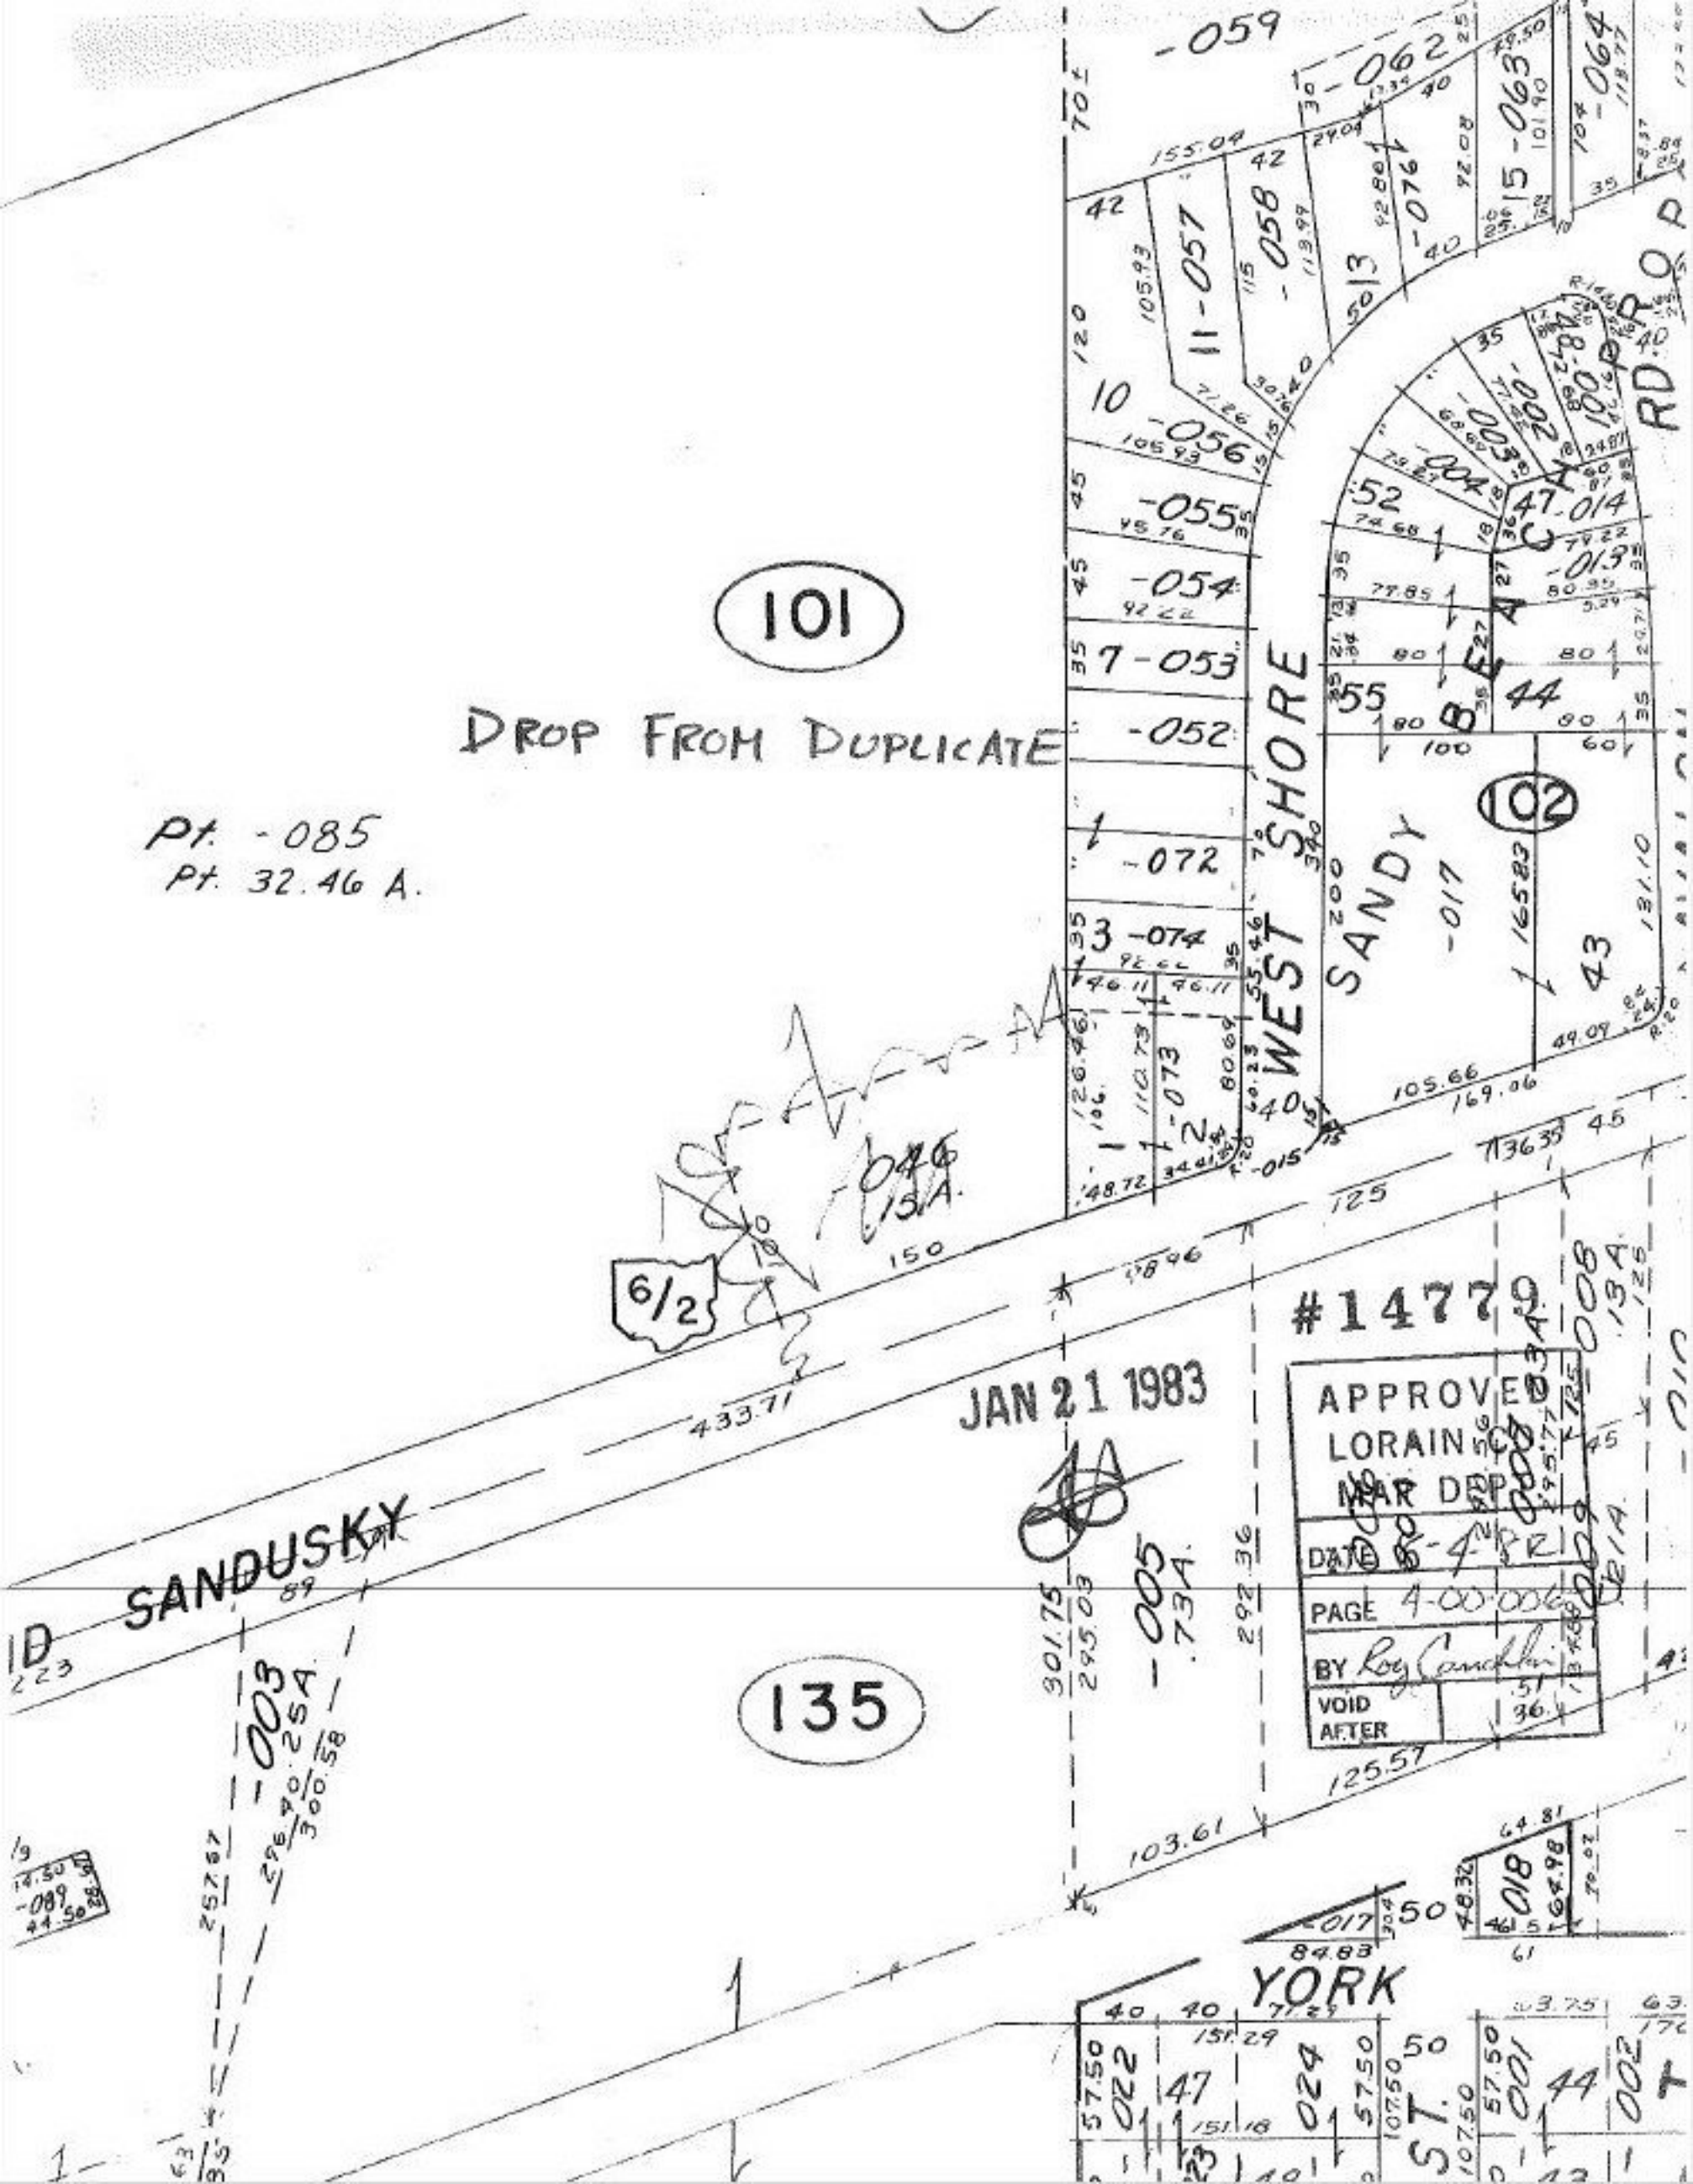

101
DROP FROM DUPLICATE
Pt. -085
Pt. 32.46 A.
WEST SHORE
SANDY BEACH RD. PROP
102
6/2
#14779
JAN 21 1983
APPROVED
LORAIN CO
MAP DEP
DATE 8-4-82
PAGE 4-00-006
BY Roy Candelin
VOID AFTER
SANDUSKY
135
YORK
ST.