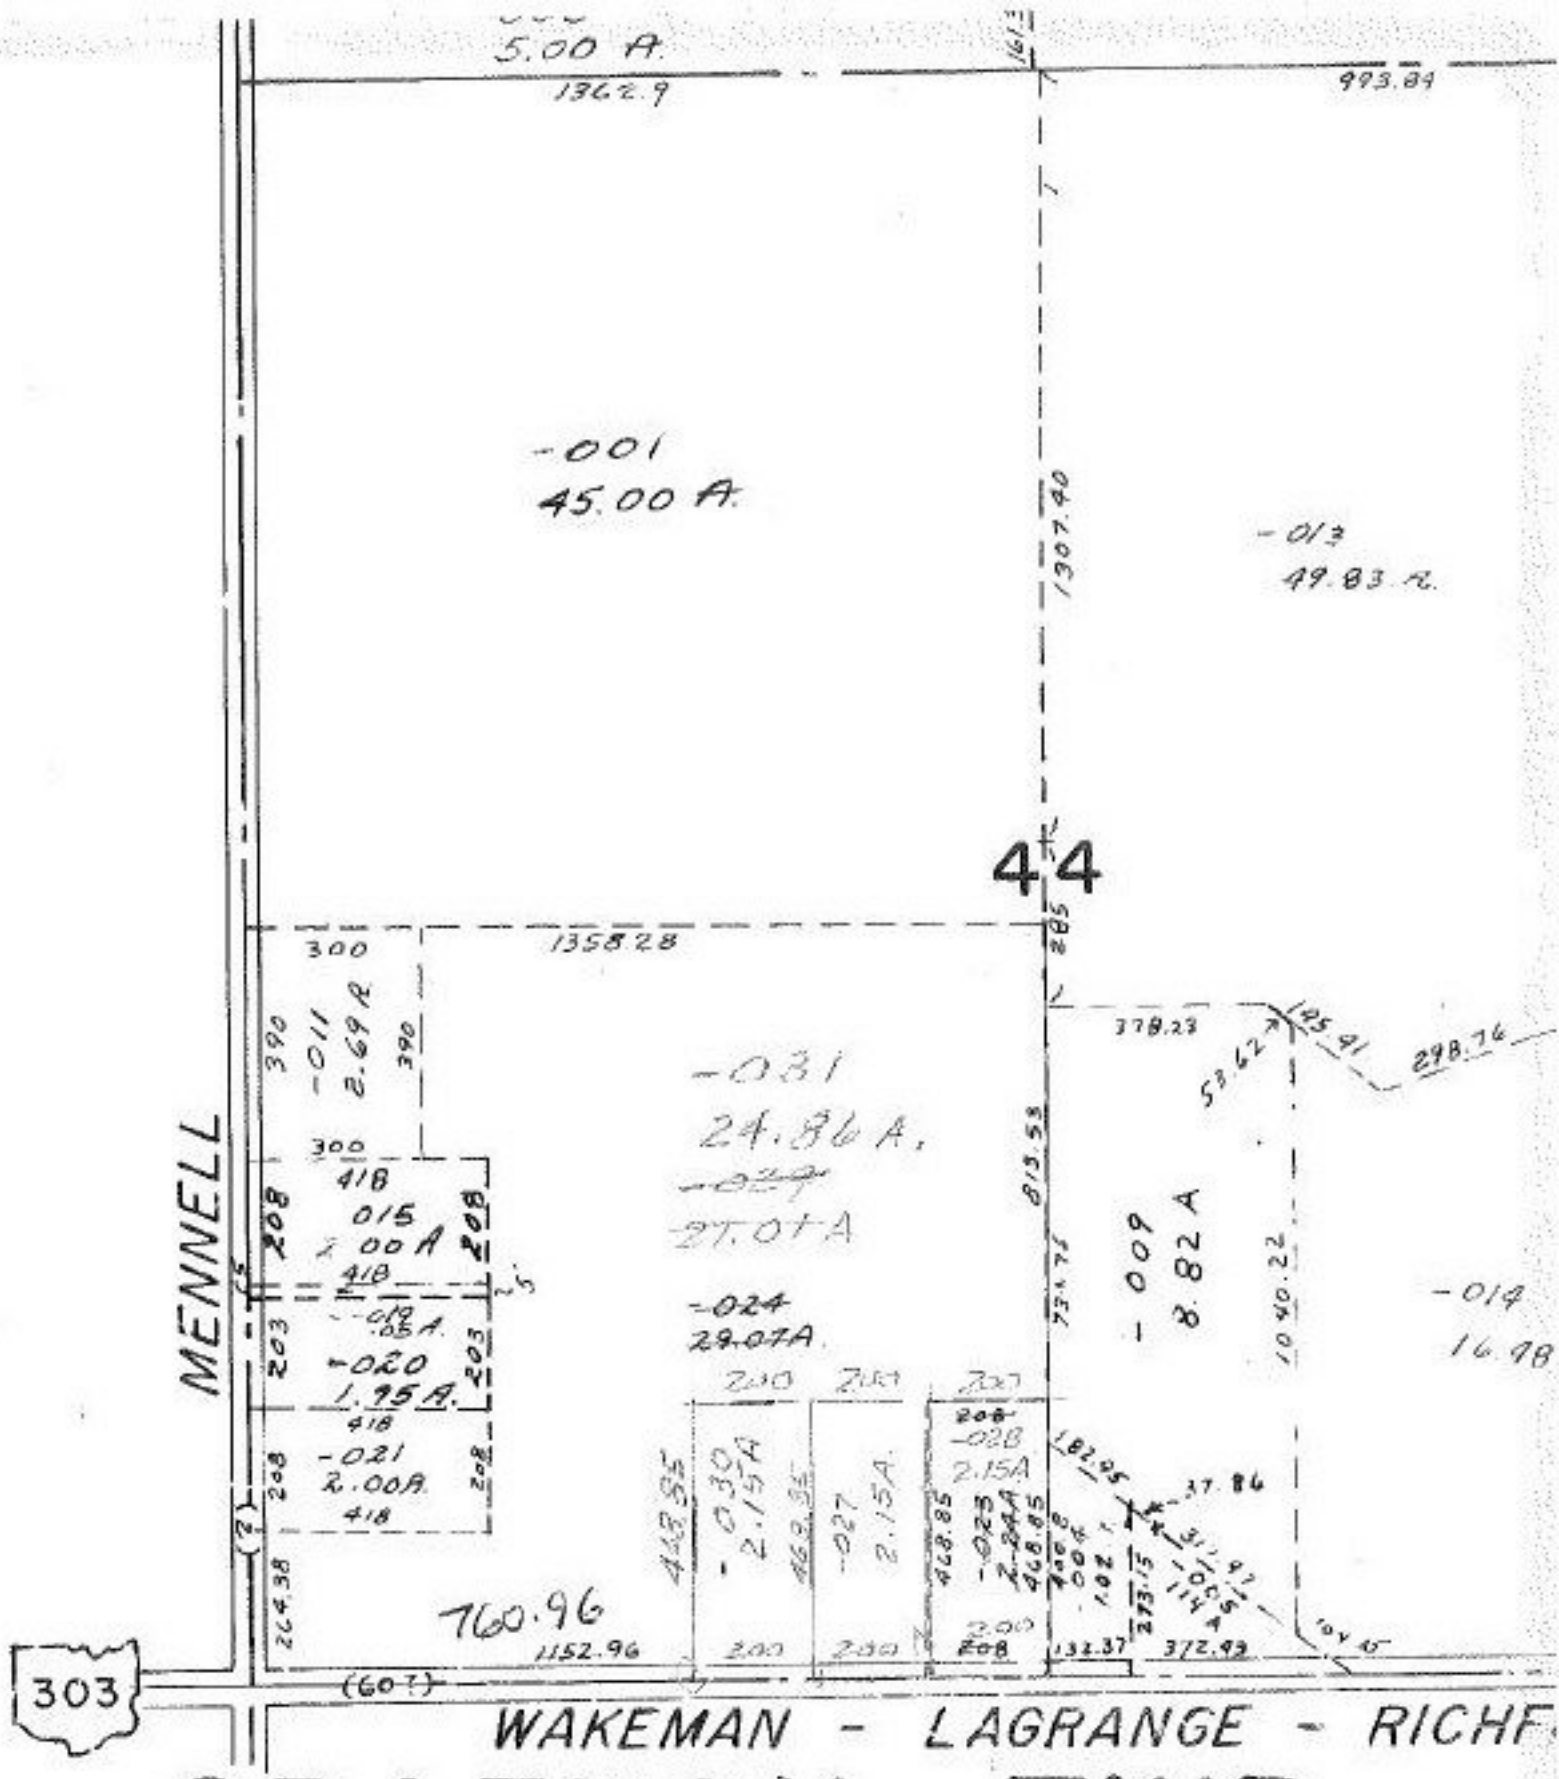

GRAFTON TWP.

SCALE: 1" = 400'

#14794

1152.96
208
1360.96
6
760.96

FEB 25 1983

APPROVED LORAIN CO. MAP DEPT.	
DATE 2-13-92	
PAGE 16-B	
BY [illegible]	
VOID AFTER	