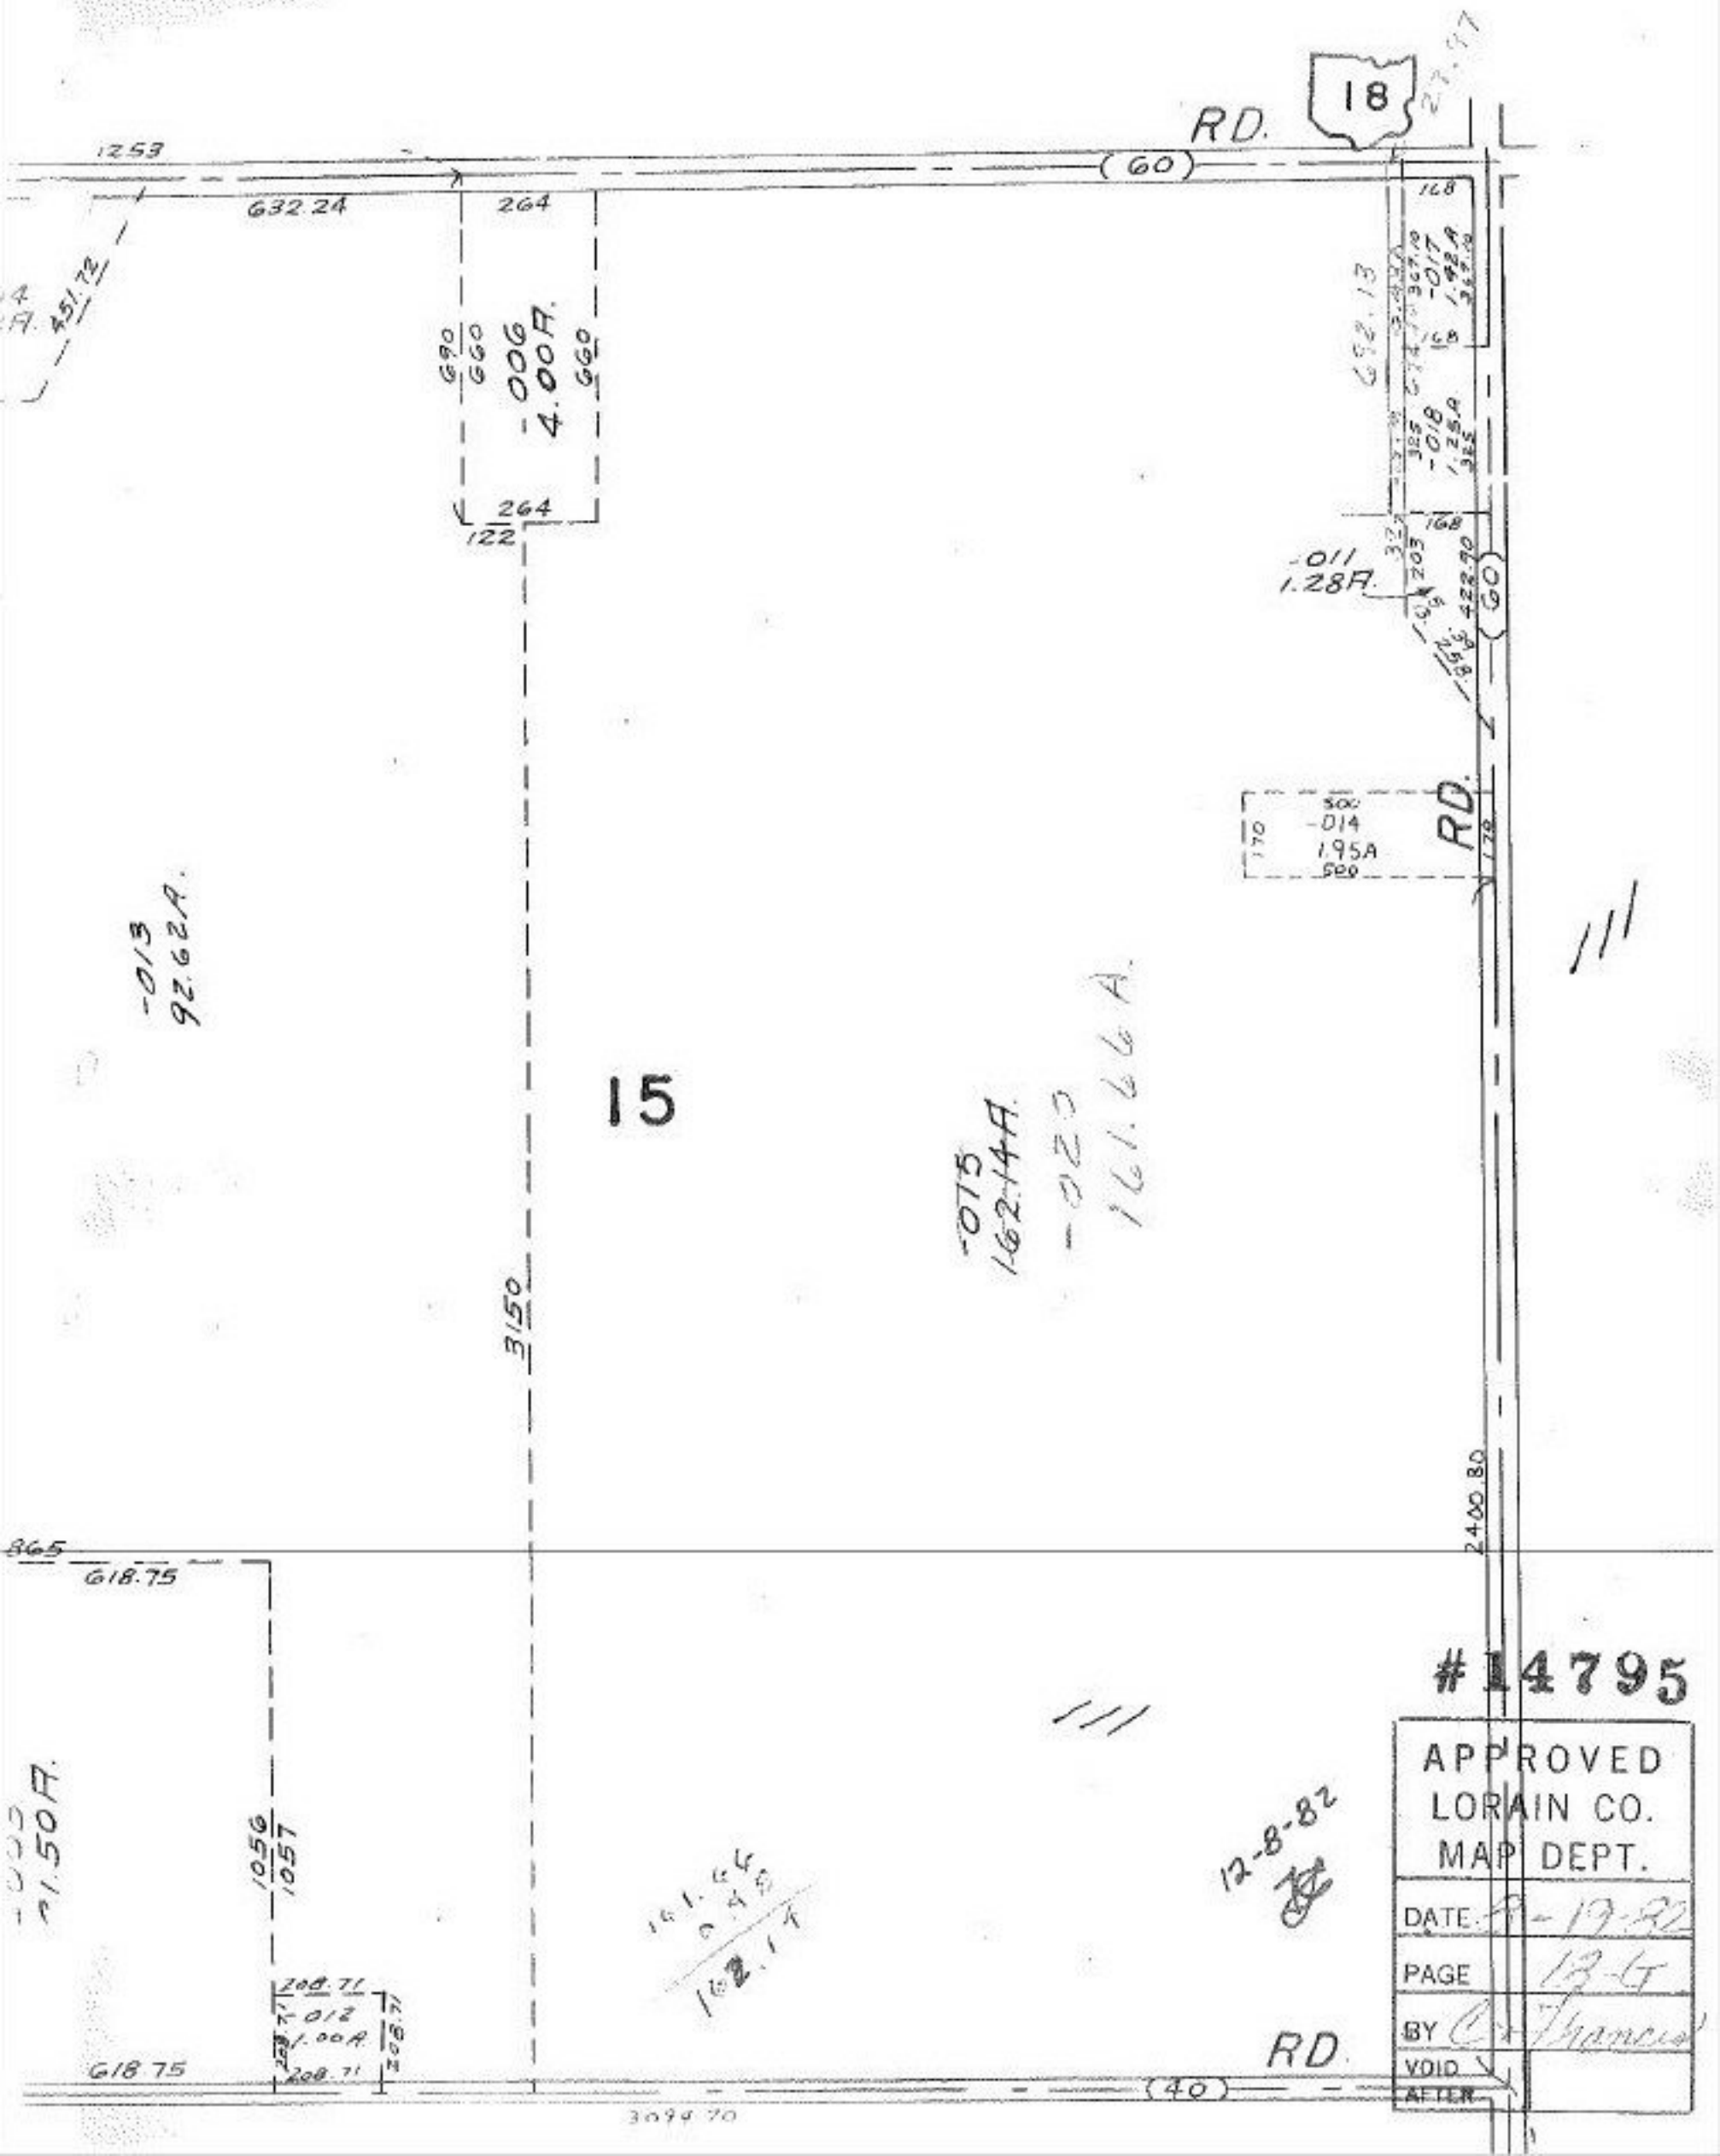

18
RD.
(60)
1253
632.24
264
451.72
690
660
-006
4.00A.
660
264
122
-011
1.28A.
-014
1.95A
500
RD.
-013
92.62A.
15
-015
162.14A.
-020
161.66A.
3150
2400.80
865
618.75
1056
1057
-012
1.00A.
208.71
618.75
RD.
(40)
3094.70
12-8-82
#14795
APPROVED
LORAIN CO.
MAP DEPT.
DATE
PAGE
BY
VOID
AFTER