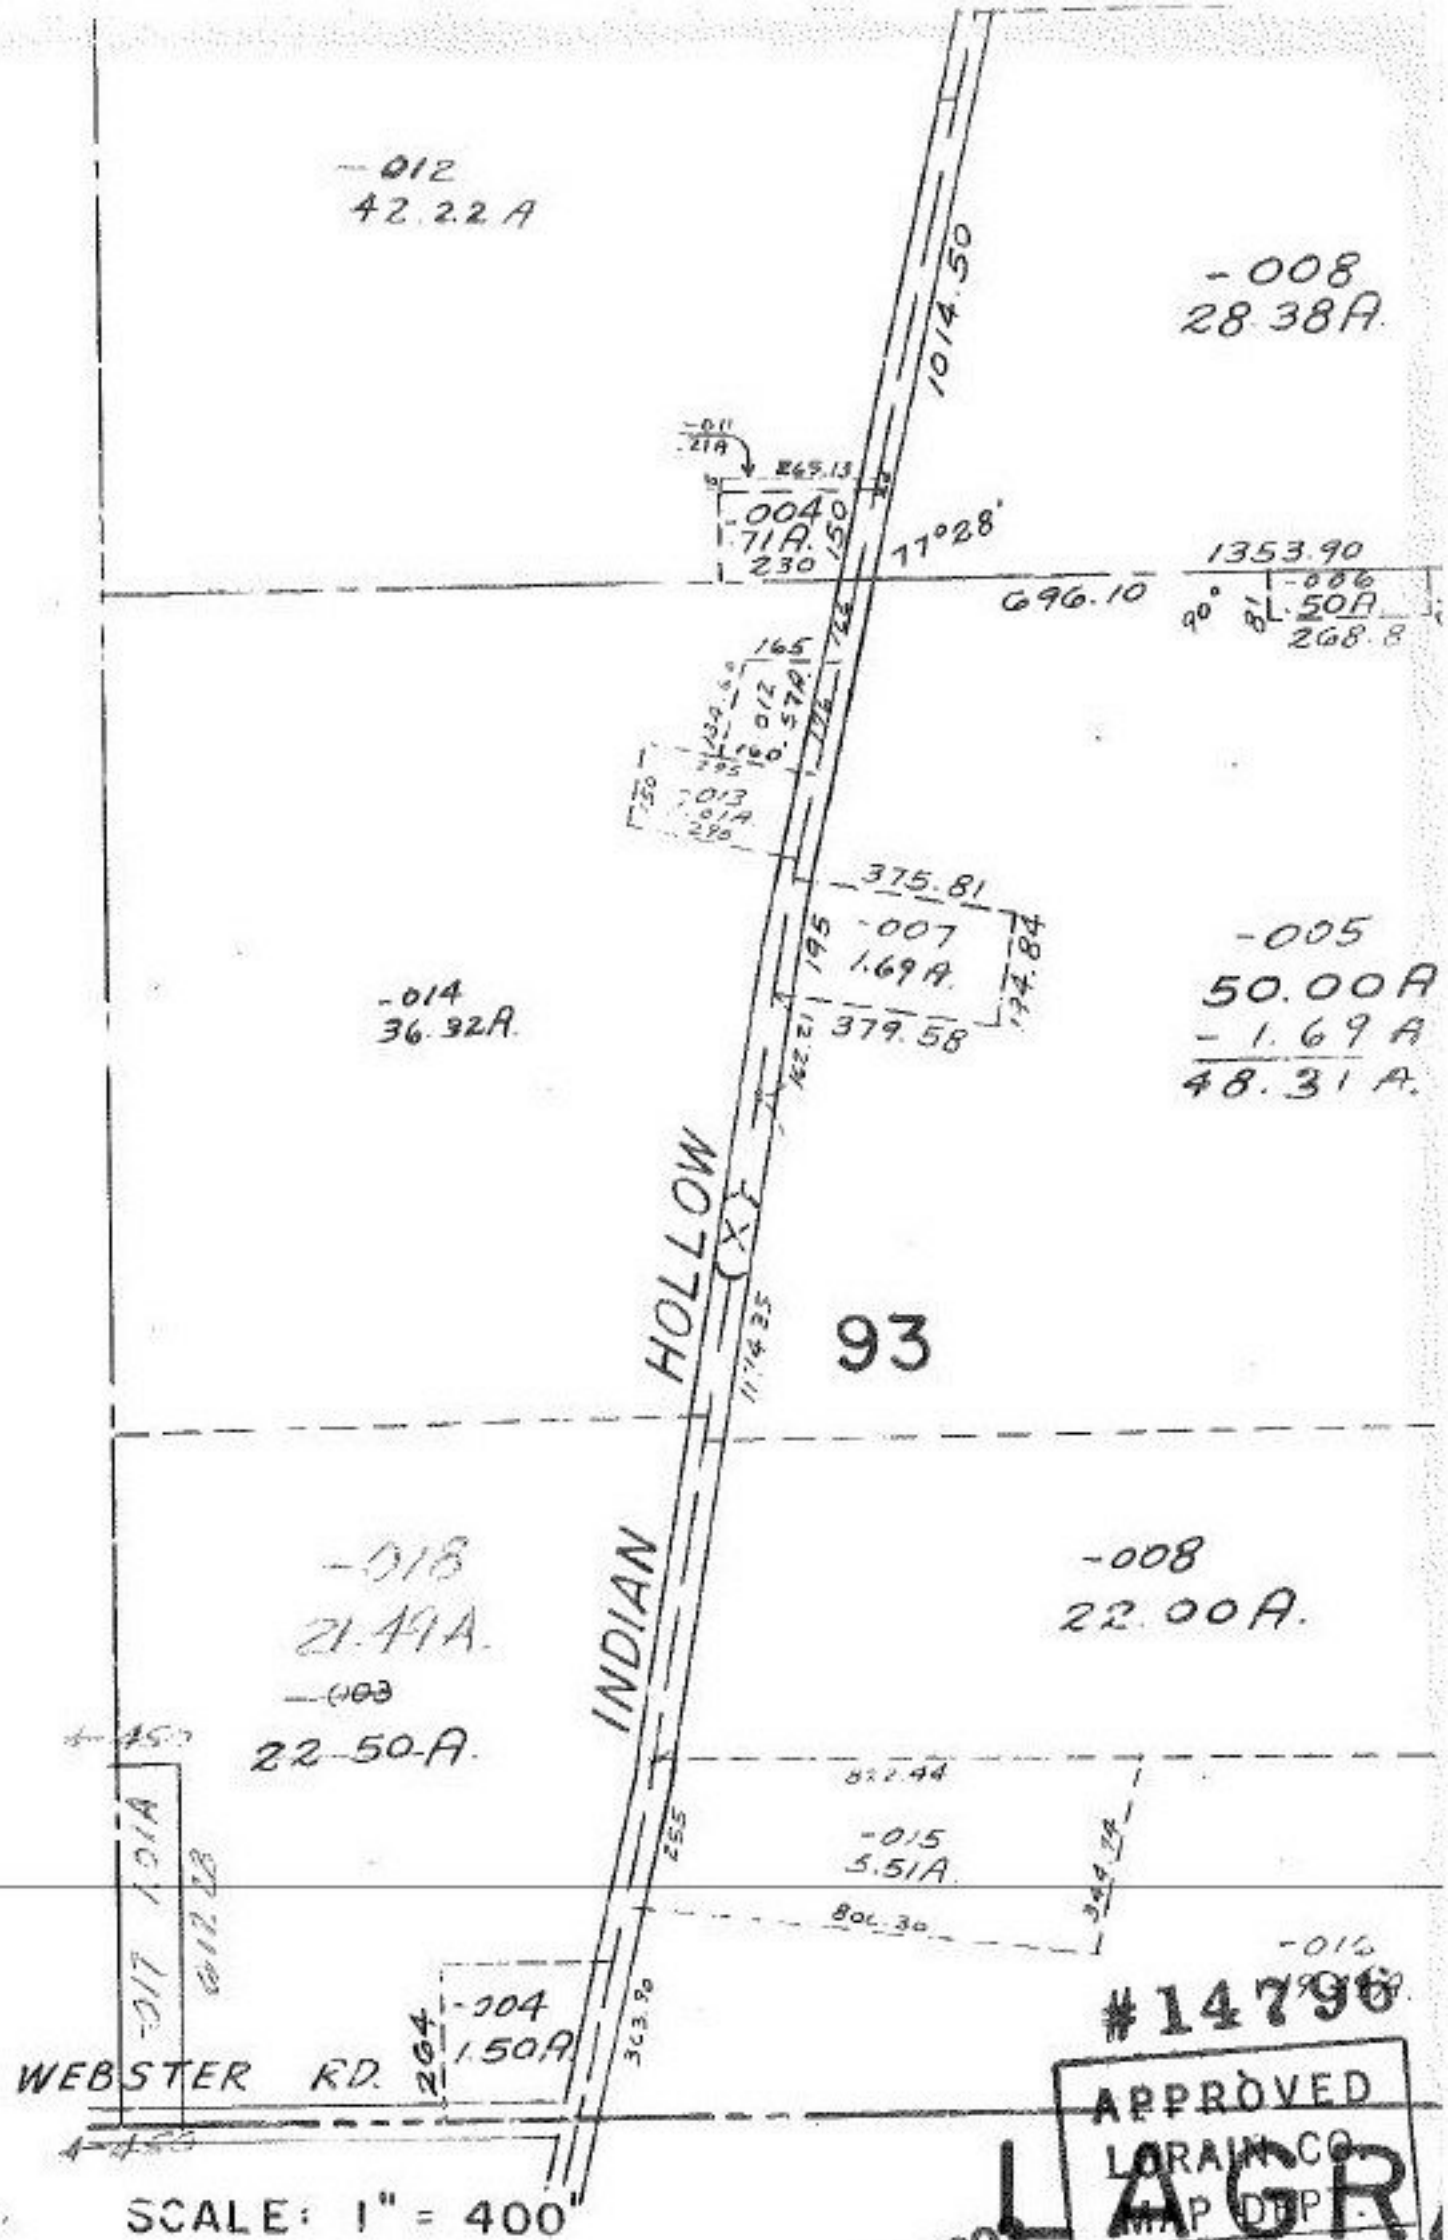

Surveyed By:

Gary E. Penfound

Closure #: P: 1,000,000.00

#14796

APPROVED
LORAIN CO.
MAP DEPT.
DATE 8-19-82
PAGE 15-11
BY C. Francis
VOID AFTER

FEB 25 1983

LAGR