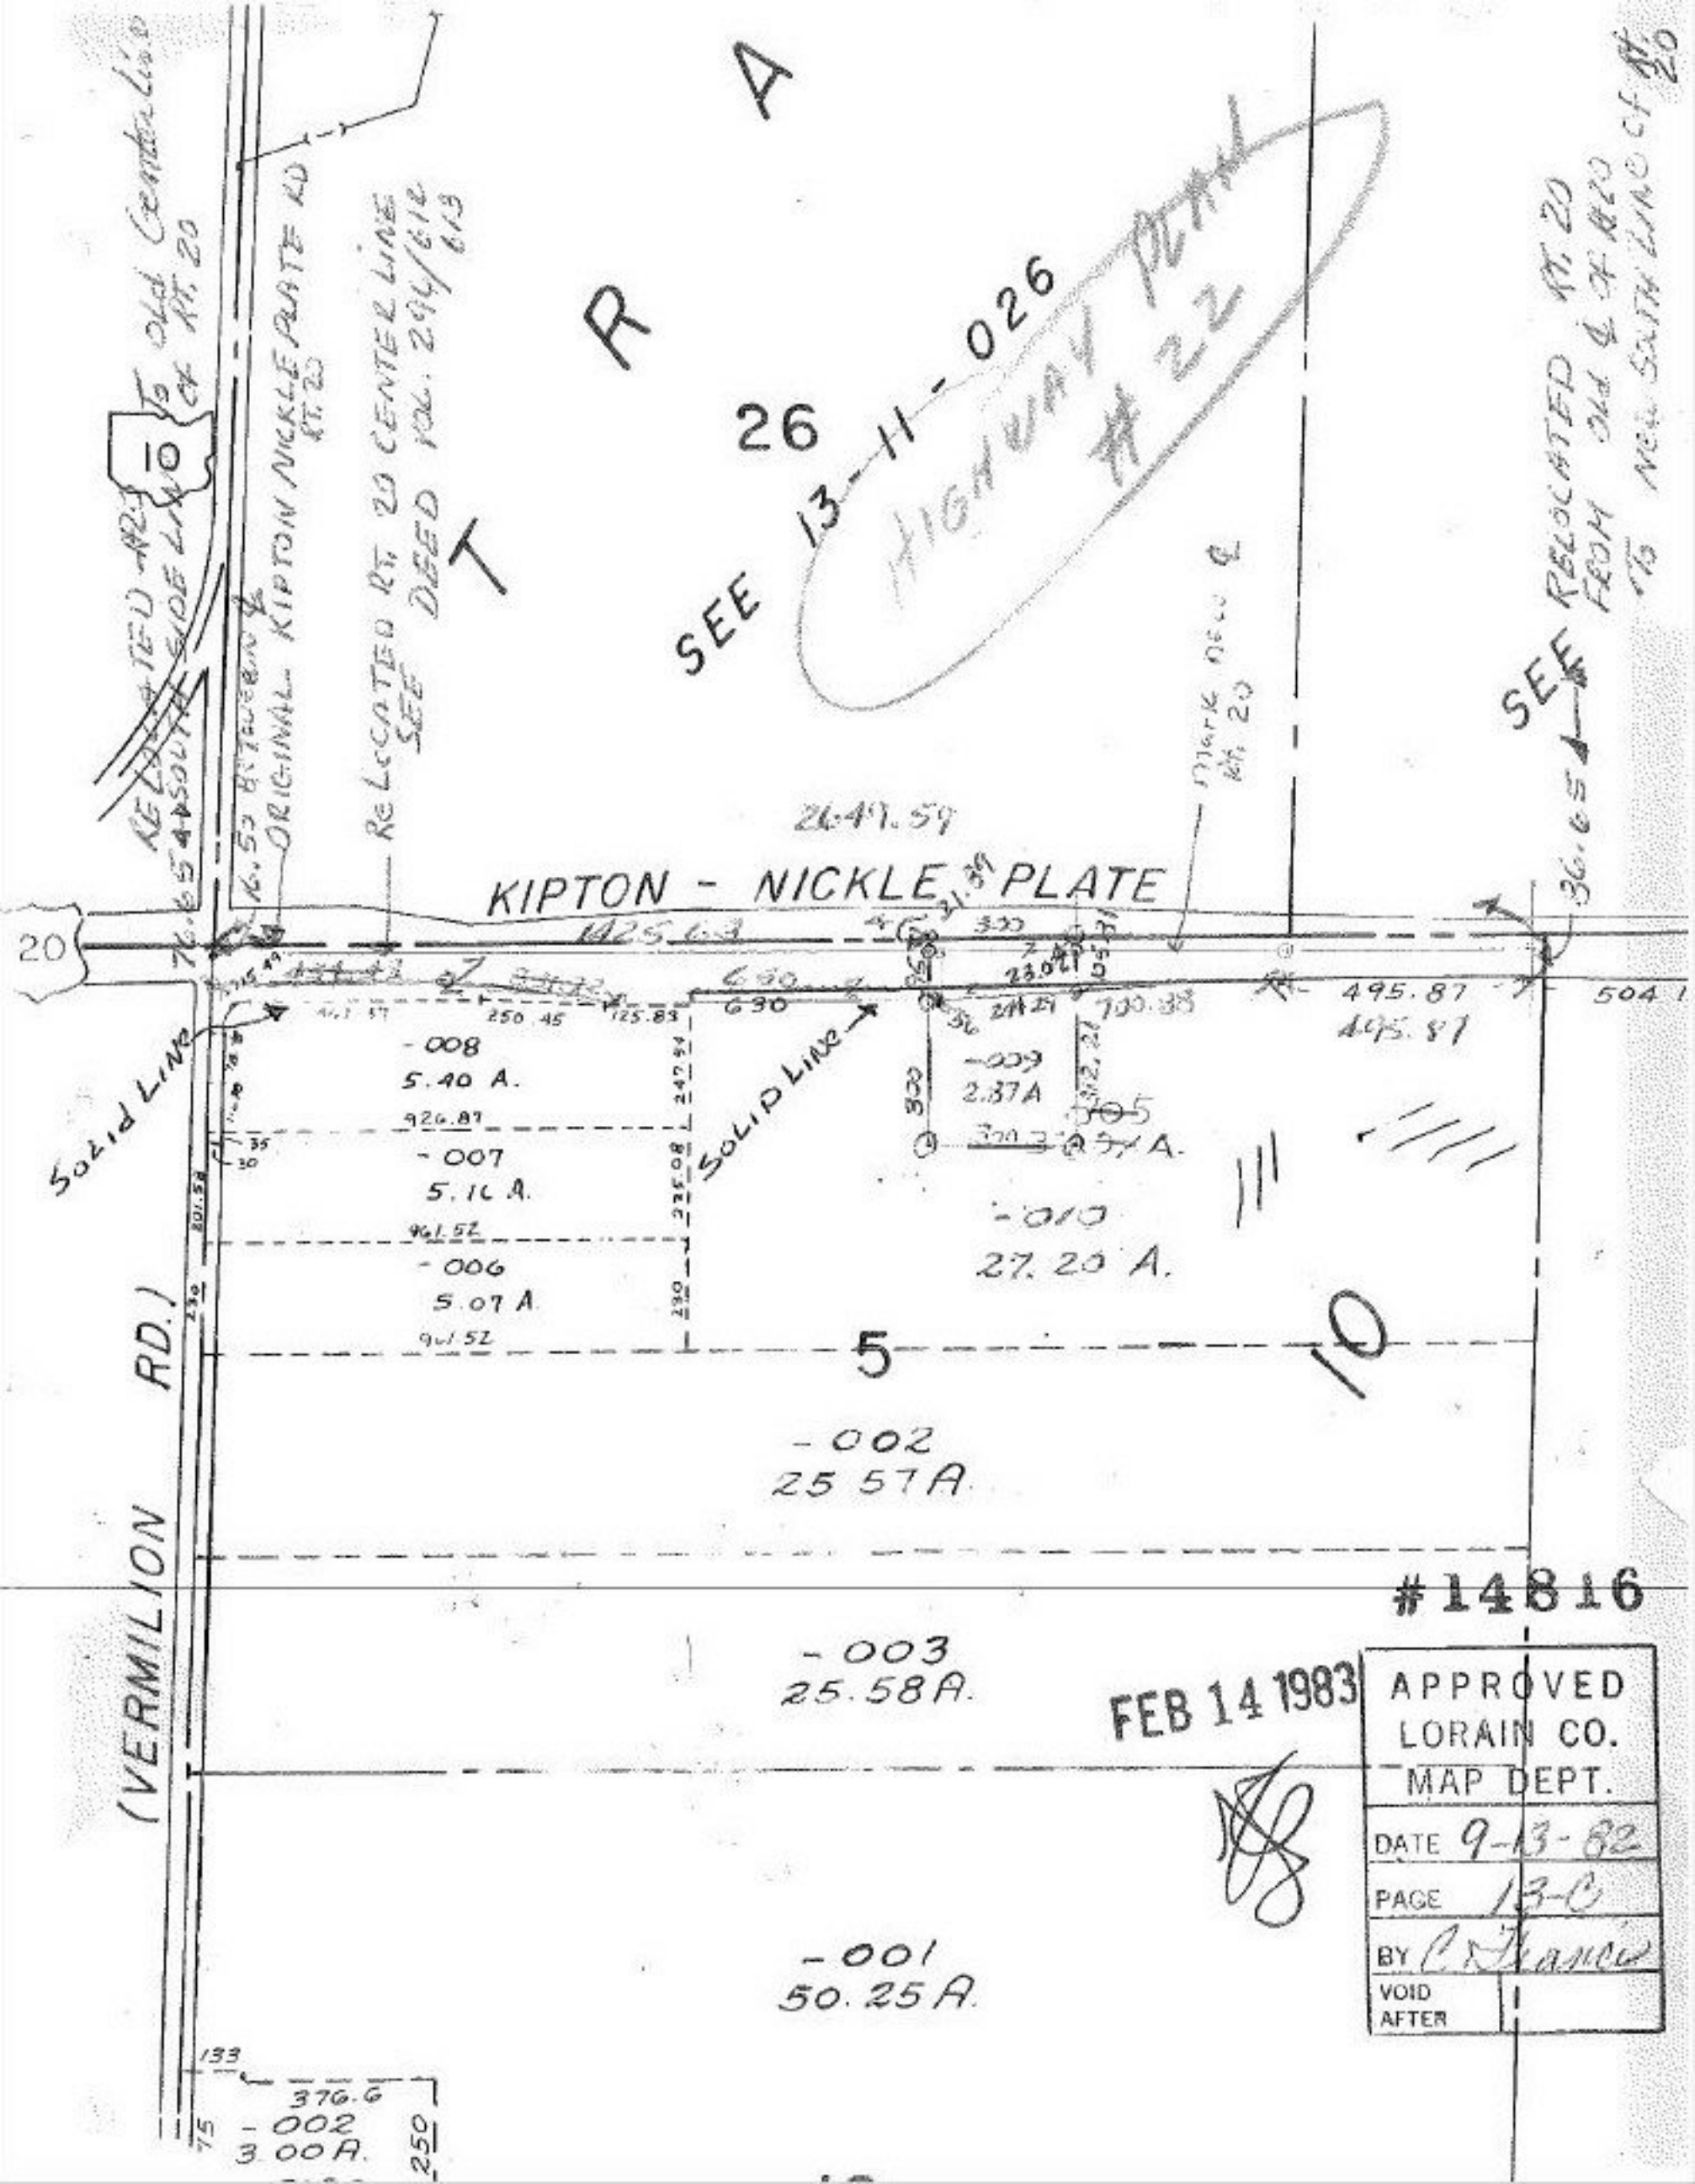

#14816

FEB 14 1983

APPROVED
LORAIN CO.
MAP DEPT.
DATE 9-13-82
PAGE 13-C
BY C. Francis
VOID AFTER