821-9

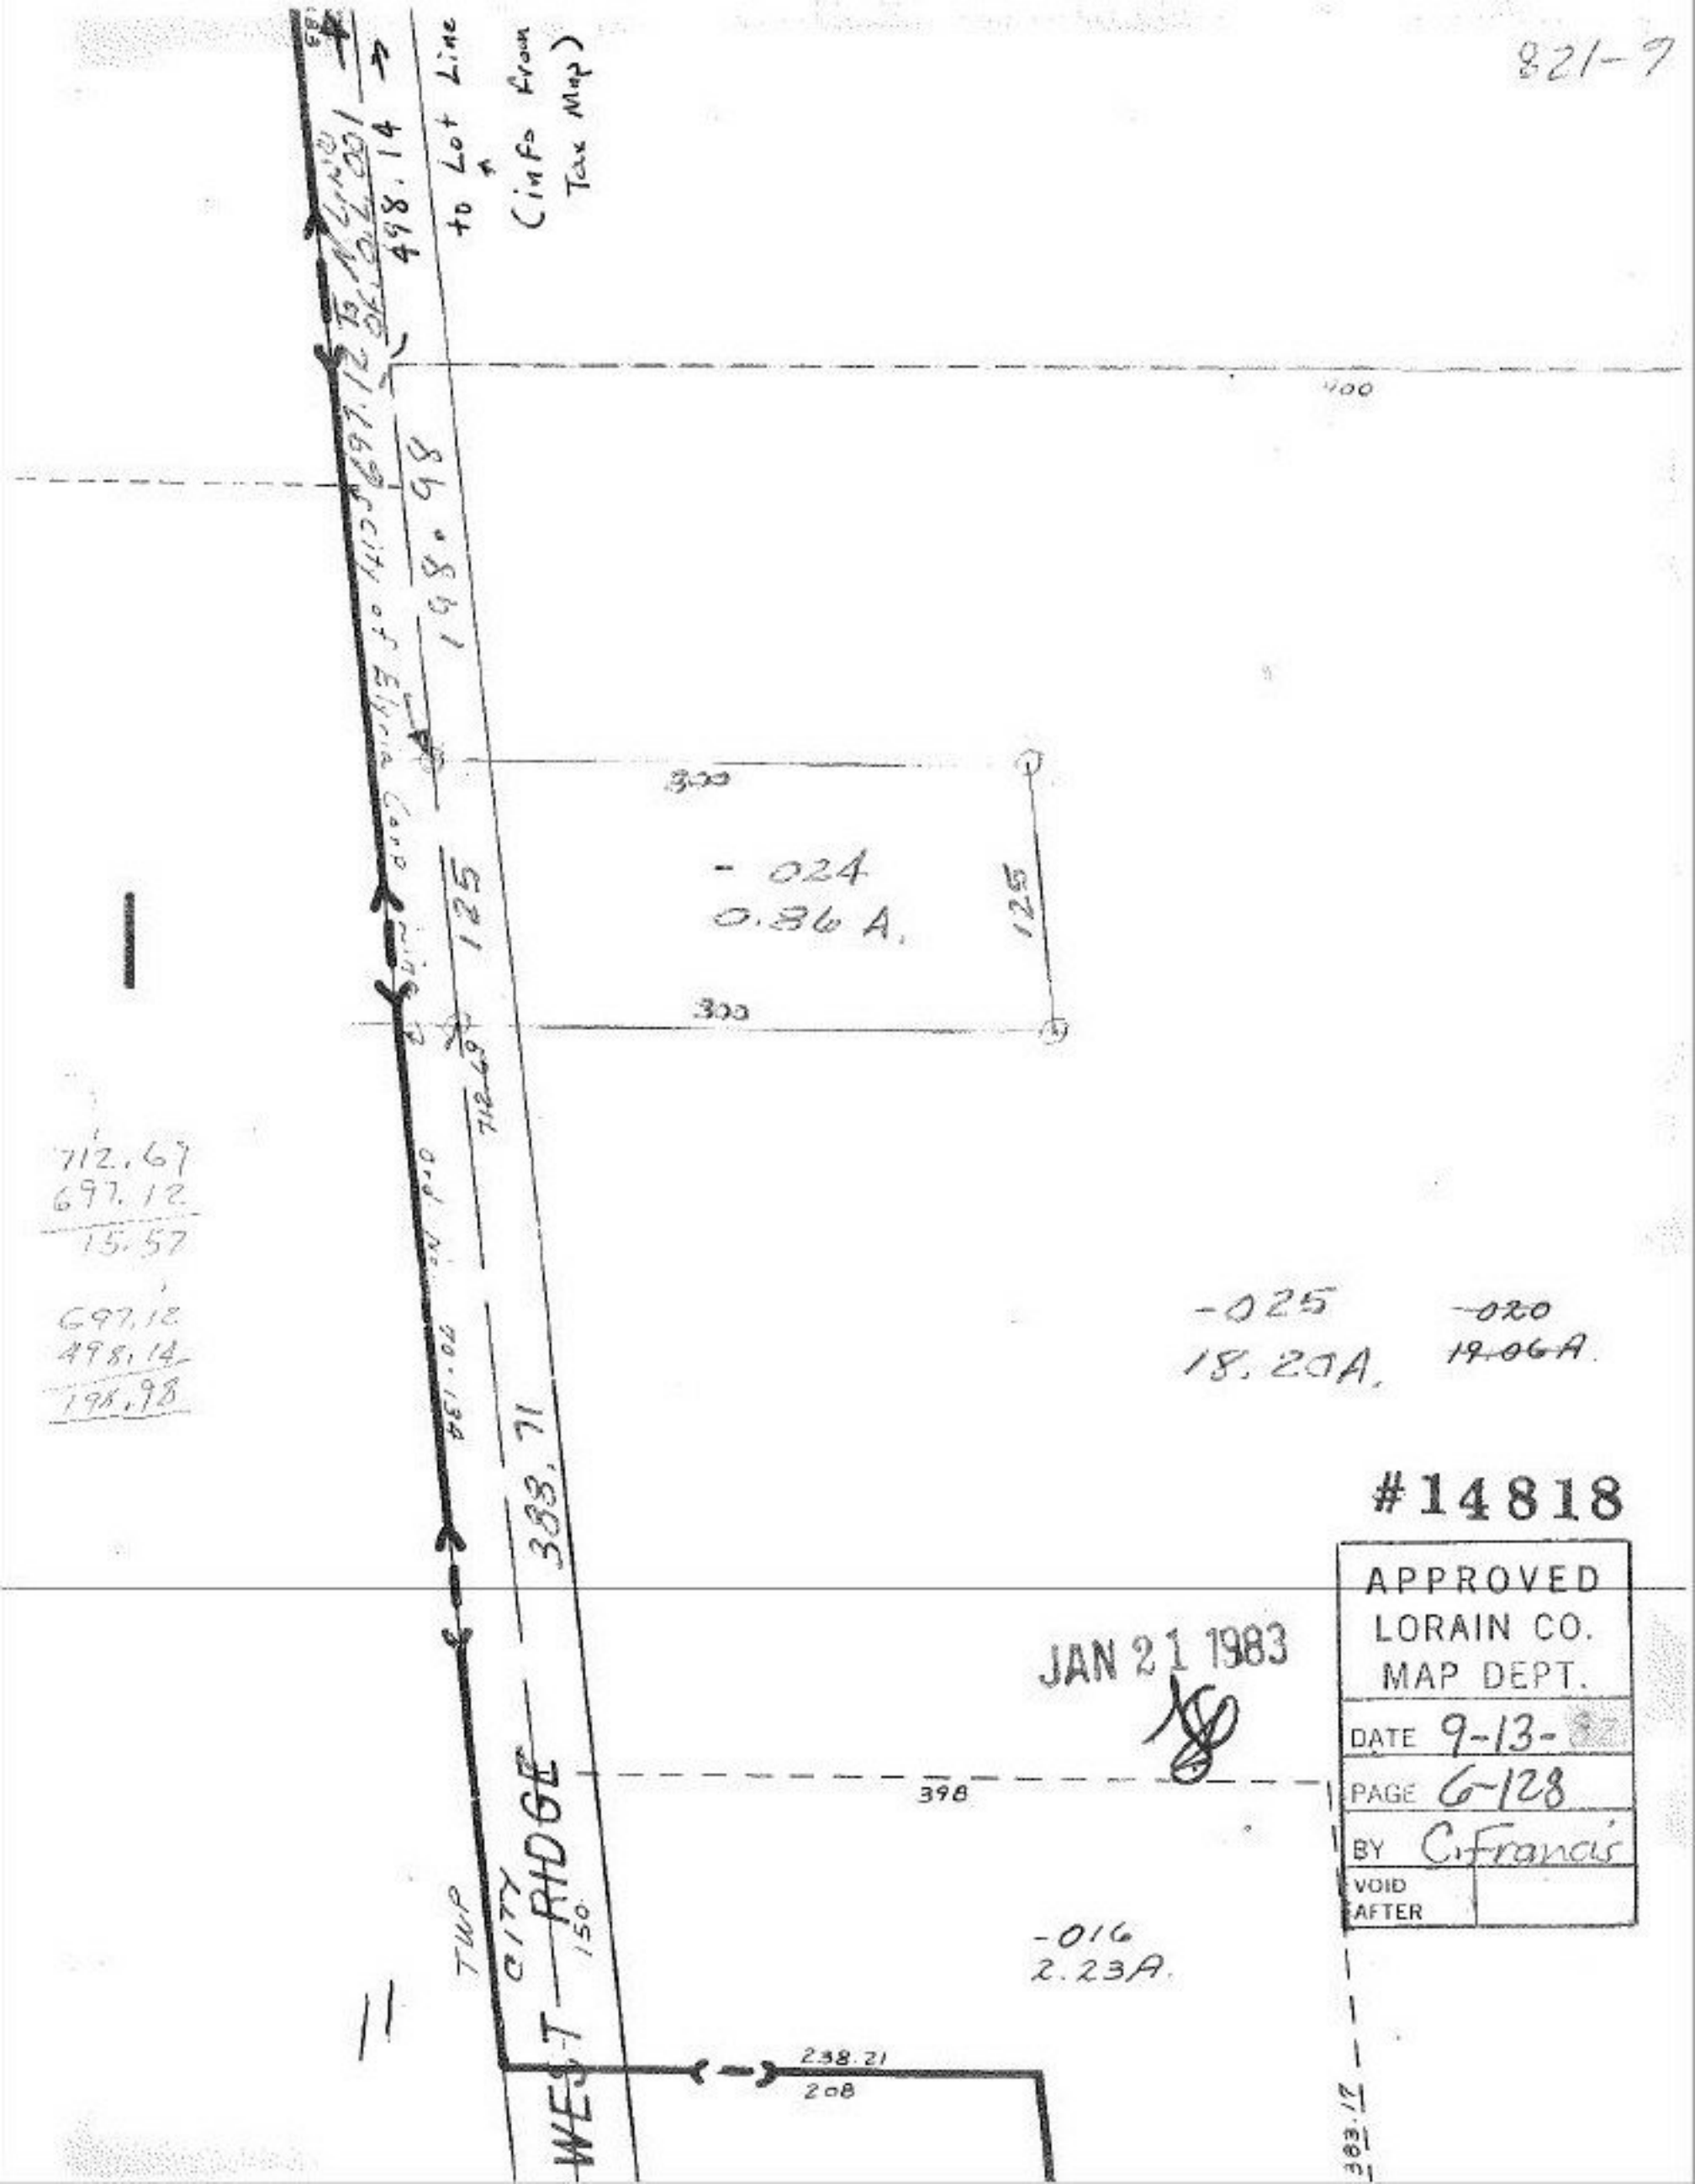

498.14
to Lot Line
(info from Tax Map)
697.12 To N. Line of O.L. 001
198.98
400
300
- 024
0.86 A.
125
300
712.69
712.69
697.12
15.57
697.12
498.14
198.98
-025
18.20A.
-020
19.06A.
383.71
#14818
APPROVED
LORAIN CO.
MAP DEPT.
DATE 9-13-
PAGE 6-128
BY C. Francis
VOID AFTER
JAN 21 1983
398
TWP
CITY
WEST RIDGE
150
-016
2.23A.
238.21
208
383.17