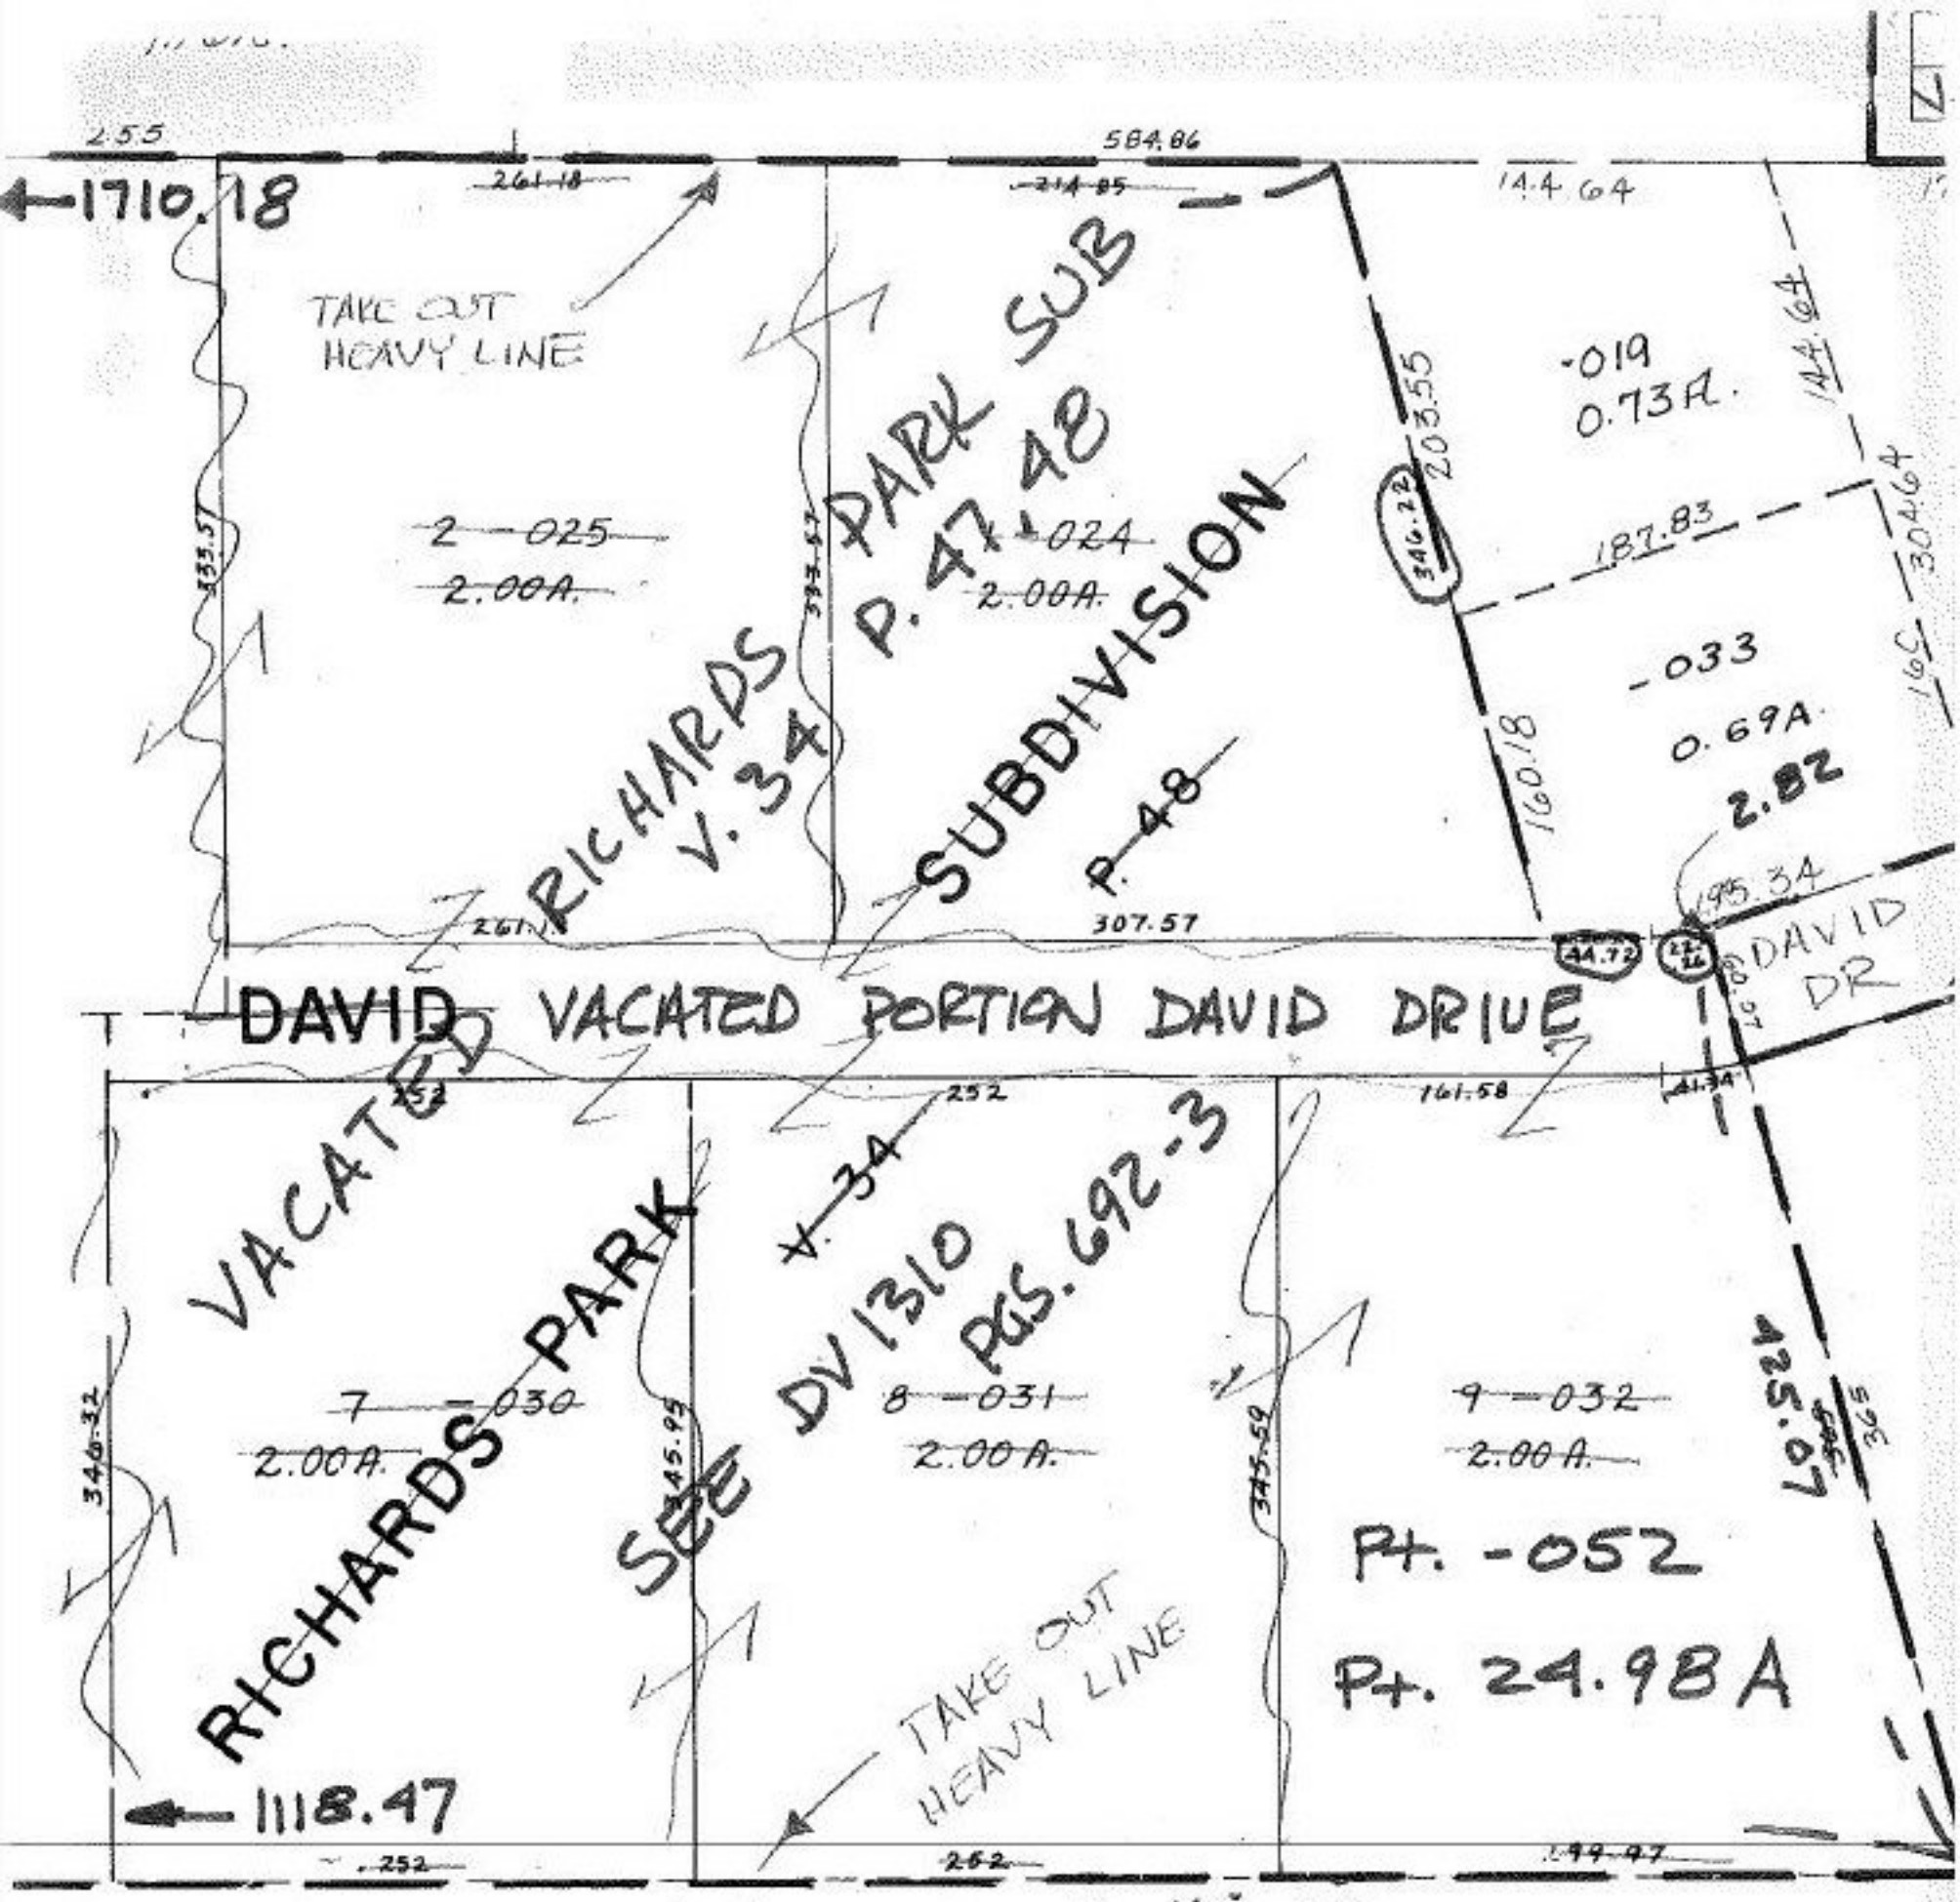

#14819

APPROVED
LORAIN CO.
MAP DEPT.
DATE 6.14.83
PAGE 6-65
BY T.M. Nair
VOID AFTER

5.4.84
T.M.

101

29