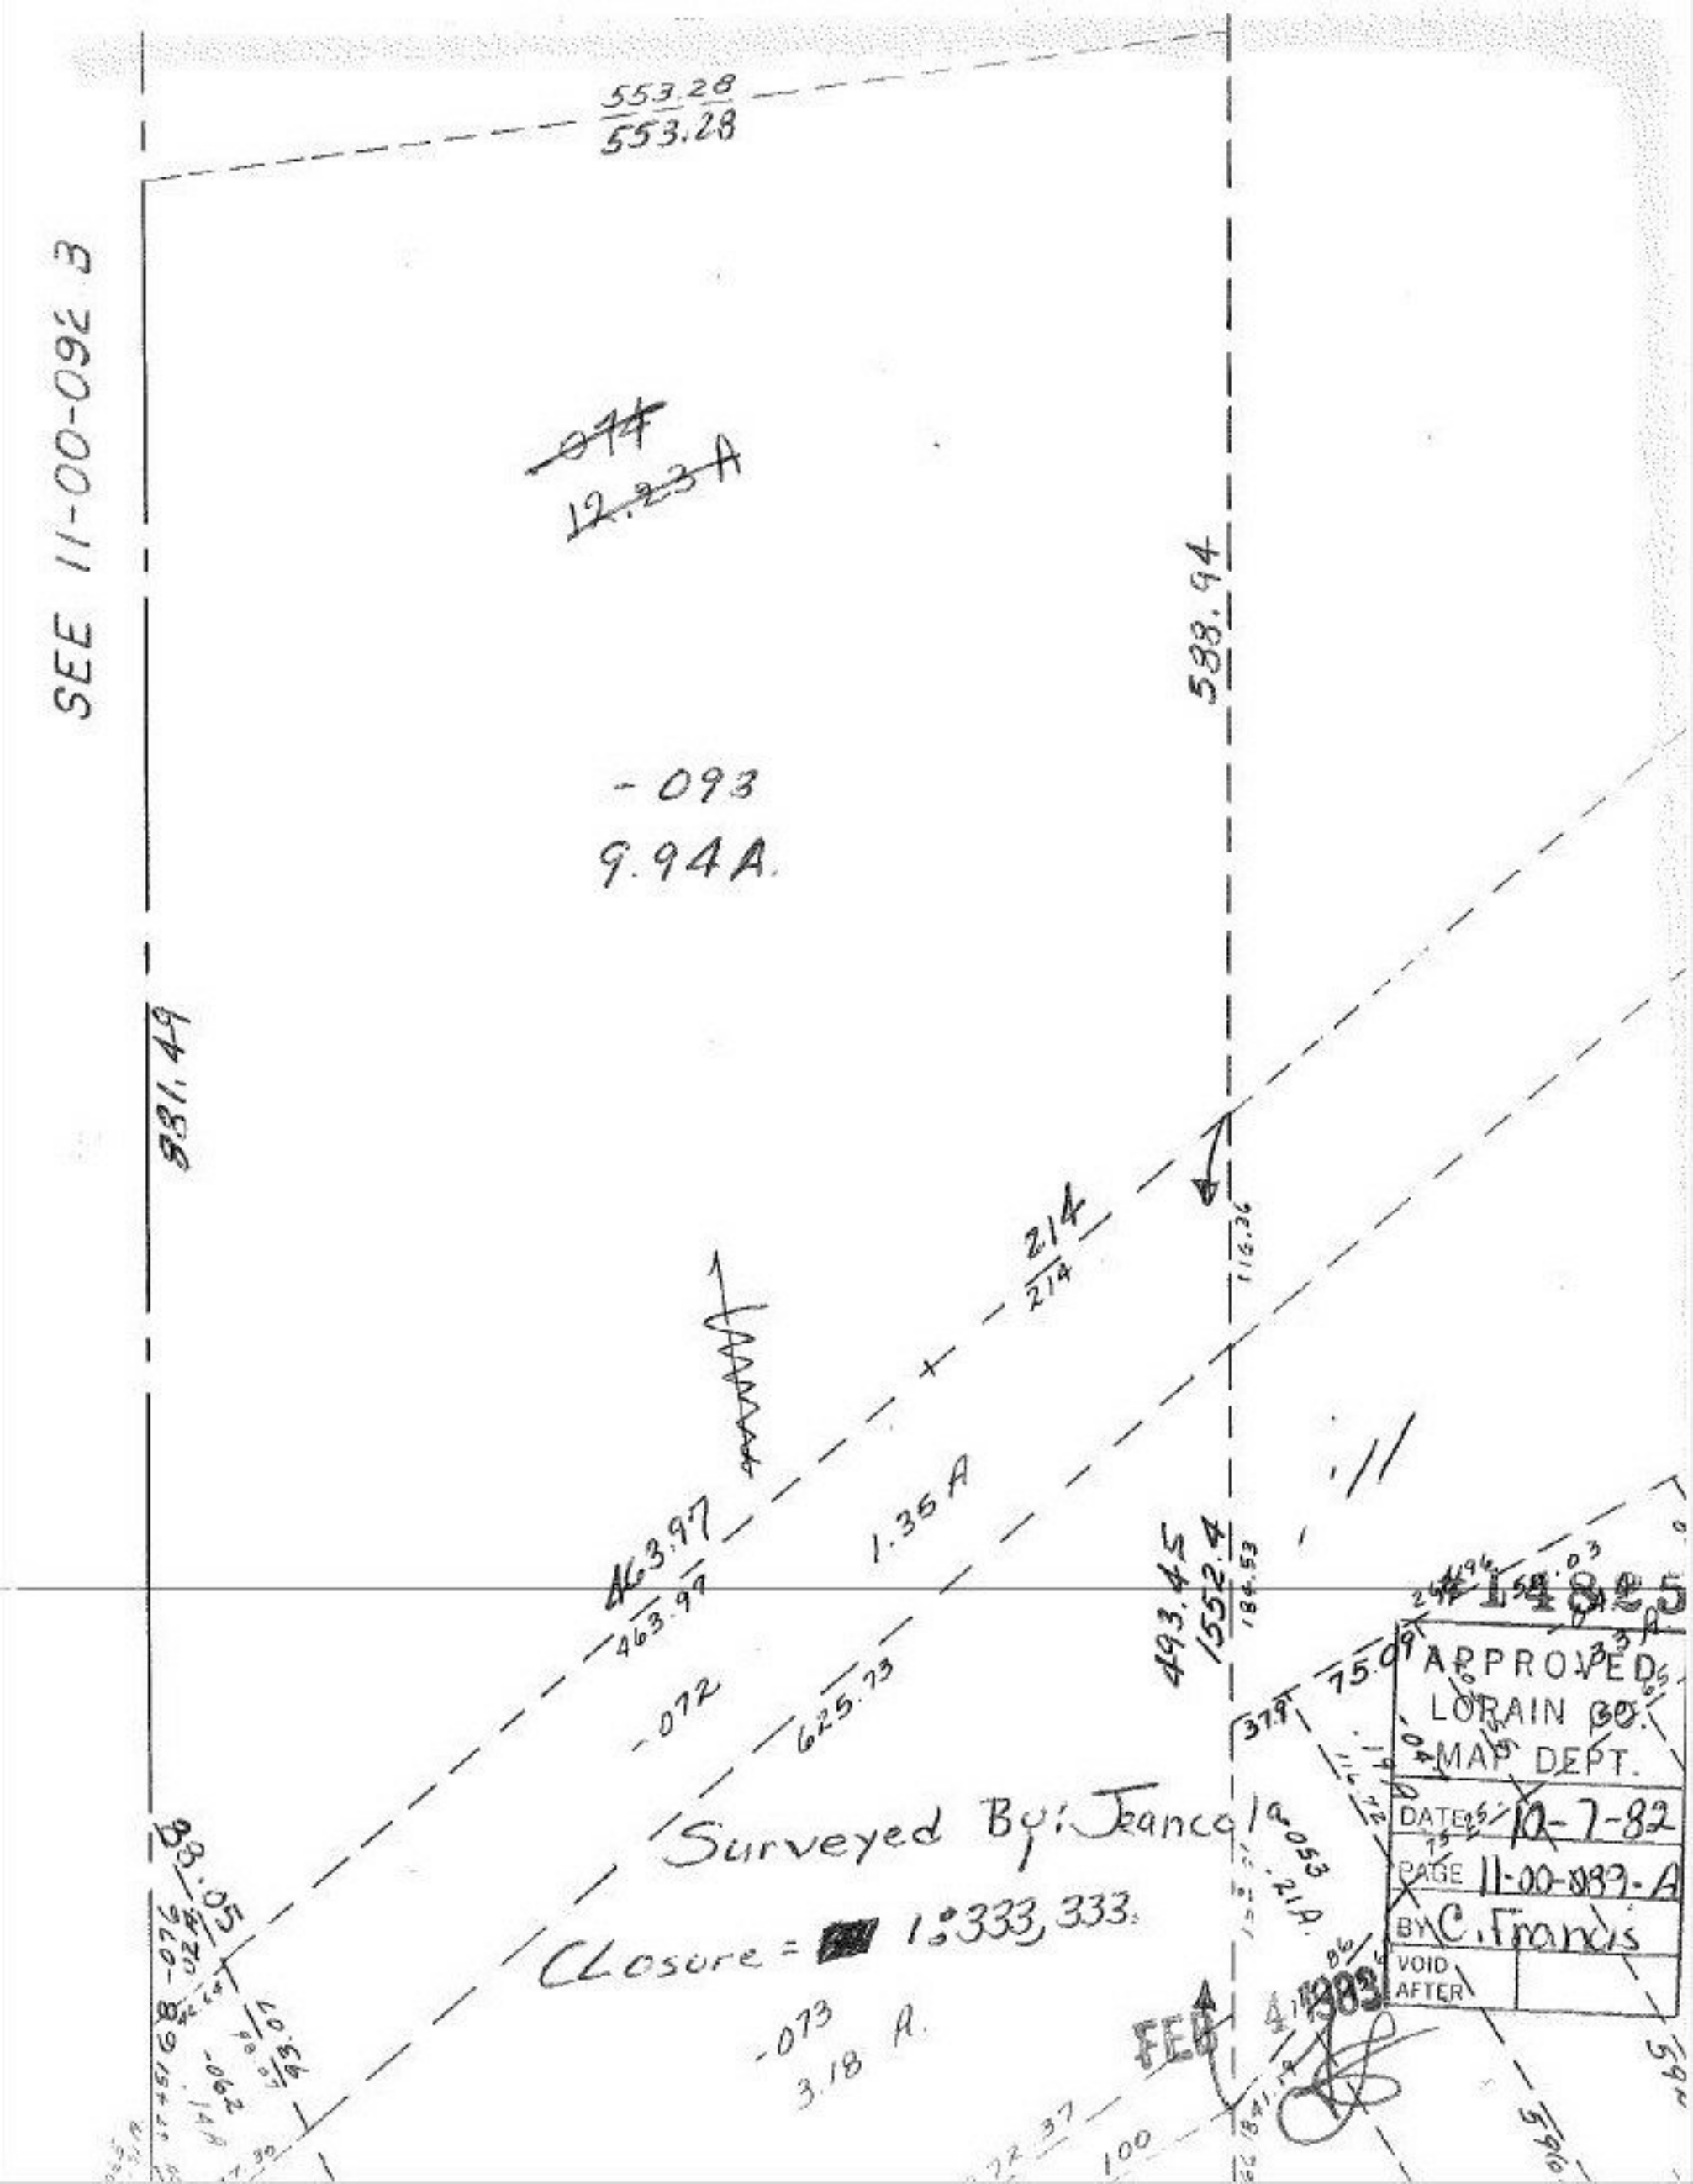

SEE 11-00-092 3
553.28
553.28
~~074~~
~~12.23 A~~
588.94
-093
9.94A.
881.49
214
214
116.36
463.97
463.97
1.35 A
493.45
1552.4
184.53
-072
625.73
75.09
37.9
Surveyed By: Jeancola
Closure = 1:333,333.
-073
3.18 A.
FEB 4 1983
APPROVED
LORAIN CO.
MAP DEPT.
DATE 10-7-82
PAGE 11-00-089-A
BY C. Francis
VOID AFTER