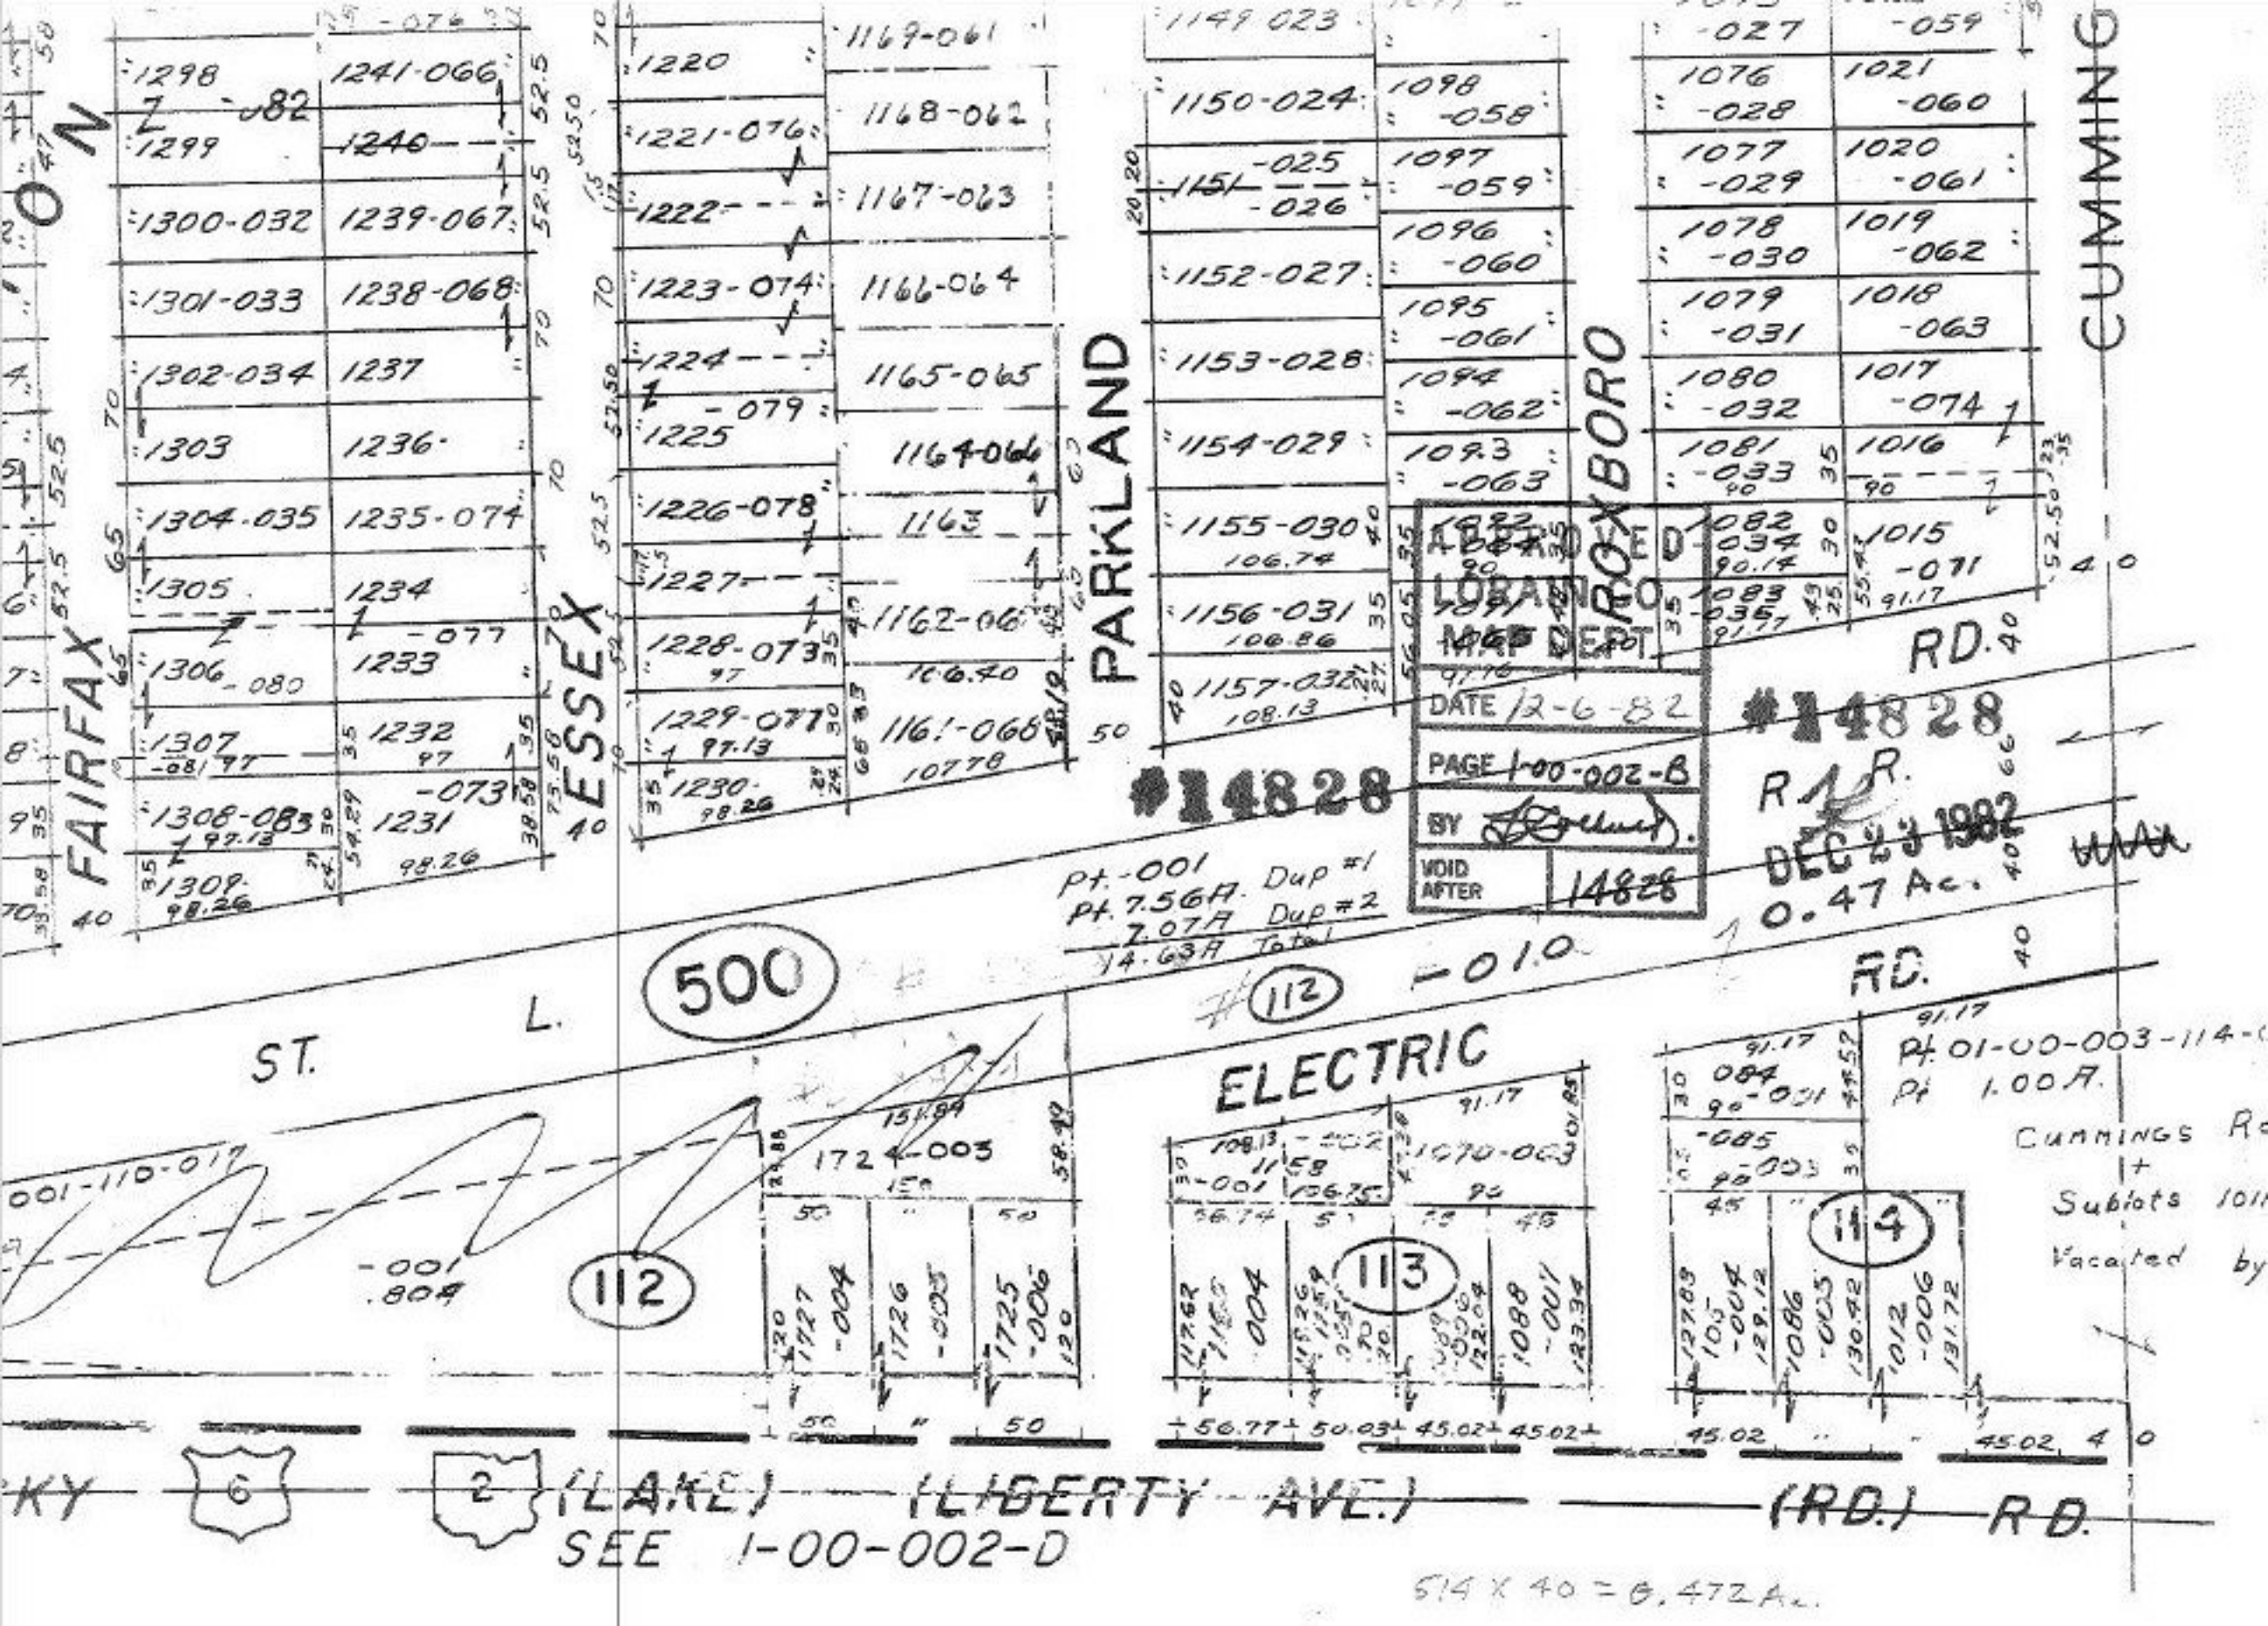

FAIRFAX
ESSEX
PARKLAND
ROXBORO
CUMMING
ELECTRIC
ST. L.
500
112
113
114
RD.
R.R.
#14828
DEC 23 1982
0.47 Ac.
Pt. -001
Pt. 7.56A. Dup #1
7.07A Dup #2
14.63A Total
Pt. 01-00-003-114-
Pt 1.00A.
CUMMINGS R
+
Sublots 101
Vacated by
APPROVED
LORAIN CO
MAP DEPT.
DATE 12-6-82
PAGE 1-00-002-B
BY
VOID AFTER 14828
(LAKE) (LIBERTY AVE.) (RD.) RD.
SEE 1-00-002-D
514 X 40 = 0.472 Ac.