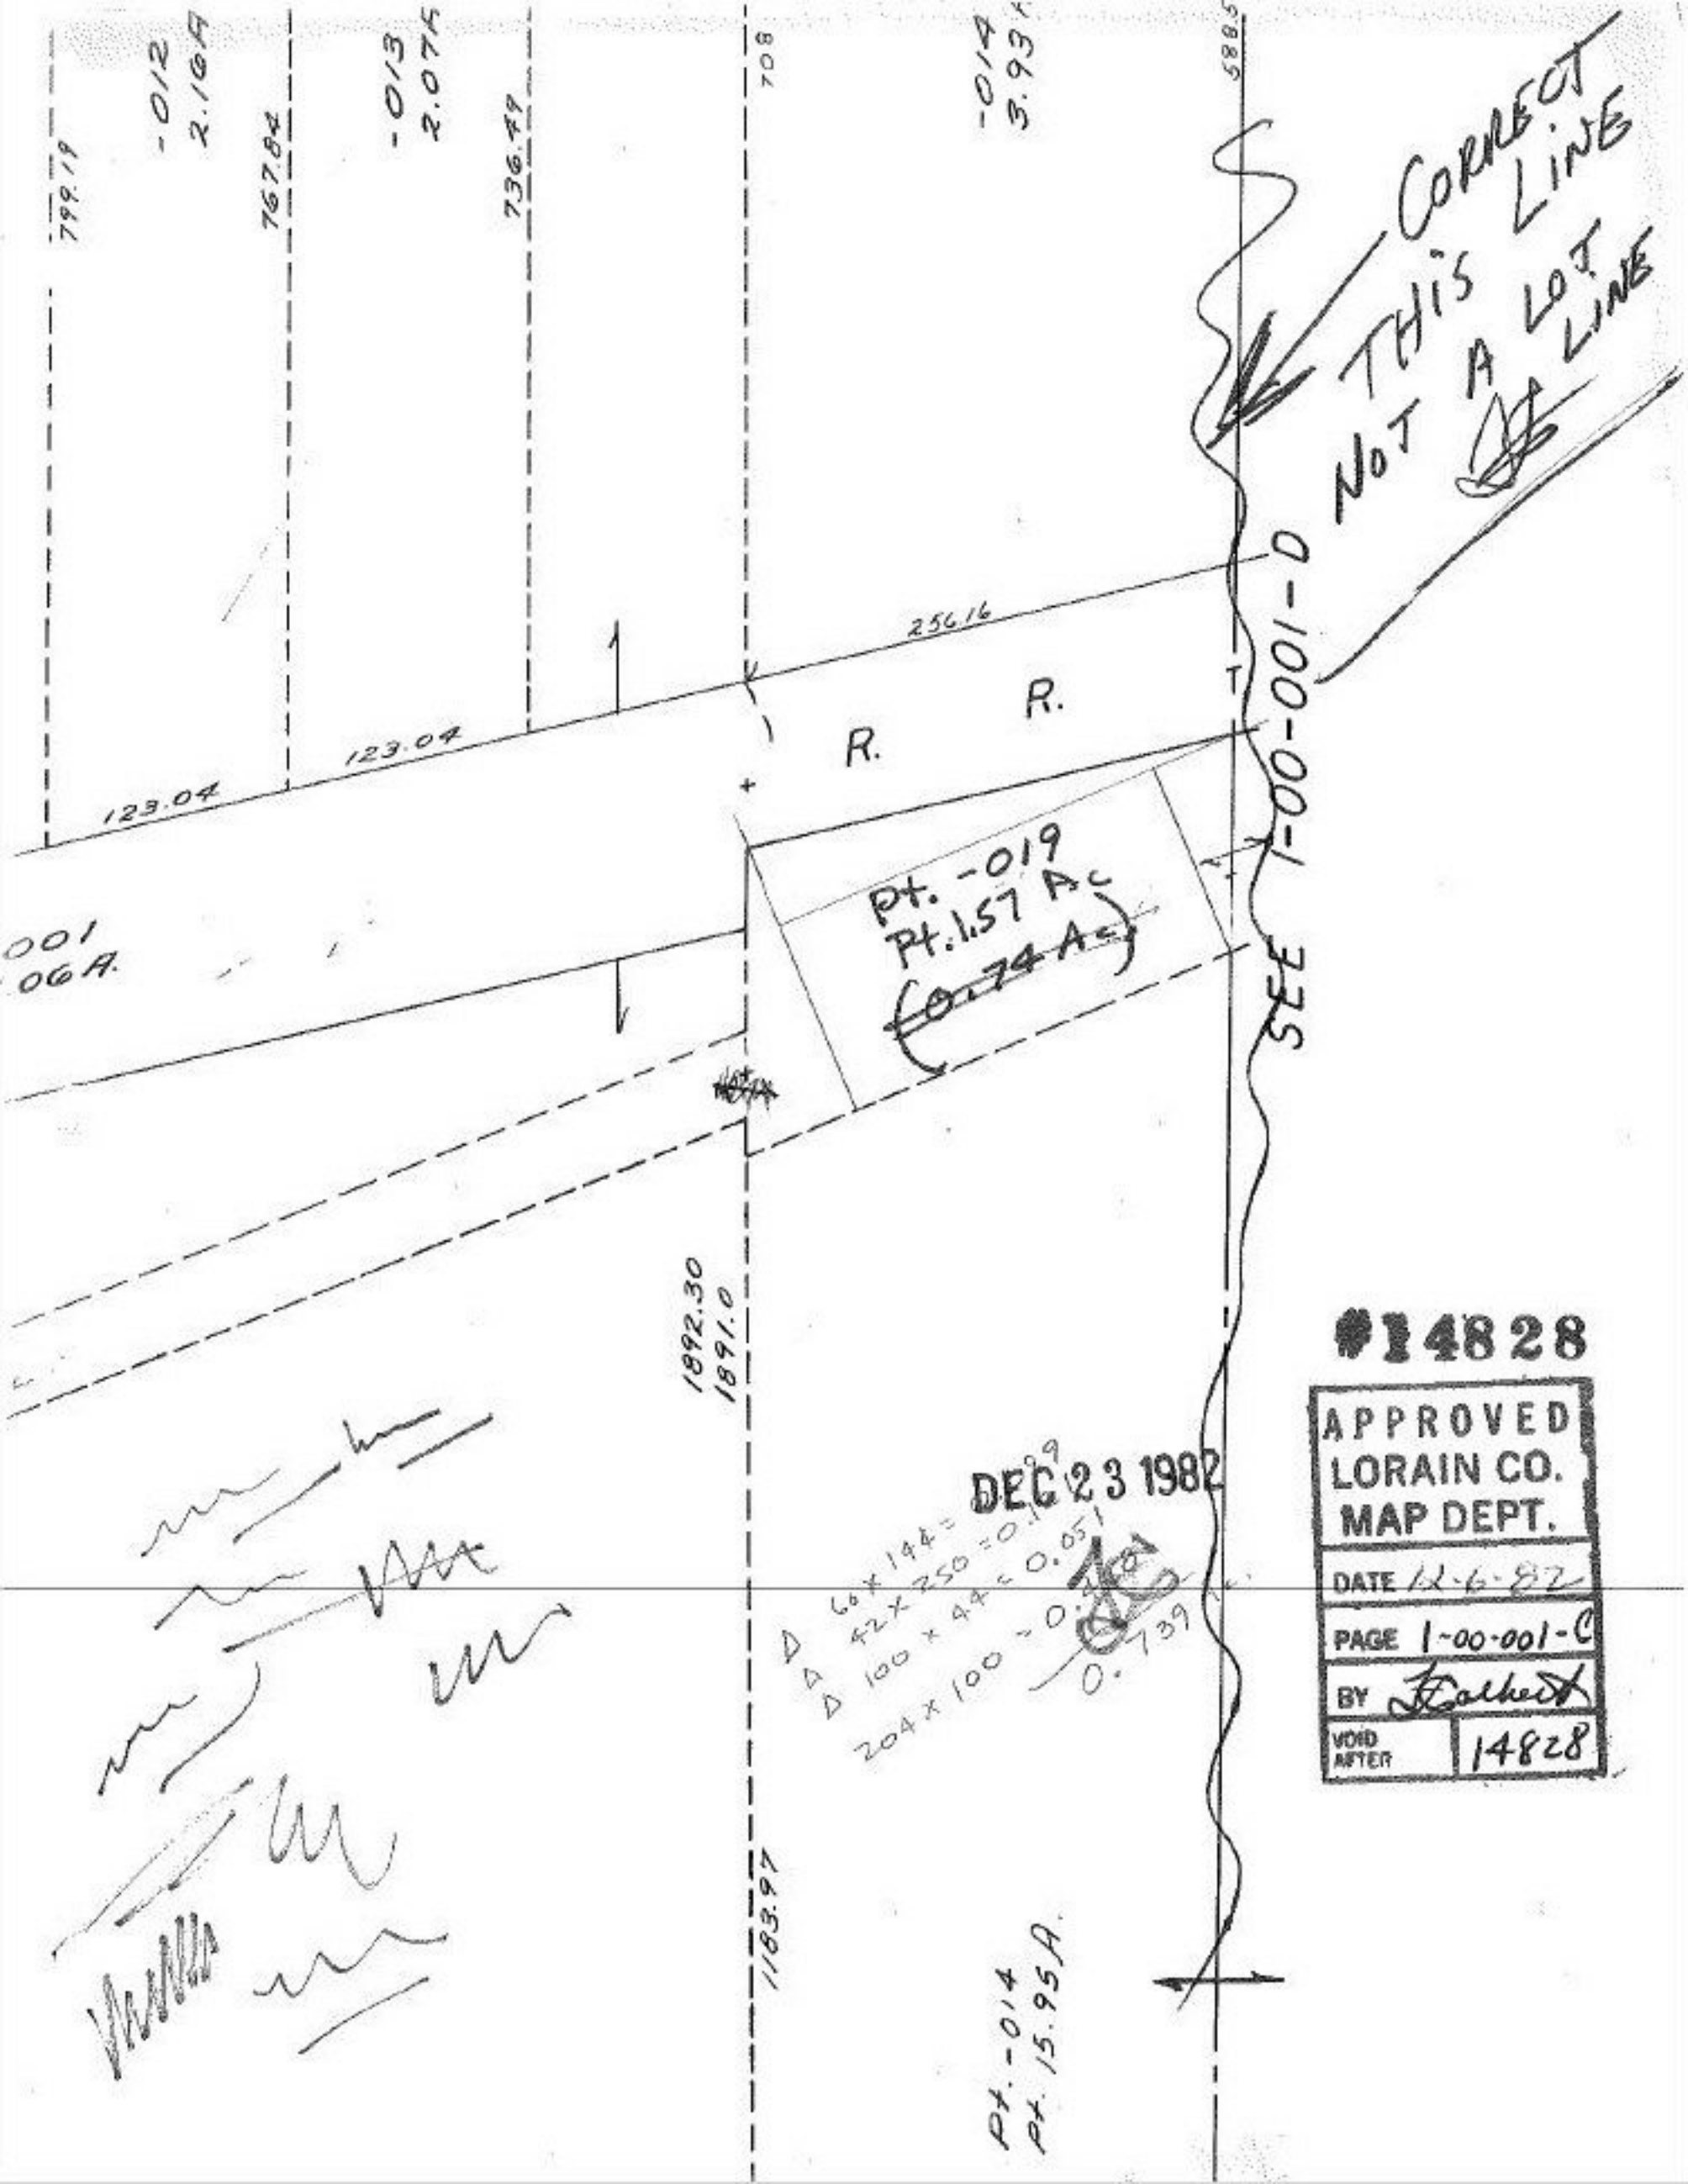

799.19
-012
2.16A
767.84
-013
2.07A
736.49
708
-014
3.93A
588.5
CORRECT THIS LINE NOT A LOT LINE
256.16
123.04
123.04
R.
R.
SEE 1-00-001-D
Pt. -019
Pt. 1.57 Ac
(0.74 Ac)
001
06A.
1892.30
1891.0
1183.97
Pt. -014
Pt. 15.95A.
DEC 23 1982
Δ 66 x 144 = 0.099
Δ 42 x 250 = 0.1
Δ 100 x 44 = 0.051
204 x 100 = 0.4
0.739
#14828
APPROVED
LORAIN CO.
MAP DEPT.
DATE 12-6-82
PAGE 1-00-001-C
BY
VOID AFTER 14828