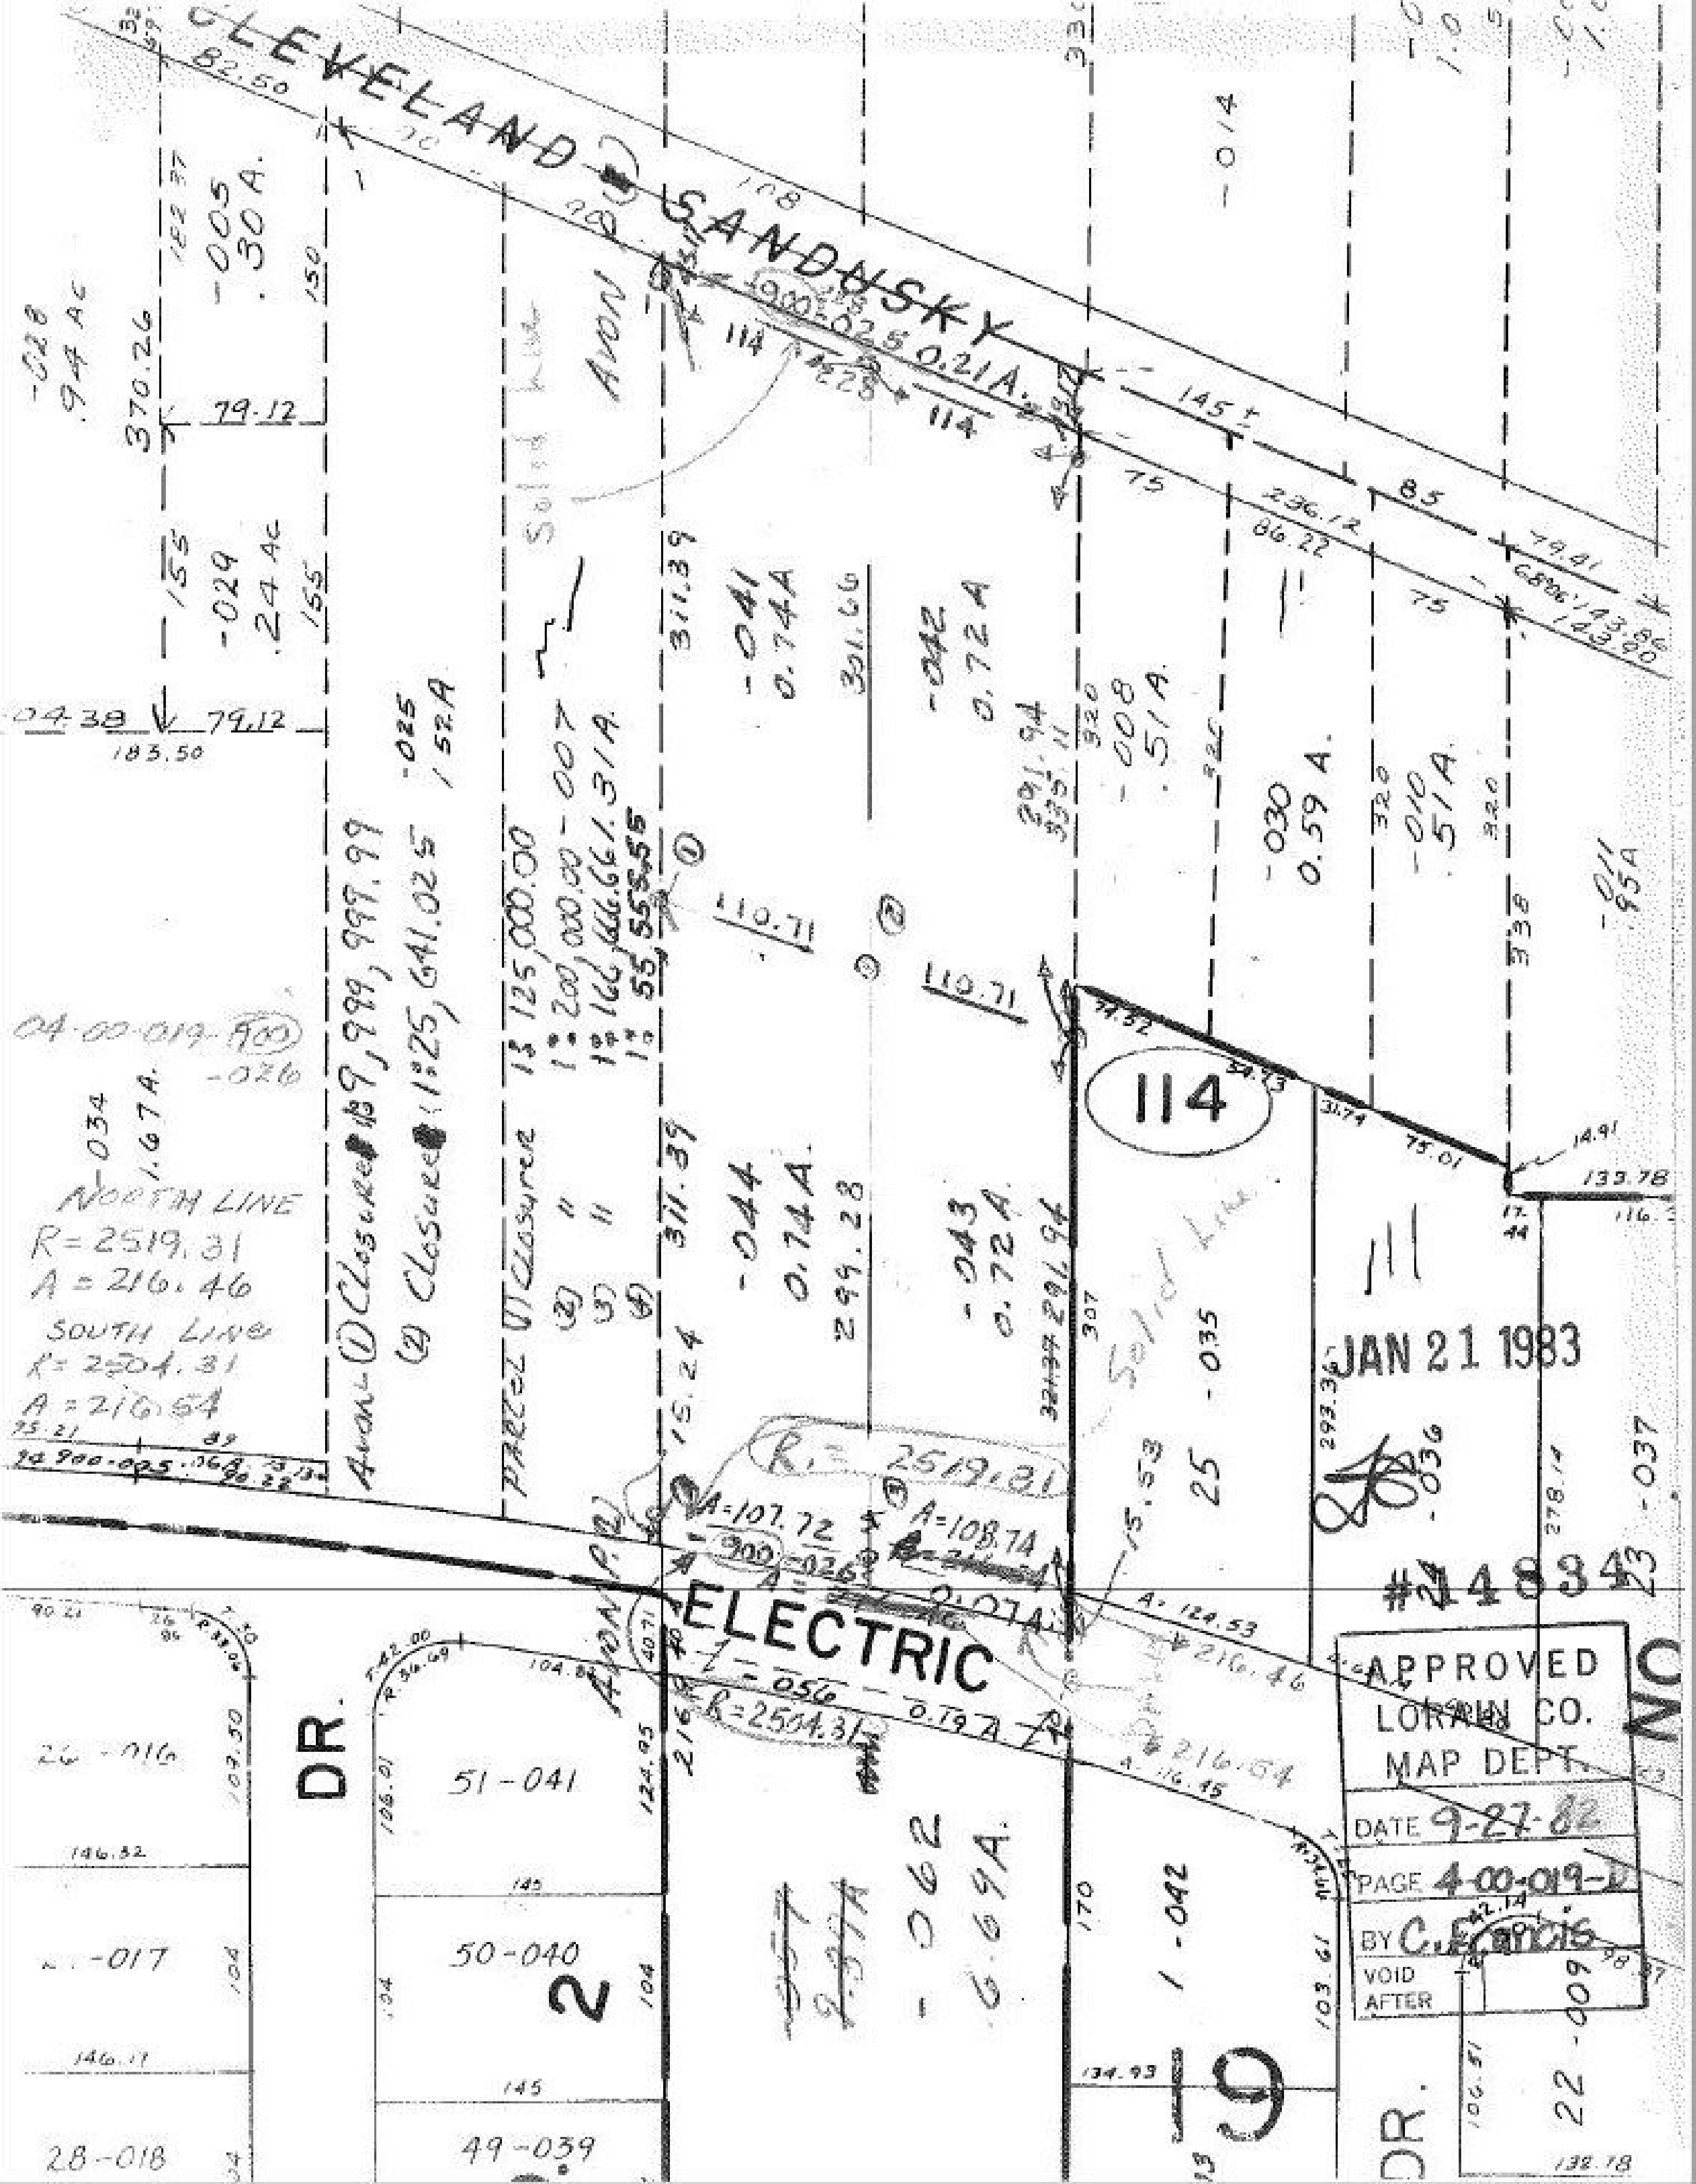

CLEVELAND - SANDUSKY
ELECTRIC
DR.
DR.
114
2
9
JAN 21 1983
#24834
APPROVED
LORAIN CO.
MAP DEPT.
DATE 9-27-82
PAGE 4-00-019-D
BY C. Francis
VOID
AFTER
NORTH LINE
R=2519.31
A=216.46
SOUTH LINE
R=2504.31
A=216.54
04-00-019-900
-026
-034
1.67A.
-028
.94 AC
-005
.30 A.
-029
.24 AC
-025
1.52A
-007
1.31A
-041
0.74A
-042
0.72A
-008
.51A.
-030
0.59 A.
-010
.51A.
-011
.95A
-014
-044
0.74A.
-043
0.72A.
25-035
-036
-037
-062
0.69A.
1-042
22-009
51-041
50-040
49-039
26-016
-017
28-018
900-025 0.21A.
900-026
-056
0.79A.
Avon
Solid Line
Parcel (1) Closure 1:9,999,999.99
(2) Closure 1:125,641.025
Parcel (1) Closure 1:125,000.00
(2) " 1:200,000.00
(3) " 1:166,666.67
(4) " 1:55,555.56
R=2519.31
A=107.72
A=108.74
A=124.53
A=116.45
R=2504.31
370.26
79.12
183.50
311.39
301.66
299.28
291.94
145±
75
85
236.12
86.22
79.41
143.86
143.90
110.71
94.32
31.74
75.01
14.91
133.78
293.36
278.14
15.24
15.53
124.95
104
170
134.93
103.61
146.32
146.17
145
132.78