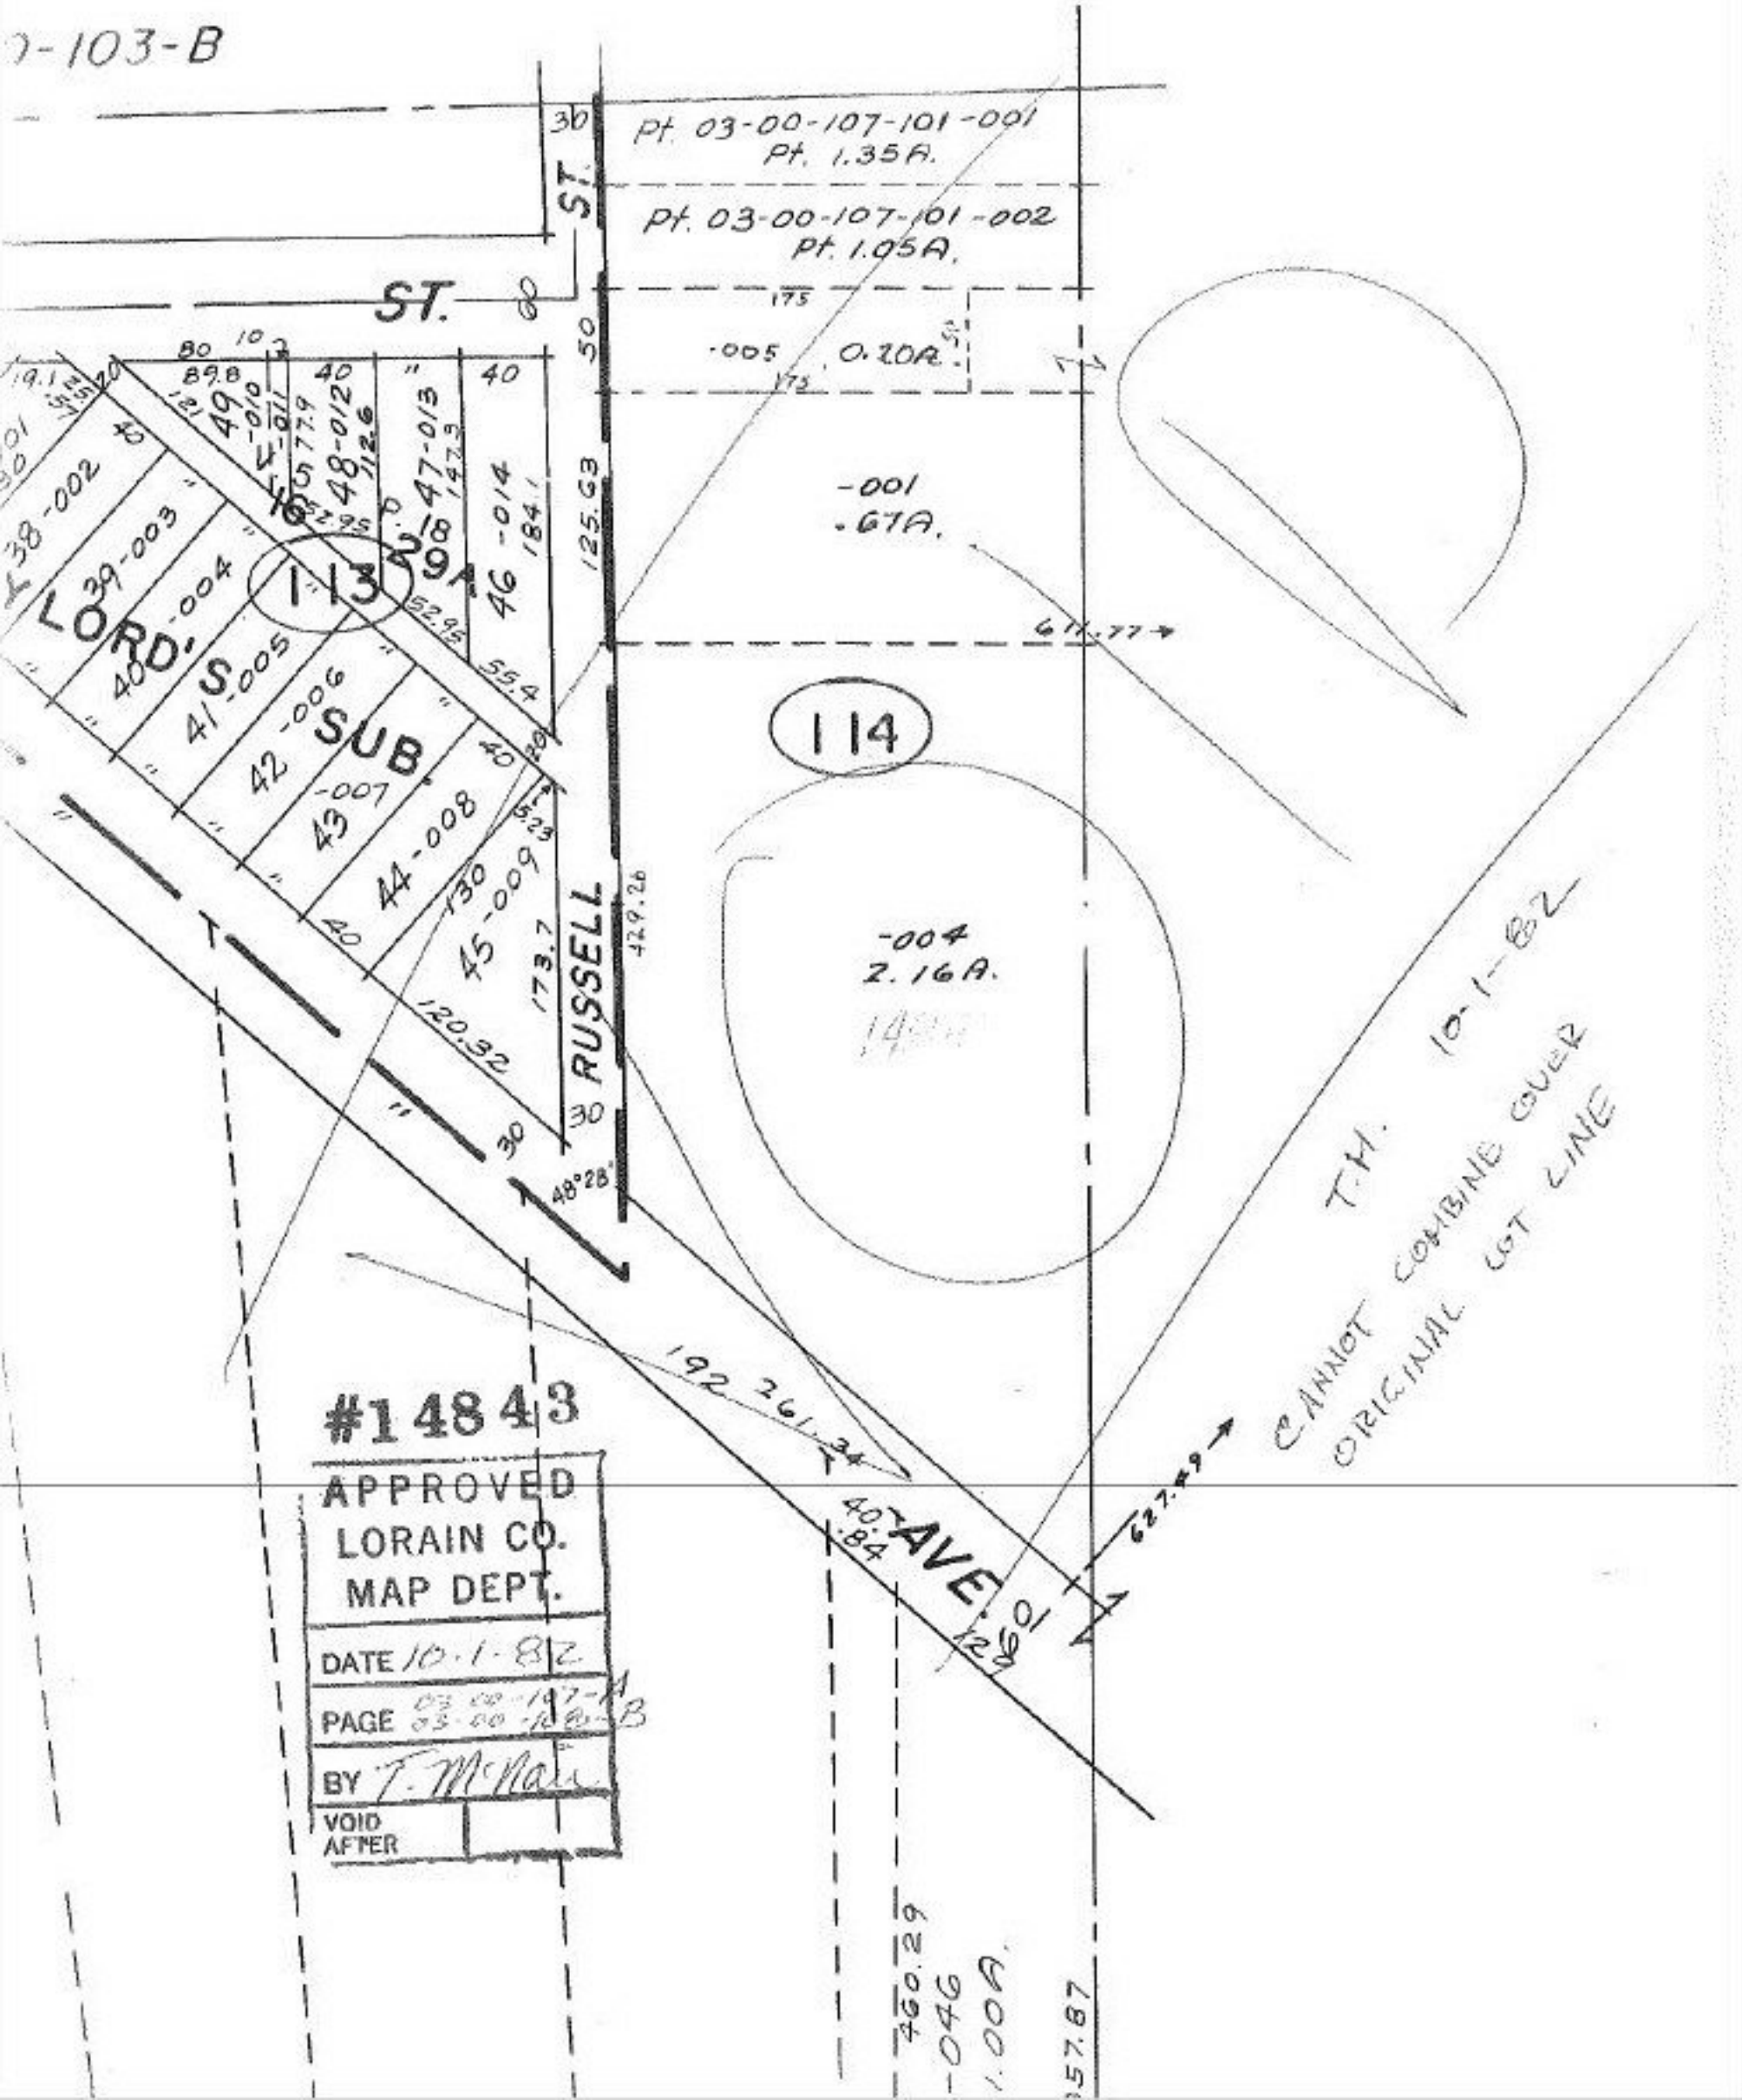

-103-B
Pt. 03-00-107-101-001
Pt. 1.35A.
Pt. 03-00-107-101-002
Pt. 1.05A.
ST.
ST.
-005
0.20A.
-001
.67A.
611.77
114
-004
2.16A.
113
LORD'S SUB
RUSSELL
AVE
38-002
39-003
40-004
41-005
42-006
43-007
44-008
45-009
46-014
47-013
48-012
49-010
-001
-004
-046
1.00A.
460.29
257.87
627.49
192
261.34
40.84
48°28'
120.32
173.7
429.26
125.63
T.M. 10-1-82
CANNOT COMBINE OVER ORIGINAL LOT LINE
#14843
APPROVED
LORAIN CO.
MAP DEPT.
DATE 10-1-82
PAGE 03-00-107-A 03-00-108-B
BY T. McNair
VOID AFTER