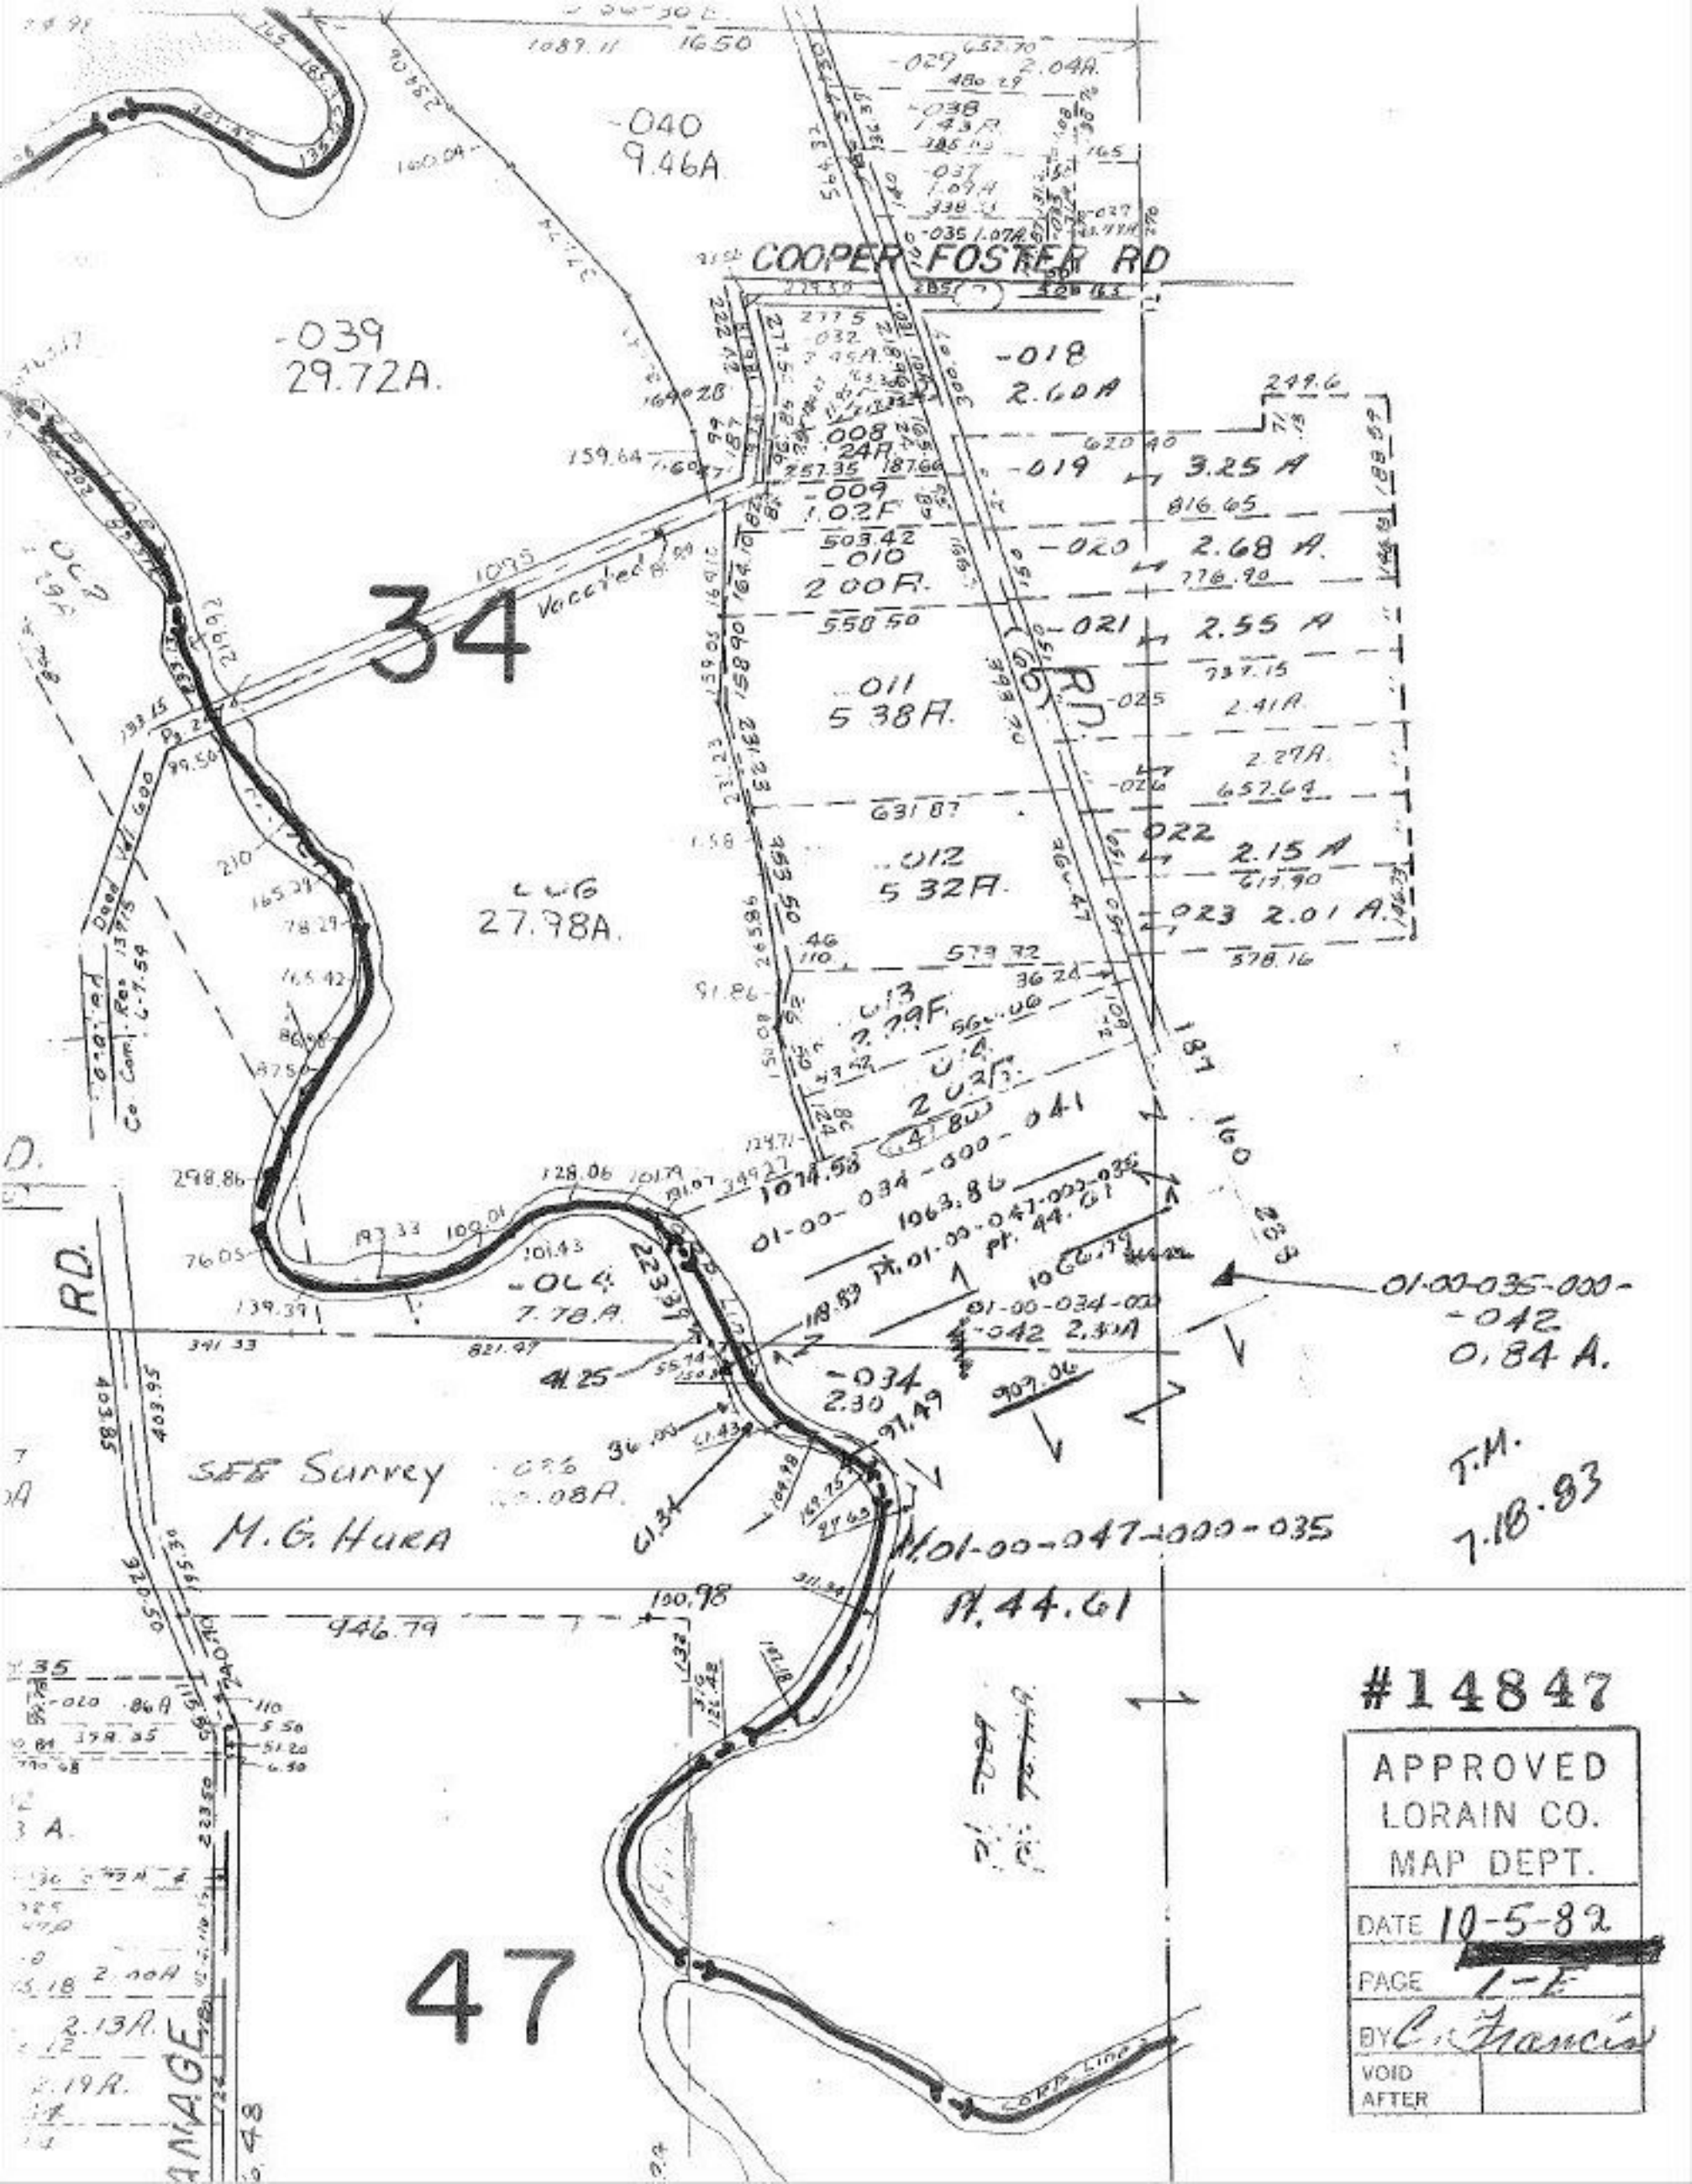

COOPER FOSTER RD
-040
9.46A
-039
29.72A.
-018
2.60A
-019
3.25 A
-020
2.68 A.
-021
2.55 A
-022
2.15 A
-023
2.01 A.
-011
5.38A.
-012
5.32A.
-013
2.79F.
-014
2.02F.
-009
1.02F
-010
2.00A.
-008
.24A
-029
2.04A.
-038
1.43A
-037
1.07A
-035
1.07A
34
Vacated
27.98A.
-064
7.78A.
-034
2.30
01-00-034-000-041
01-00-047-000-035
Pt. 44.61
01-00-035-000-042
0.84 A.
01-00-034-000-042
2.30A
SEE Survey
M.G. HURA
T.M.
7.18.83
01-00-047-000-035
Pt. 44.61
47
#14847
APPROVED
LORAIN CO.
MAP DEPT.
DATE 10-5-82
PAGE 1-E
BY C. Francis
VOID
AFTER