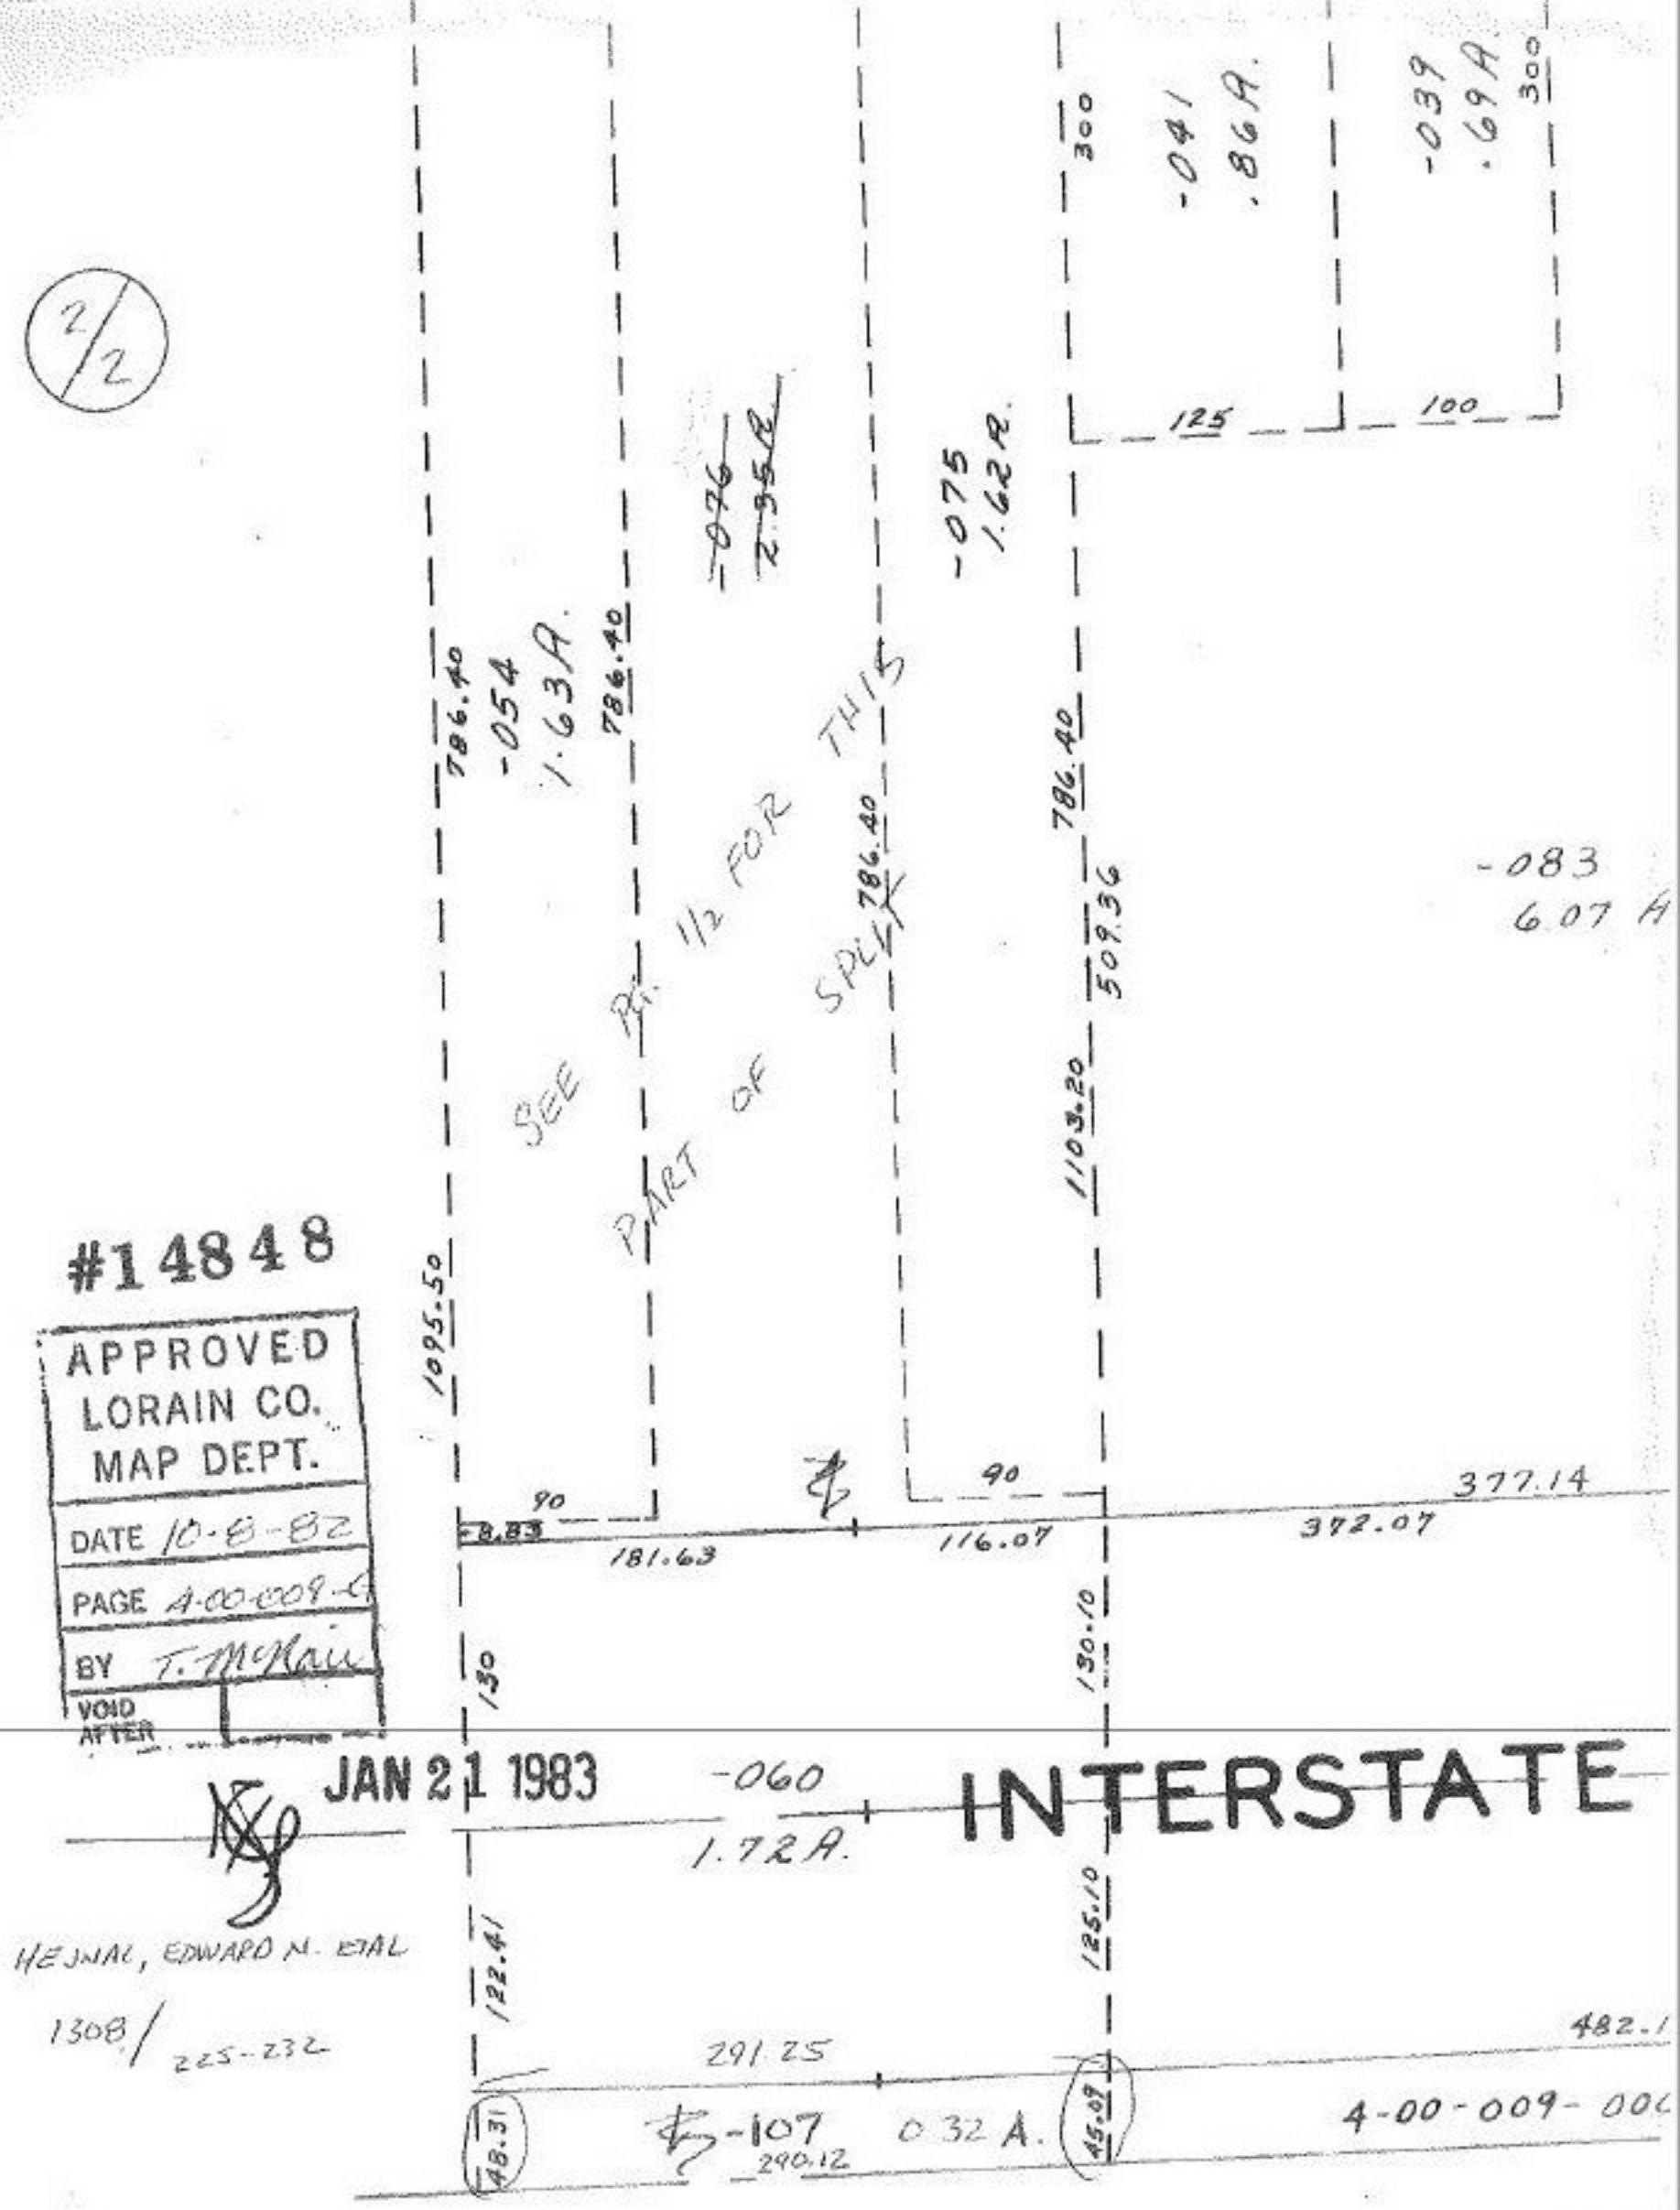

#14848

APPROVED
LORAIN CO.
MAP DEPT.
DATE 10-8-82
PAGE 4-00-009-G
BY T. McNair
VOID AFTER

JAN 21 1983

HEJNAL, EDWARD N. ETAL

1308/225-232