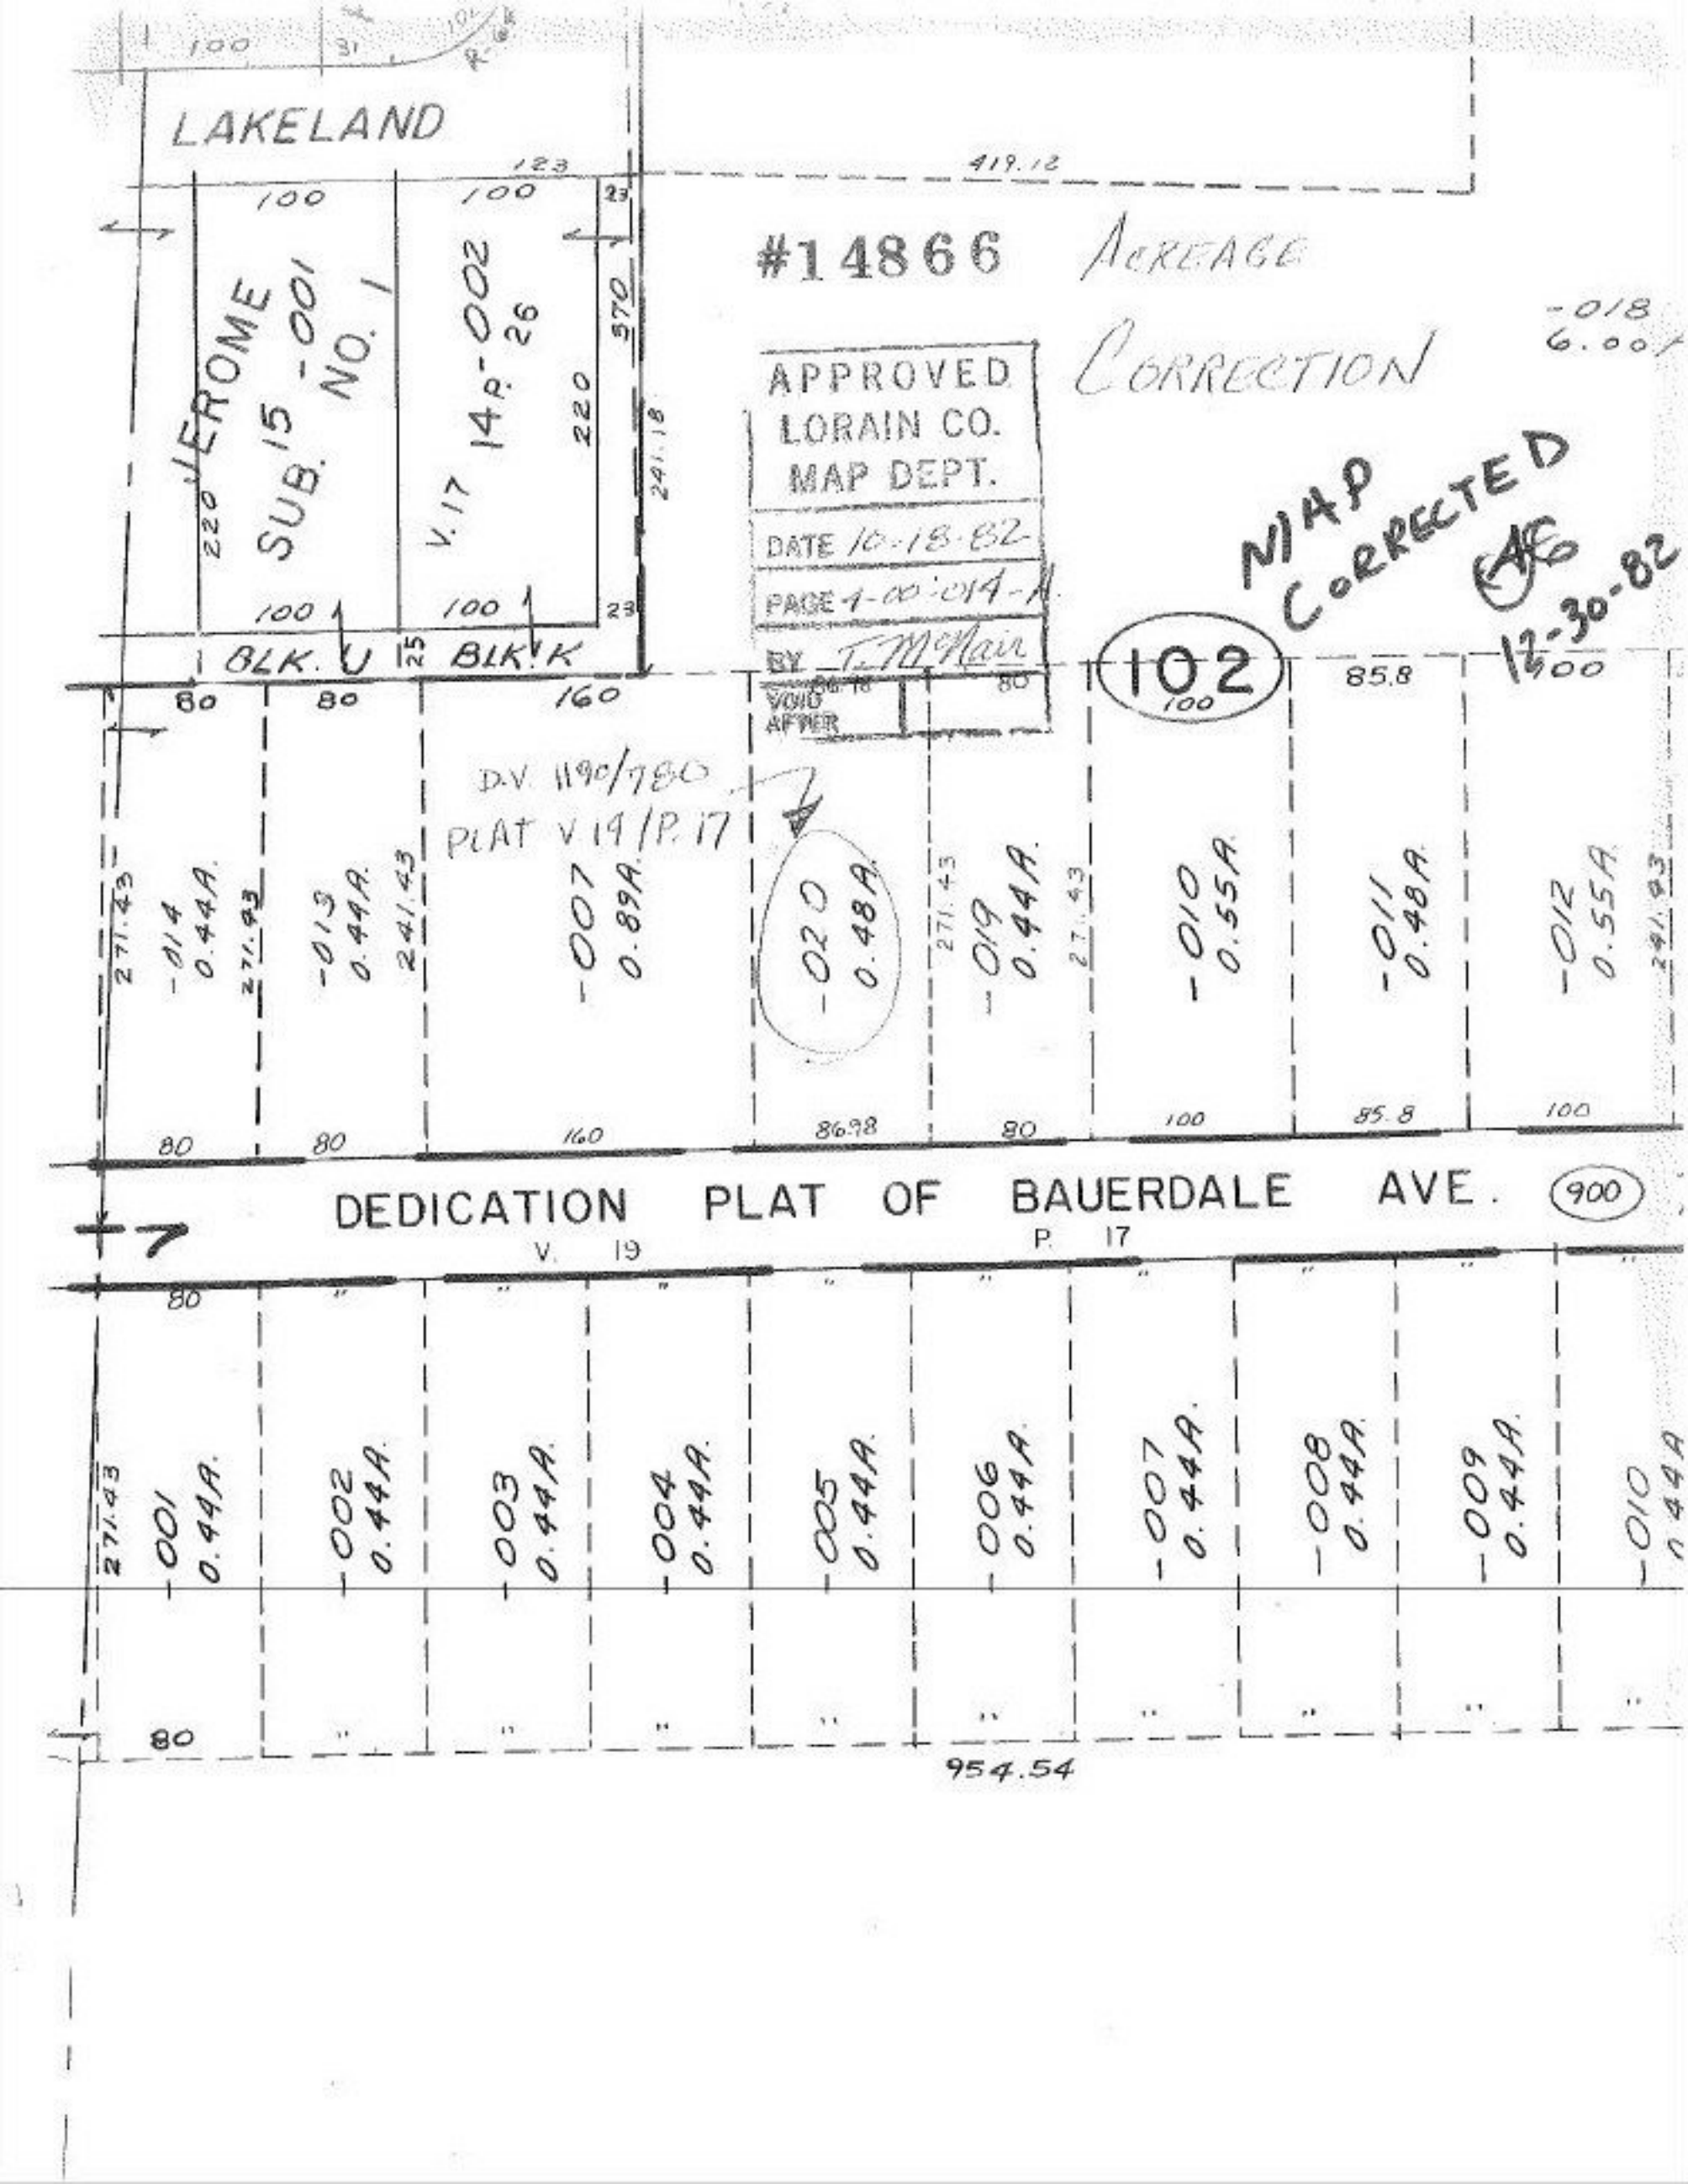

LAKELAND
JEROME SUB. NO. 1
15-001
V. 17 14P-002 26
#14866 ACREAGE CORRECTION
APPROVED LORAIN CO. MAP DEPT.
DATE 10-18-82
PAGE 1-00-014-A
BY T. McNair
VOID AFTER
MAP CORRECTED
12-30-82
-018 6.00A
BLK. U
BLK. K
102
D.V. 1190/780
PLAT V 19/P. 17
-014 0.44A.
-013 0.44A.
-007 0.89A.
-020 0.48A.
-019 0.44A.
-010 0.55A.
-011 0.48A.
-012 0.55A.
DEDICATION PLAT OF BAUERDALE AVE.
900
V. 19
P. 17
-001 0.44A.
-002 0.44A.
-003 0.44A.
-004 0.44A.
-005 0.44A.
-006 0.44A.
-007 0.44A.
-008 0.44A.
-009 0.44A.
-010 0.44A.
954.54