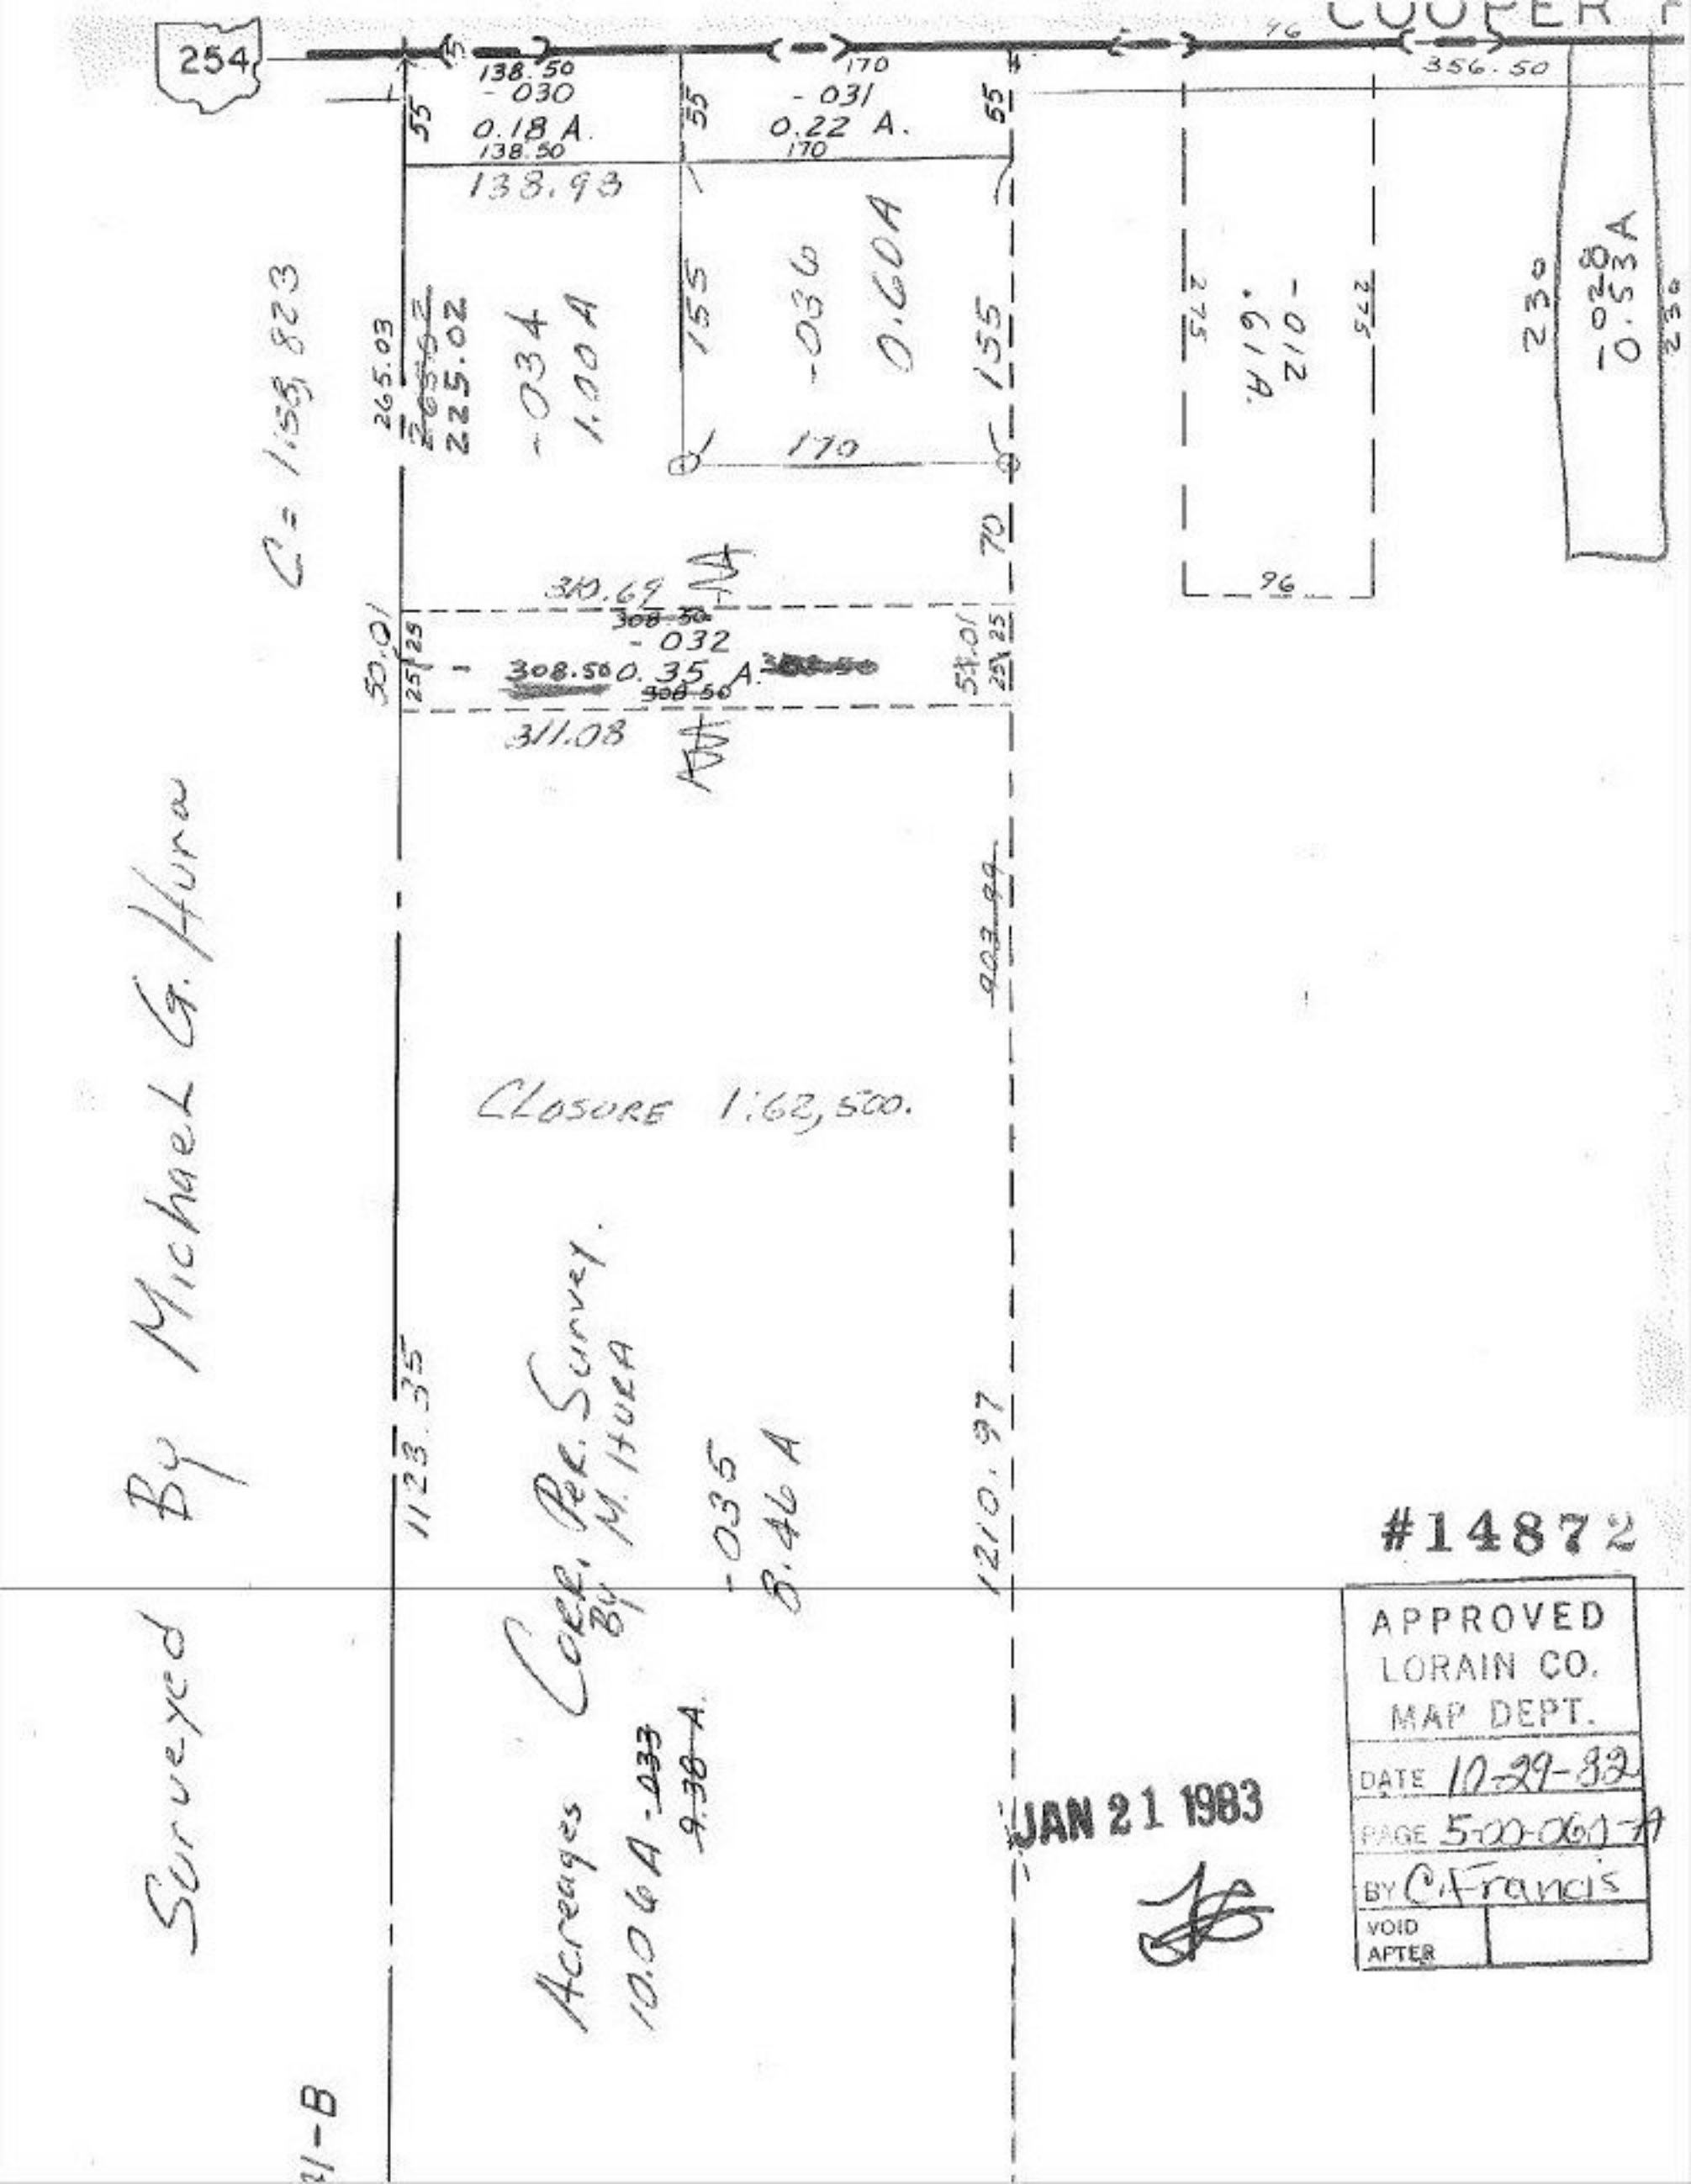

#14872

APPROVED
LORAIN CO.
MAP DEPT.
DATE 10-29-82
PAGE 5-00-061-A
BY C. Francis
VOID AFTER

JAN 21 1983