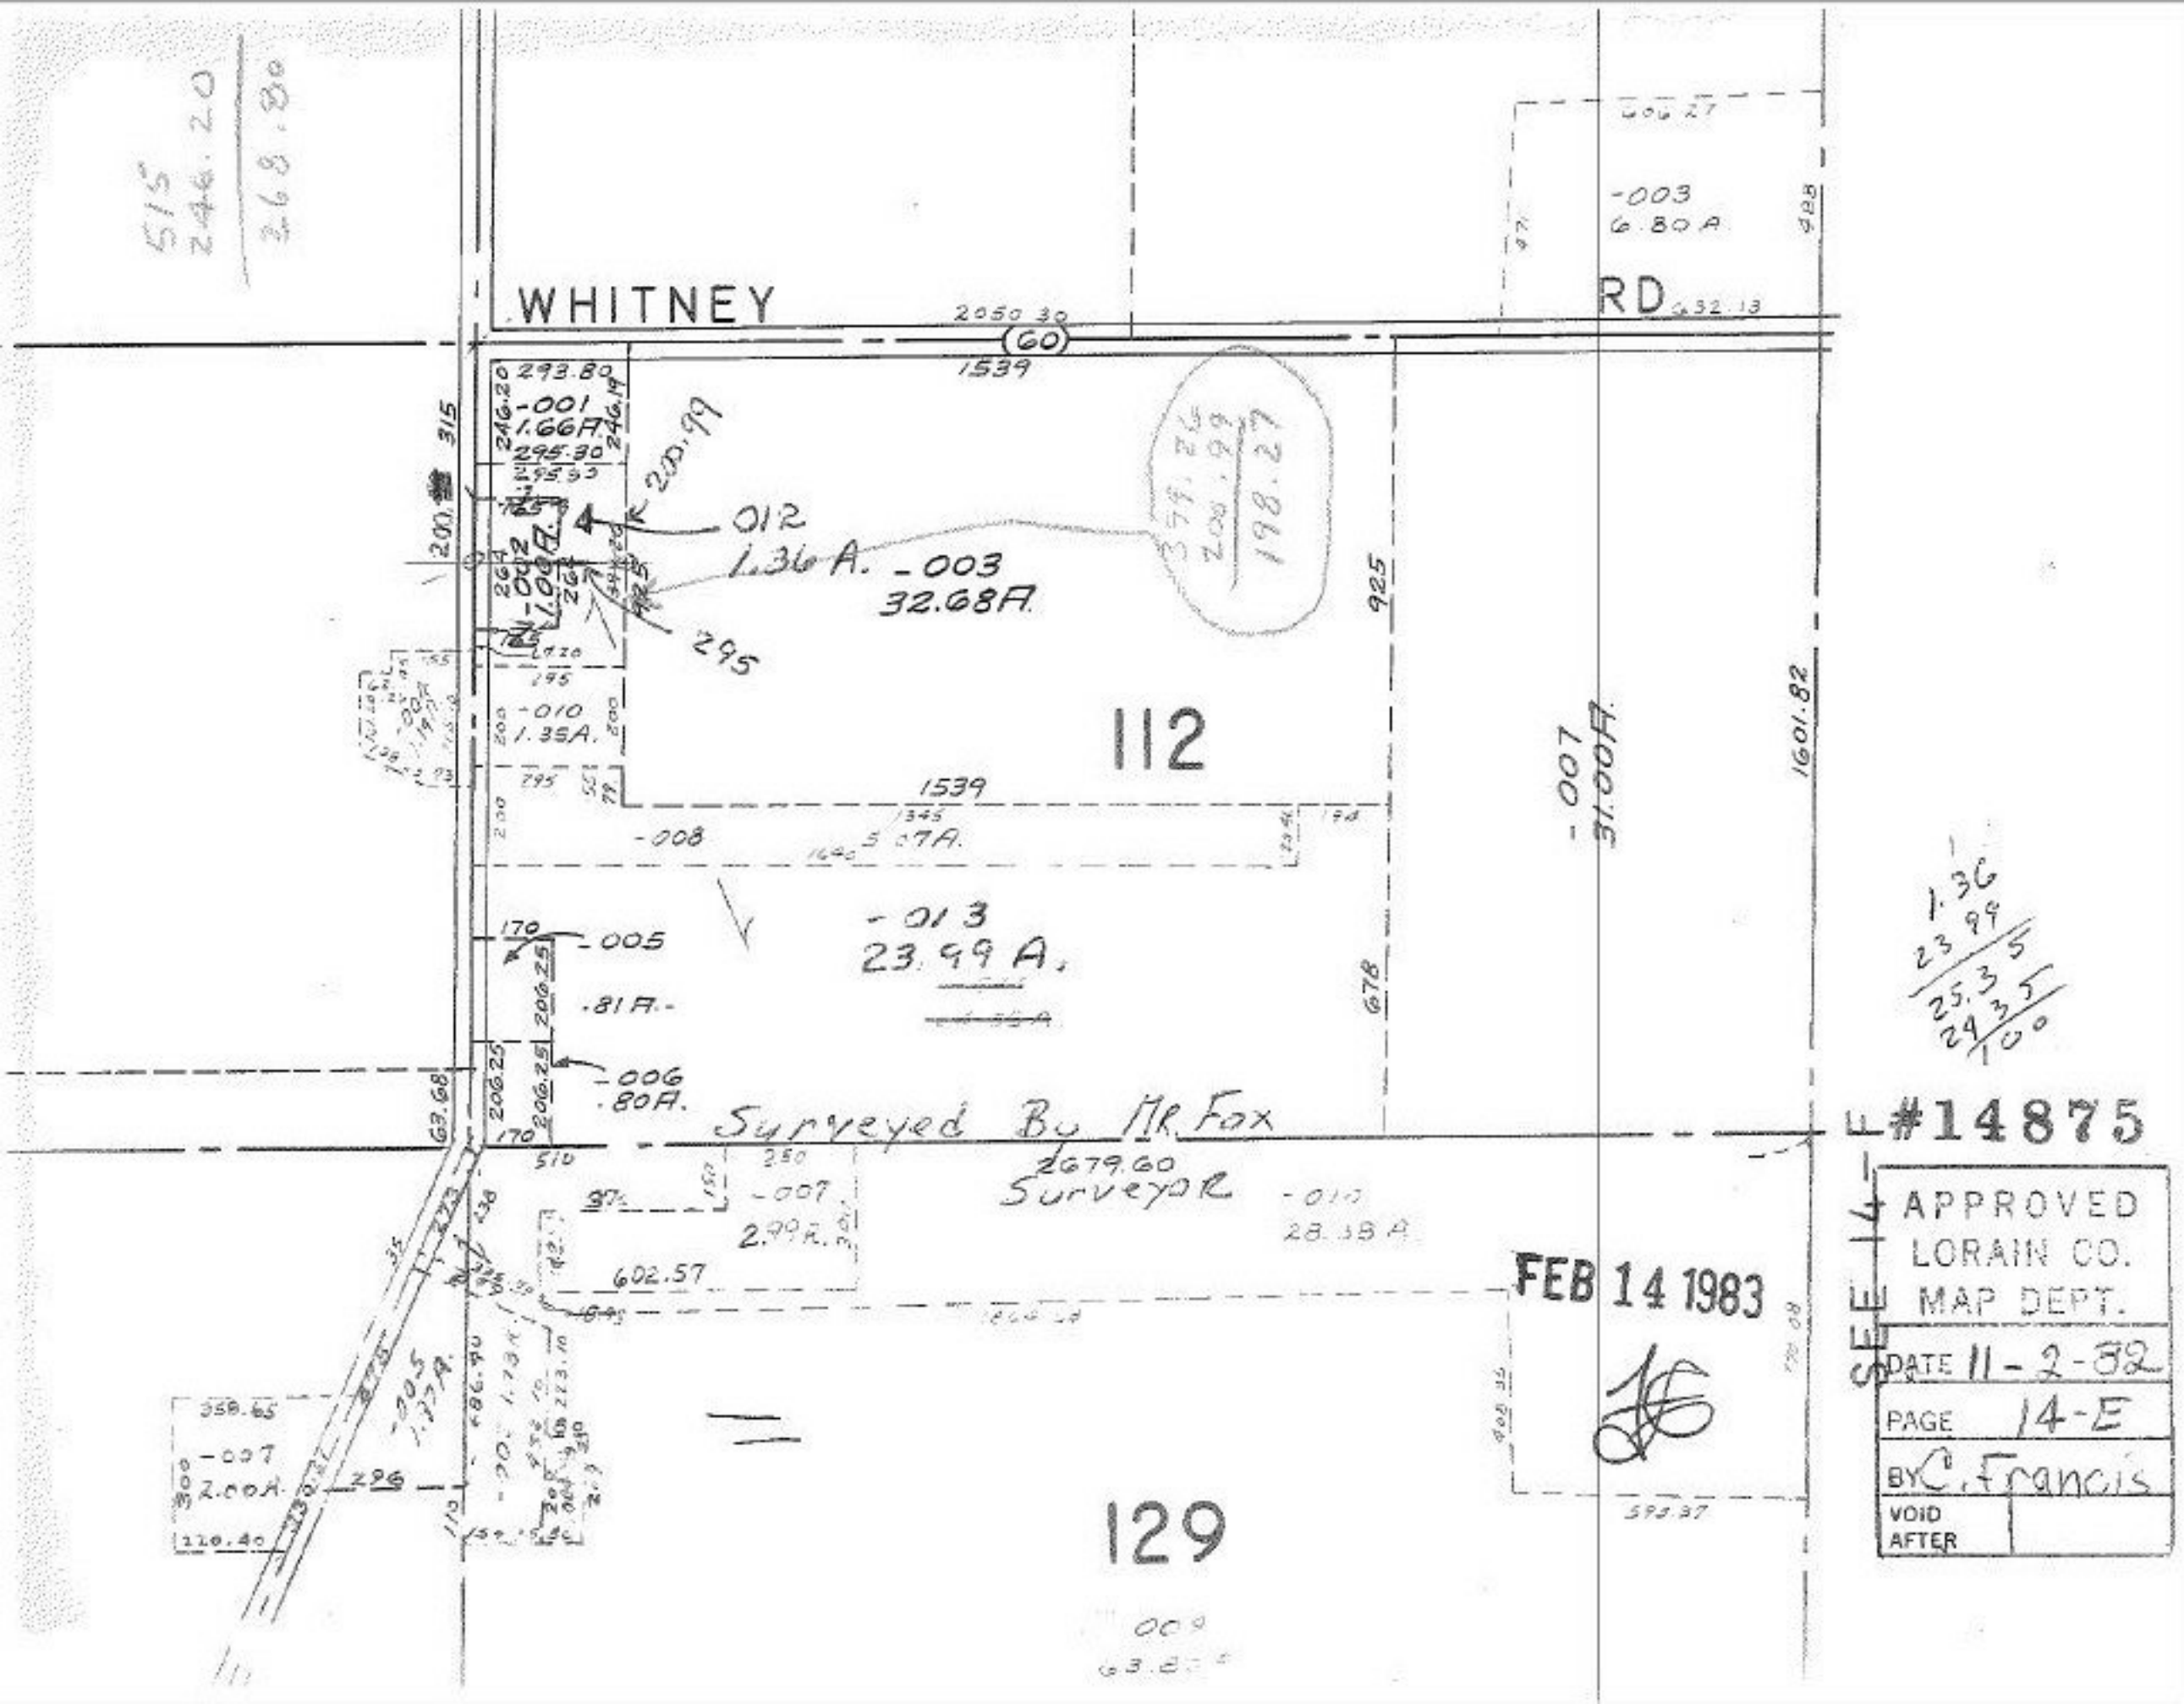
WHITNEY
RD
2050.30
(60)
1539
-003
6.80 A
-001
1.66A
200.99
012
1.36 A.
-003
32.68A
295
-010
1.35A.
112
1539
-008
5.07A.
-007
31.00A
1601.82
-013
23.99 A.
-005
.81A.
-006
.80A.
Surveyed By Mr. Fox
2679.60
Surveyor
-007
2.99A.
-010
28.38 A
602.57
-005
1.37A.
-007
2.00A.
129
1.36
23.99
25.35
24.35
100
#14875
APPROVED
LORAIN CO.
MAP DEPT.
DATE 11-2-82
PAGE 14-E
BY C. Francis
VOID
AFTER
FEB 14 1983
SEE 14-F