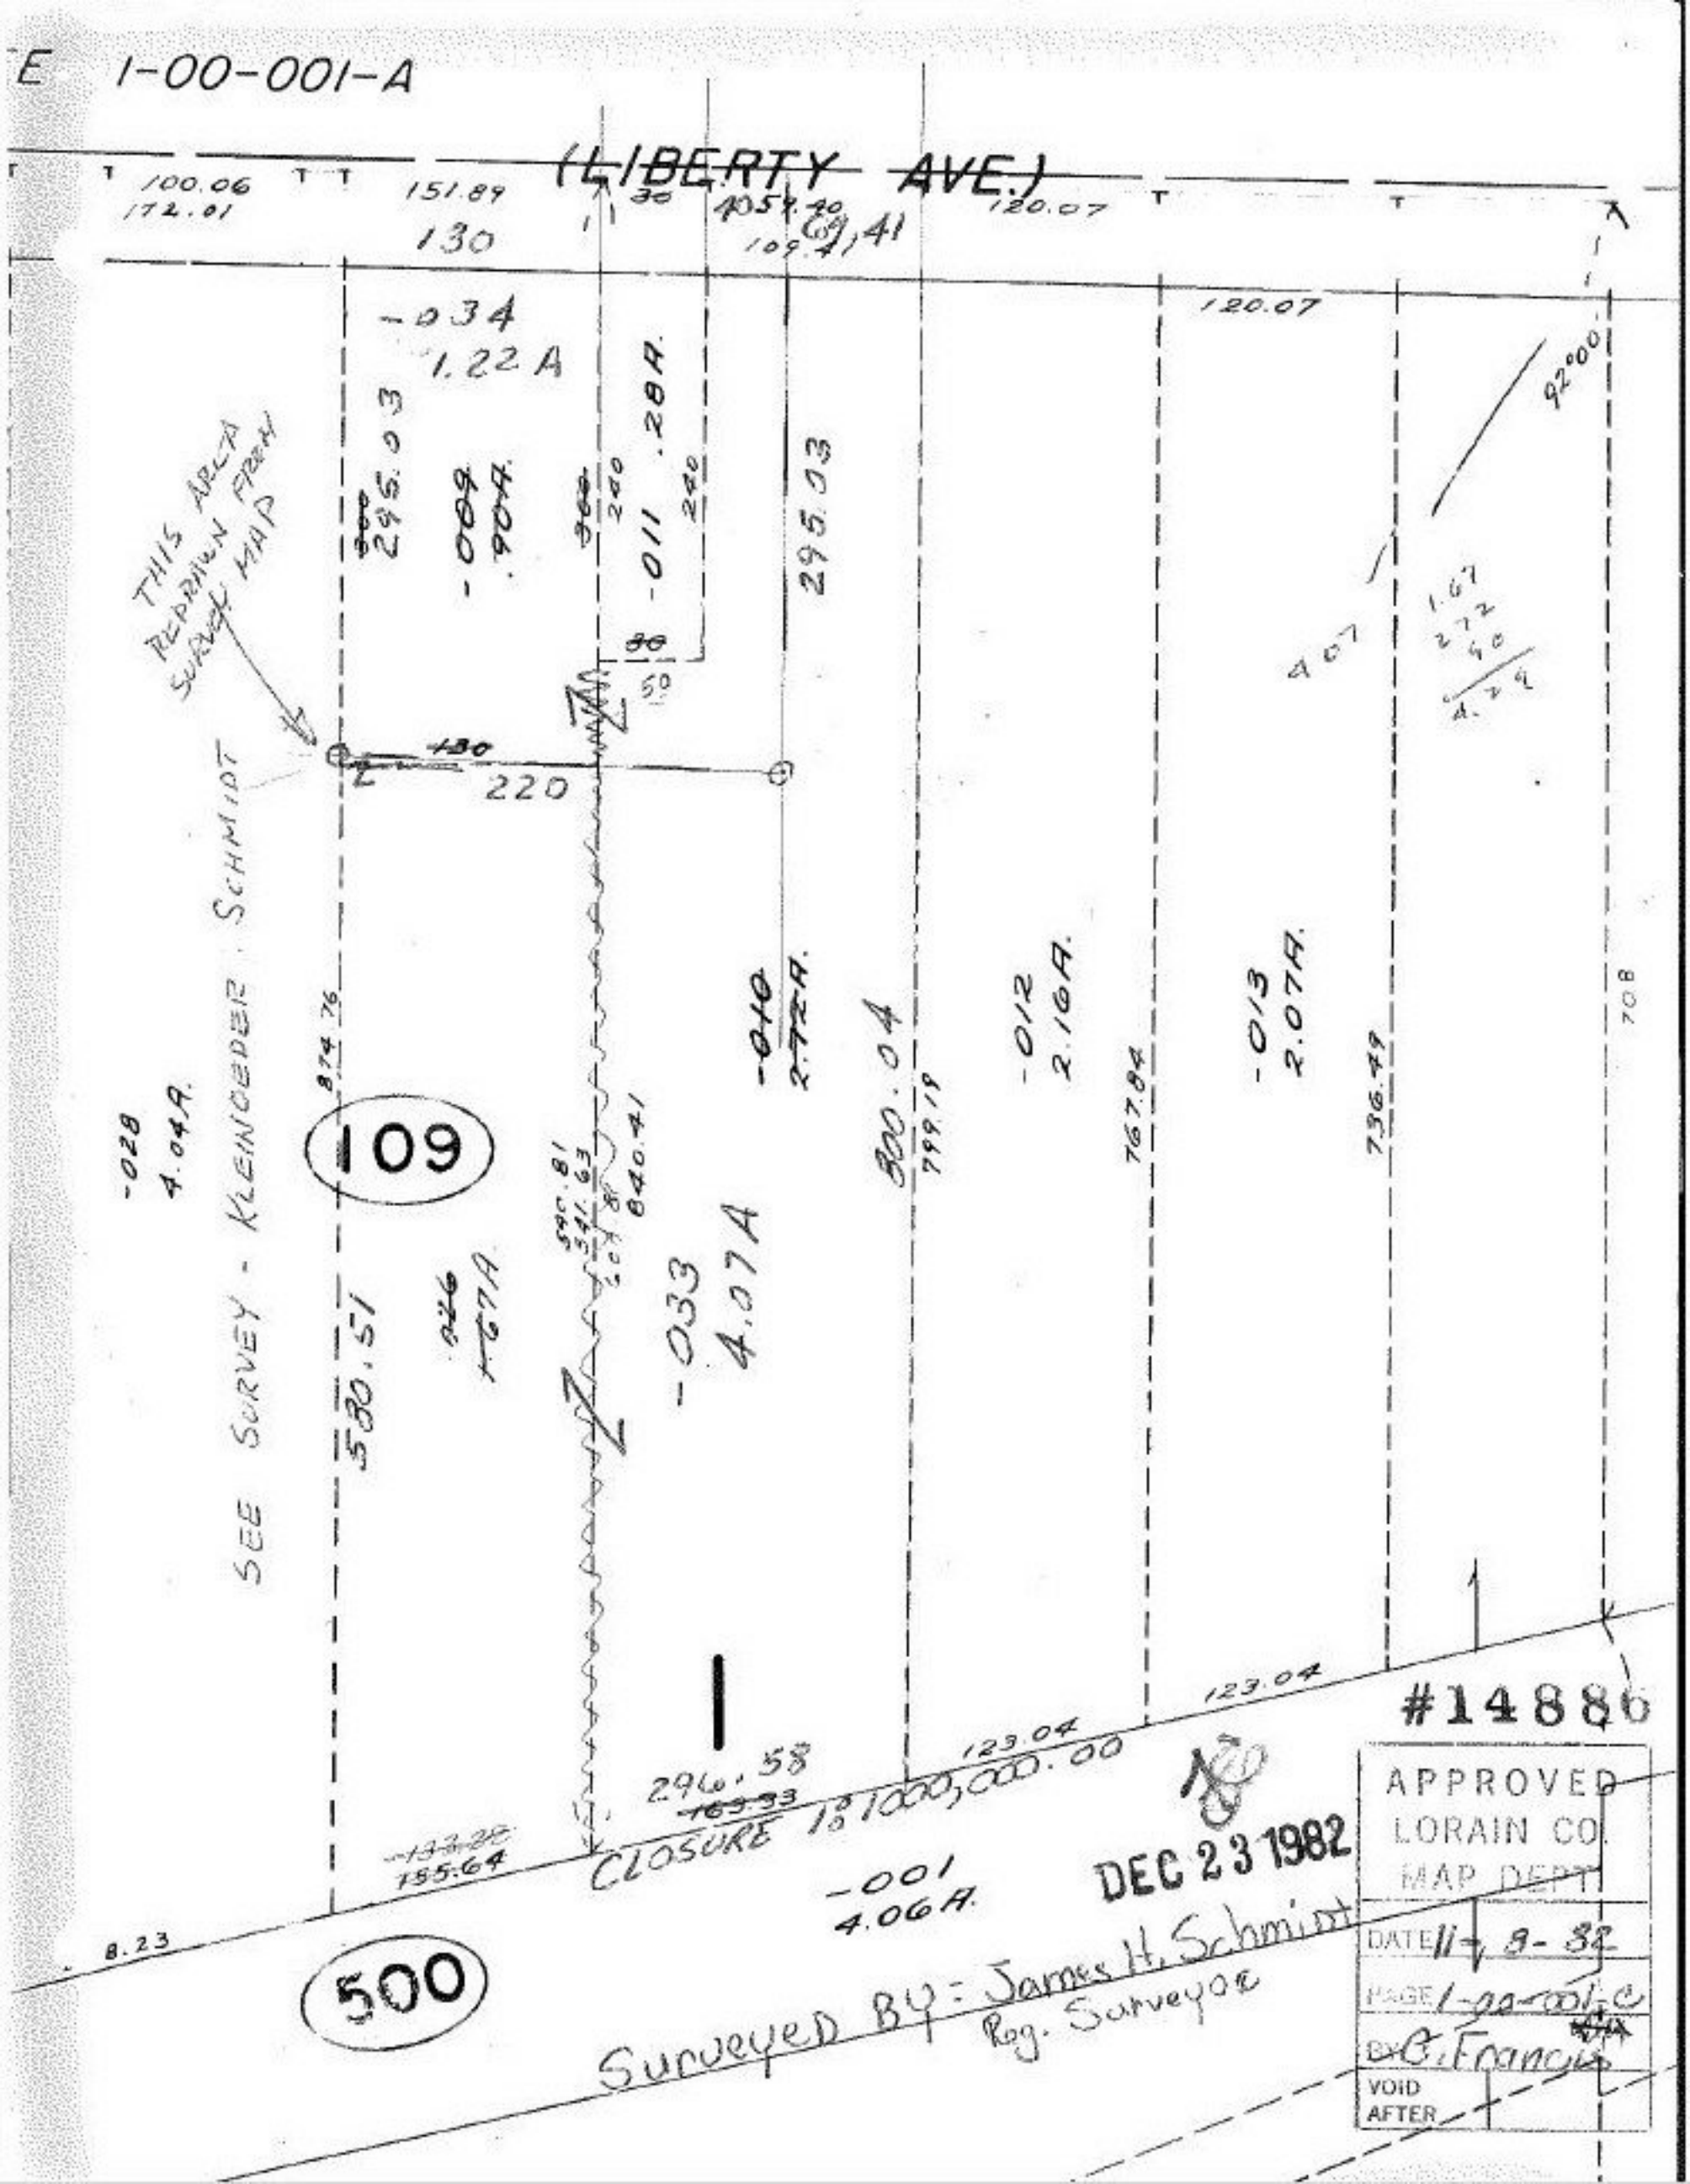

E 1-00-001-A
(LIBERTY AVE.)
100.06
172.01
151.89
130
120.07
-034
1.22 A
295.03
-009
.90A
-011 .28A
295.03
THIS AREA REDRAWN FROM SURVEY MAP
220
SEE SURVEY - KLEINOEDER SCHMIDT
-028
4.04A
109
580.51
-033
4.07A
-010
2.72A
800.04
799.19
-012
2.16A
767.84
-013
2.07A
736.49
708
92°00'
123.04
296.58
CLOSURE 1:1000,000.00
-001
4.06A
8.23
500
Surveyed BY: James H. Schmidt
Reg. Surveyor
#14886
DEC 23 1982
APPROVED
LORAIN CO.
MAP DEPT.
DATE 11-8-82
PAGE 1-00-001-C
BY C. Francis
VOID AFTER