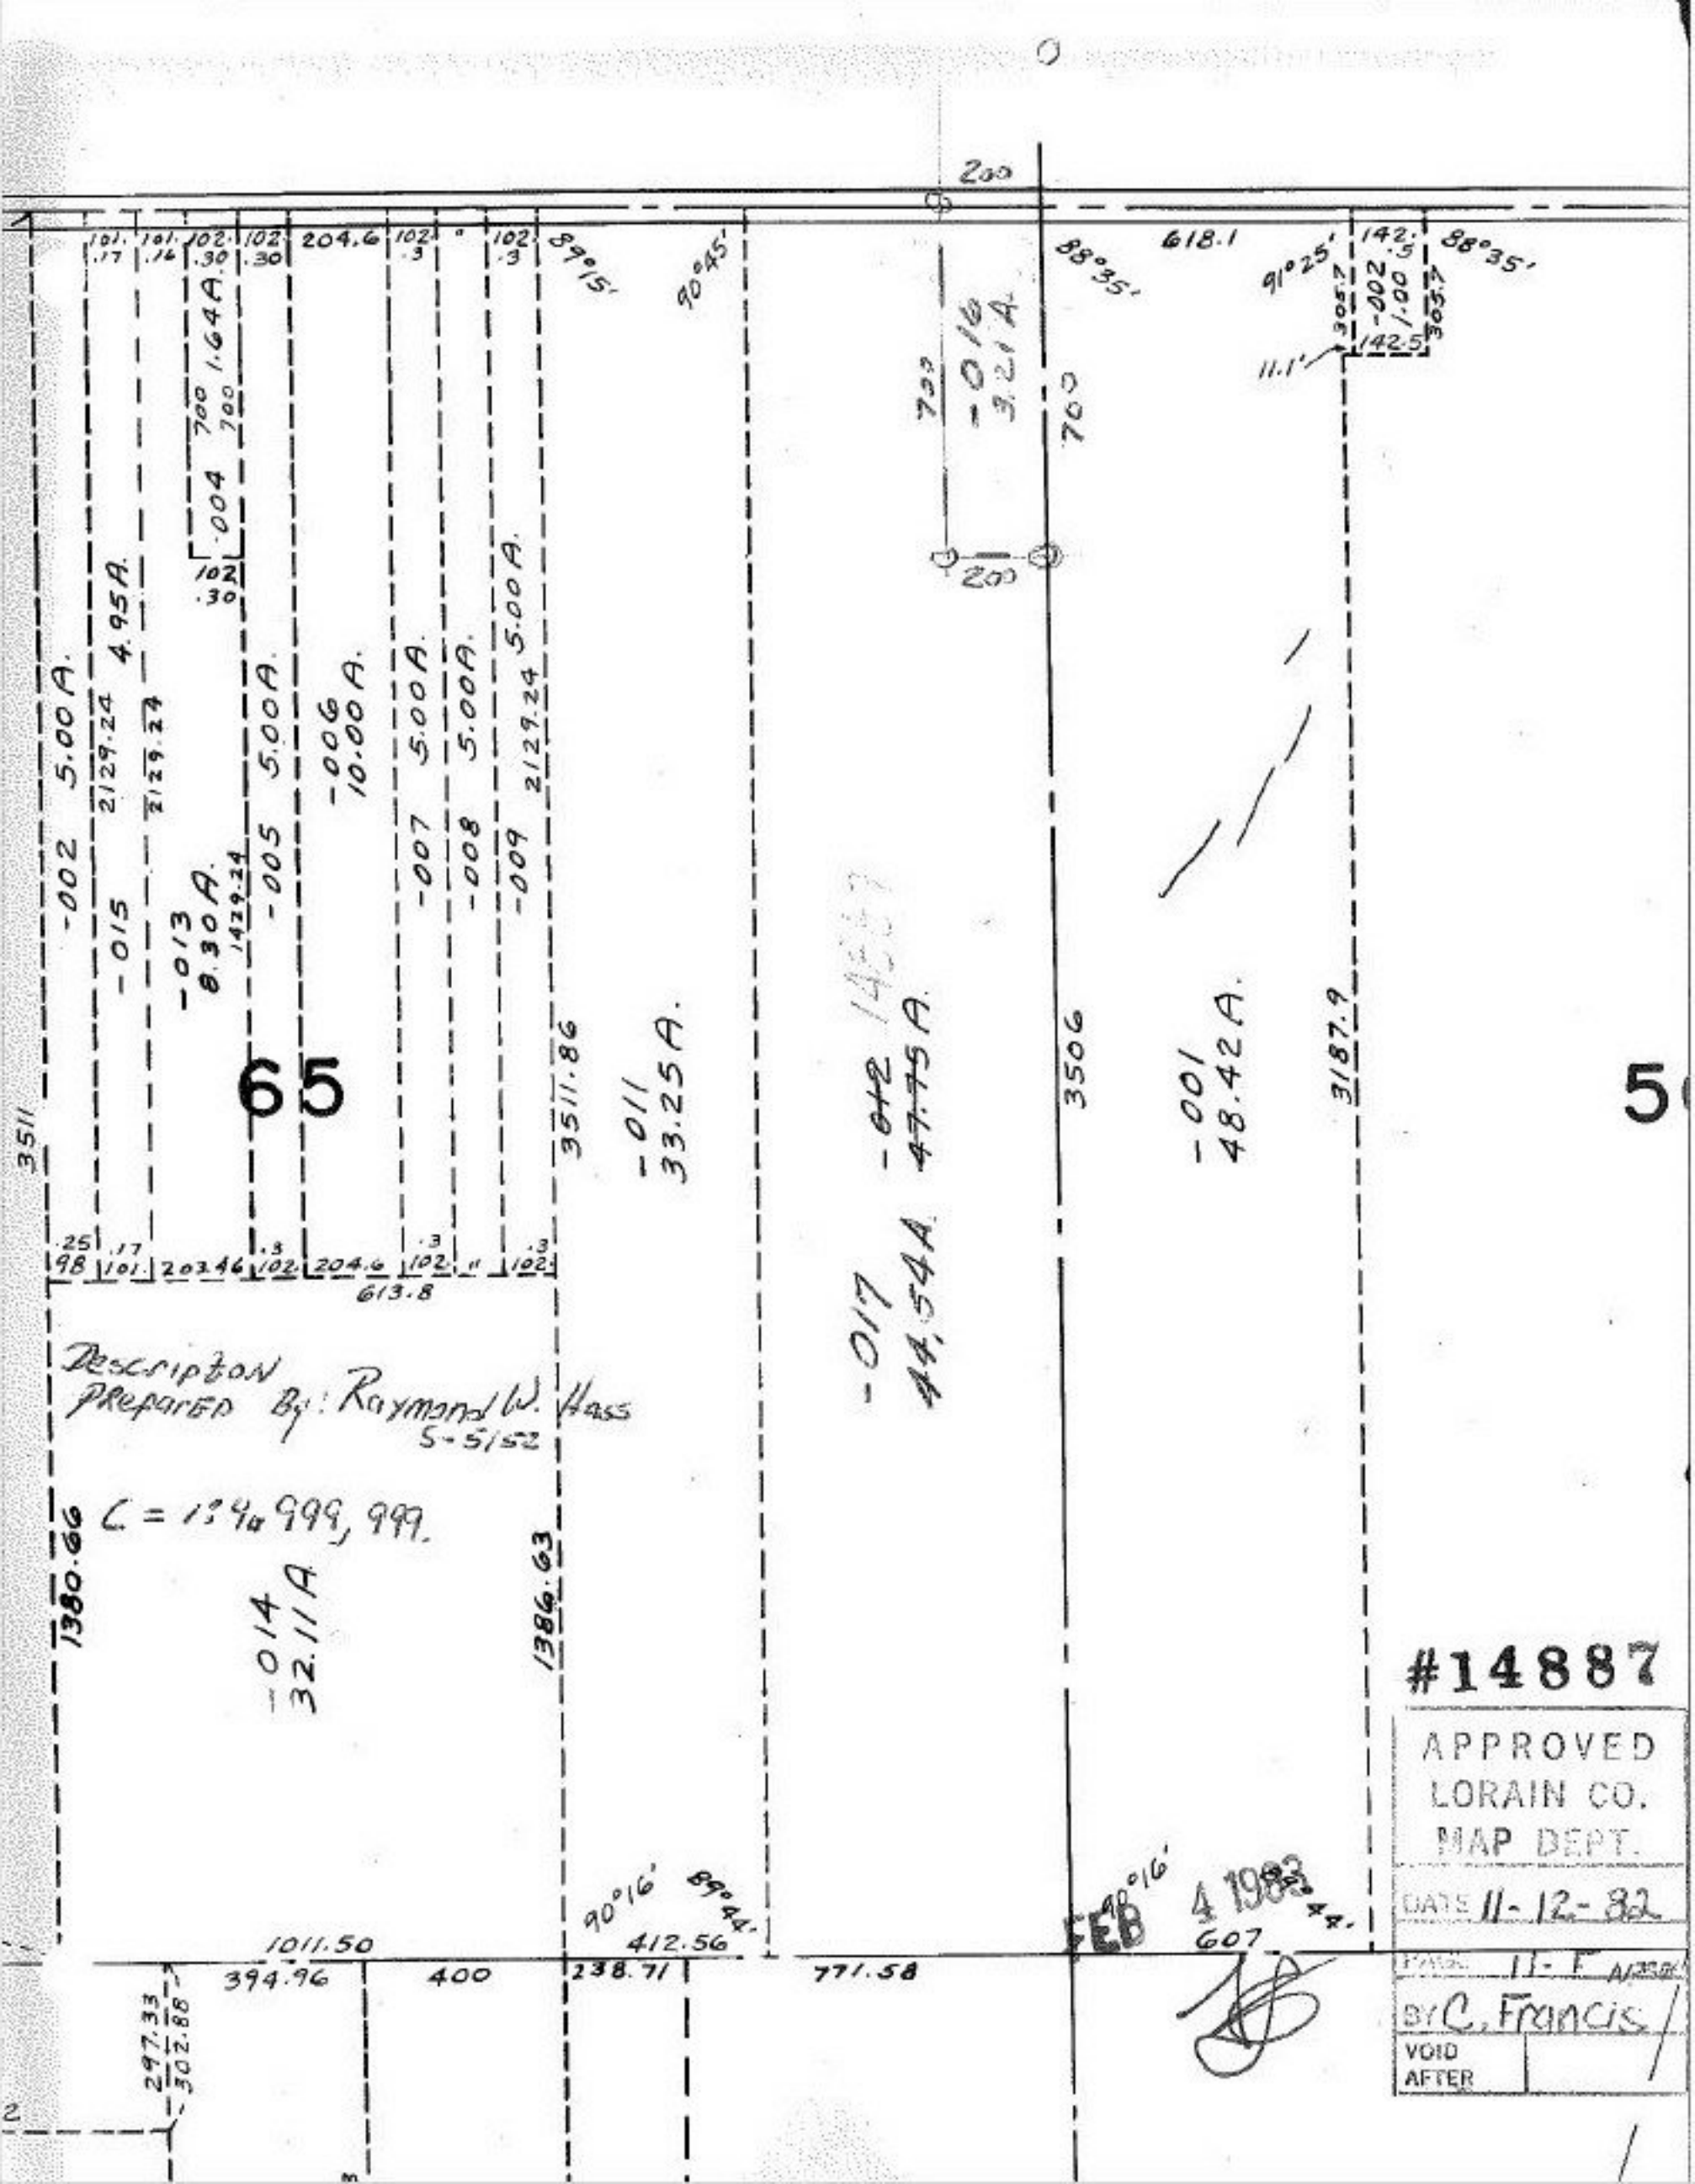

#14887

APPROVED
LORAIN CO.
MAP DEPT.

DATE 11-12-82

PAGE 11-F

BY C. Francis

VOID AFTER

FEB 4 1983