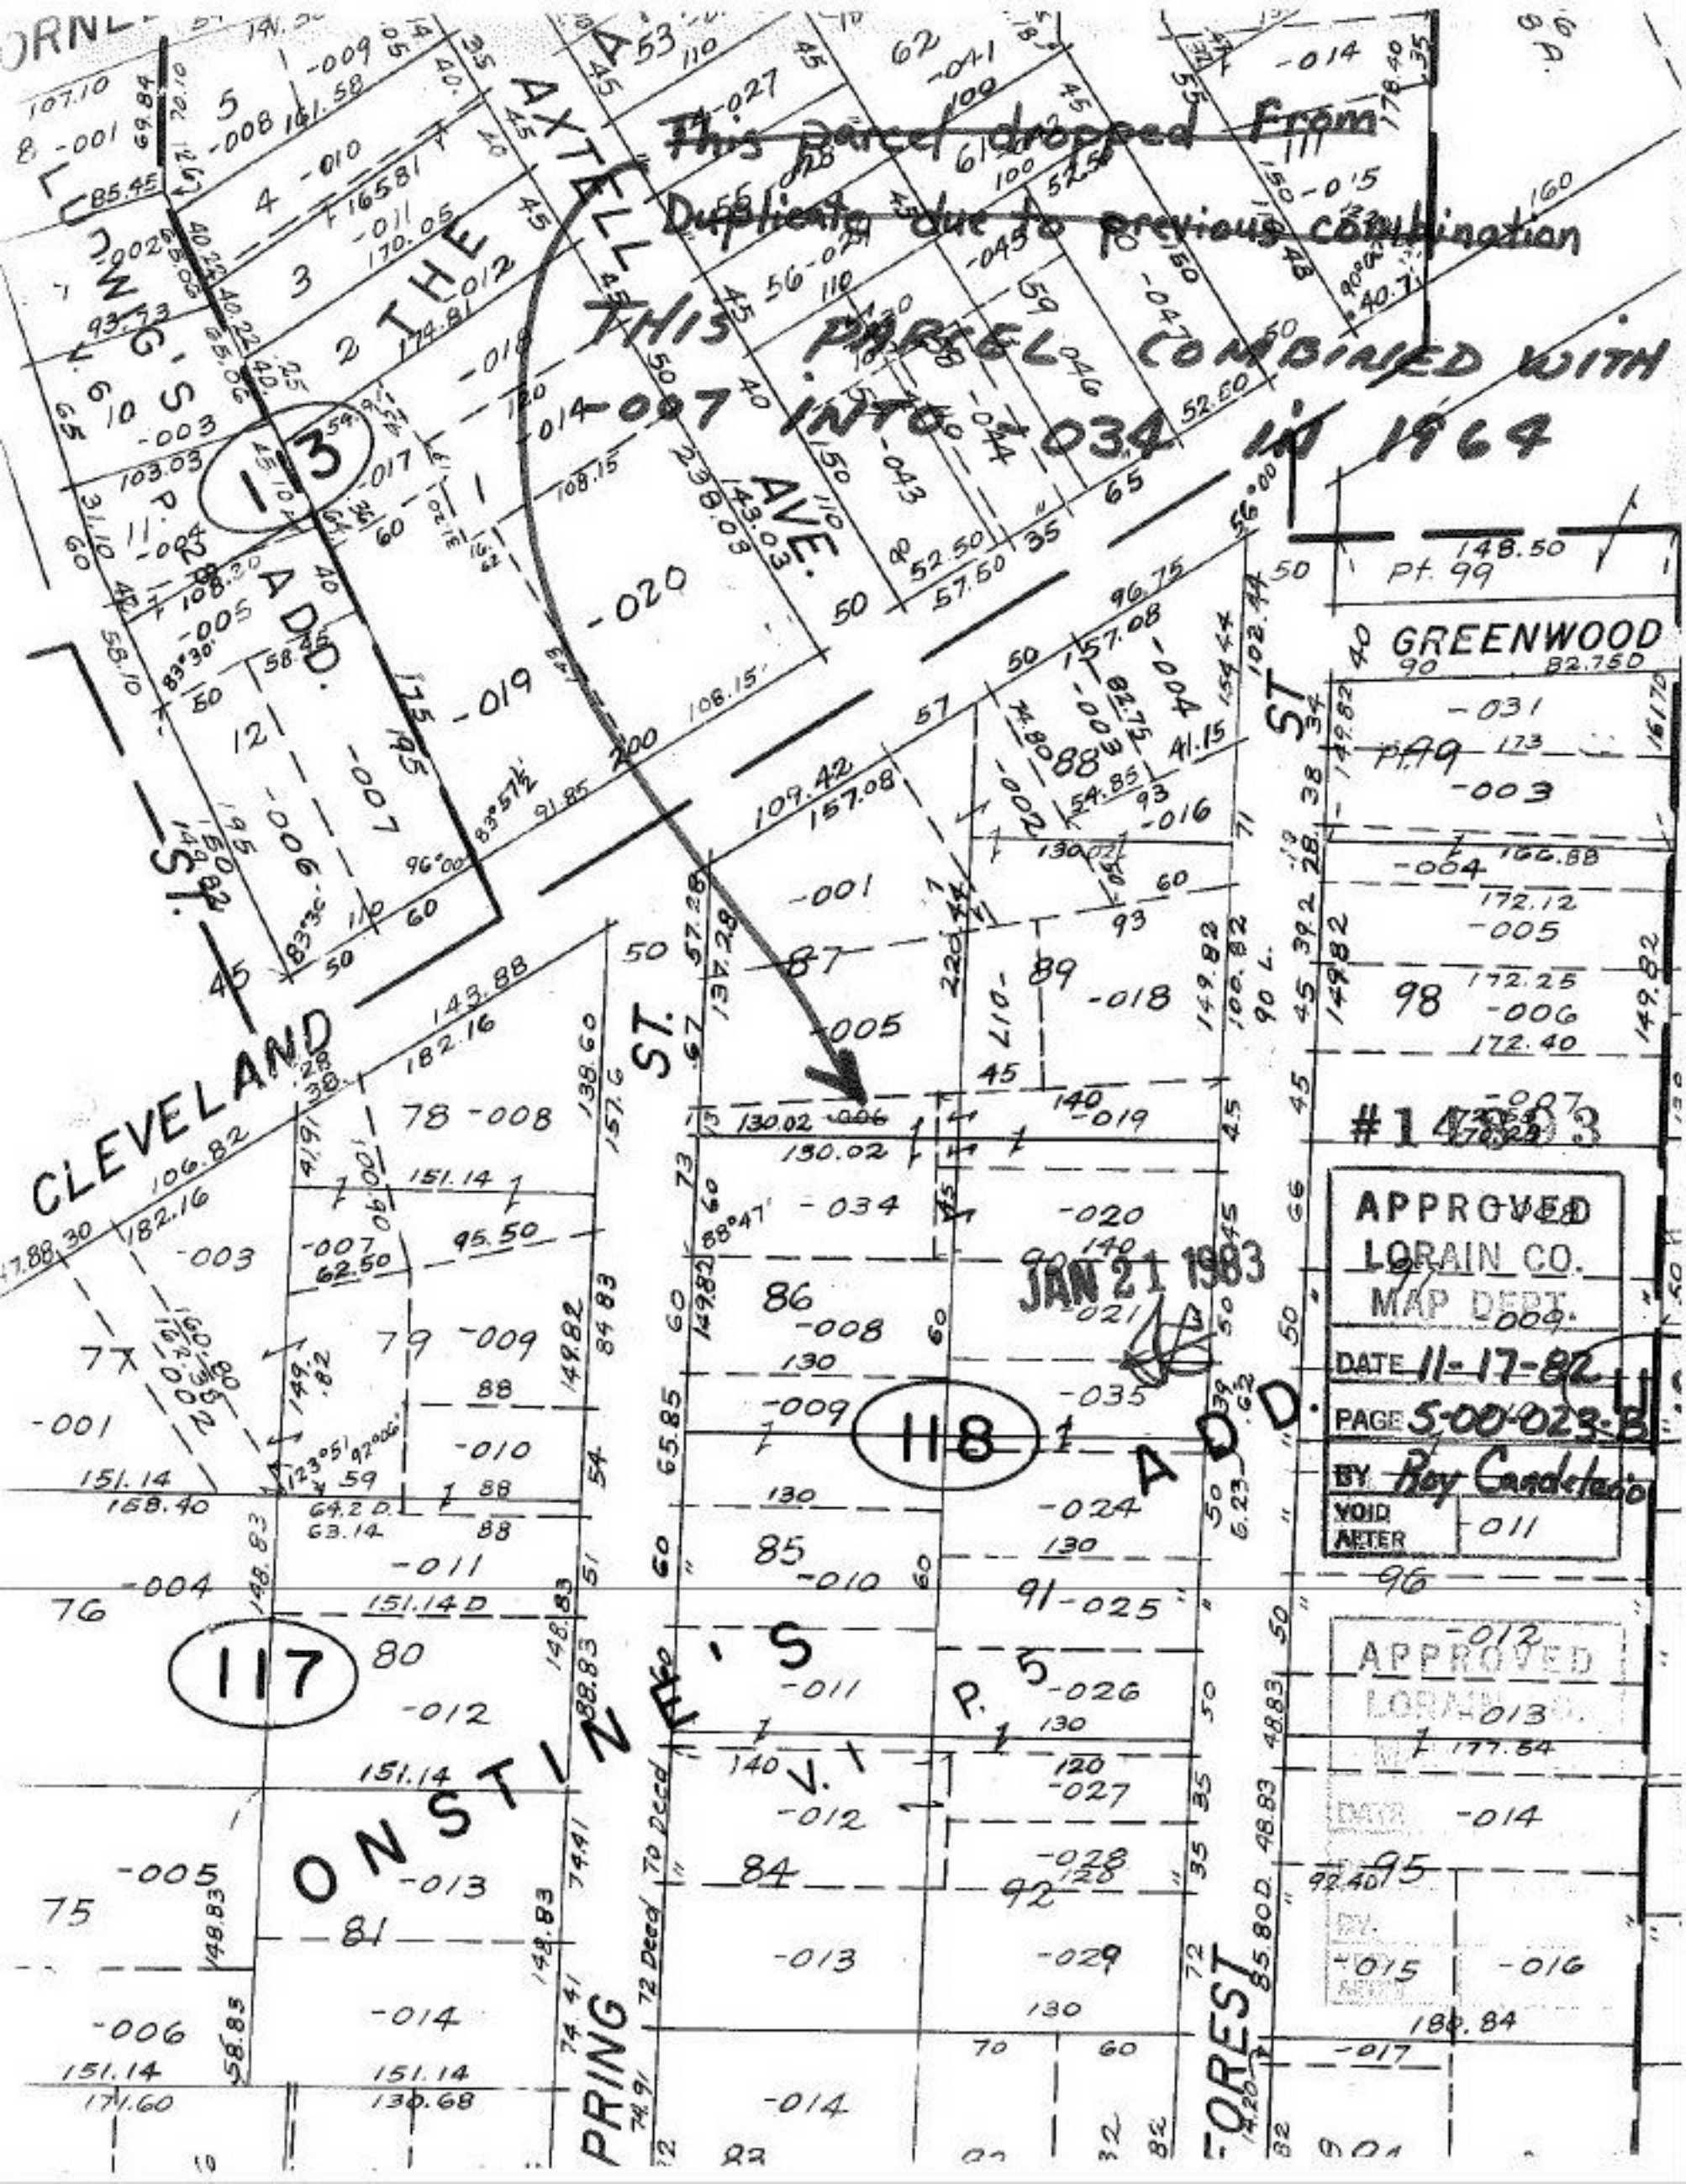

This parcel dropped From
Duplicate due to previous combination
THIS PARCEL COMBINED WITH
-007 INTO -034 IN 1964
AXTELL AVE.
THE
LUDWIG'S
ADD.
CLEVELAND
ST.
GREENWOOD
ST
ONSTINE'S
PRING
FOREST
ADD.
117
118
113
#14803
APPROVED
LORAIN CO.
MAP DEPT.
DATE 11-17-82
PAGE 5-00-023-B
BY Roy Candelario
VOID AFTER
JAN 21 1983