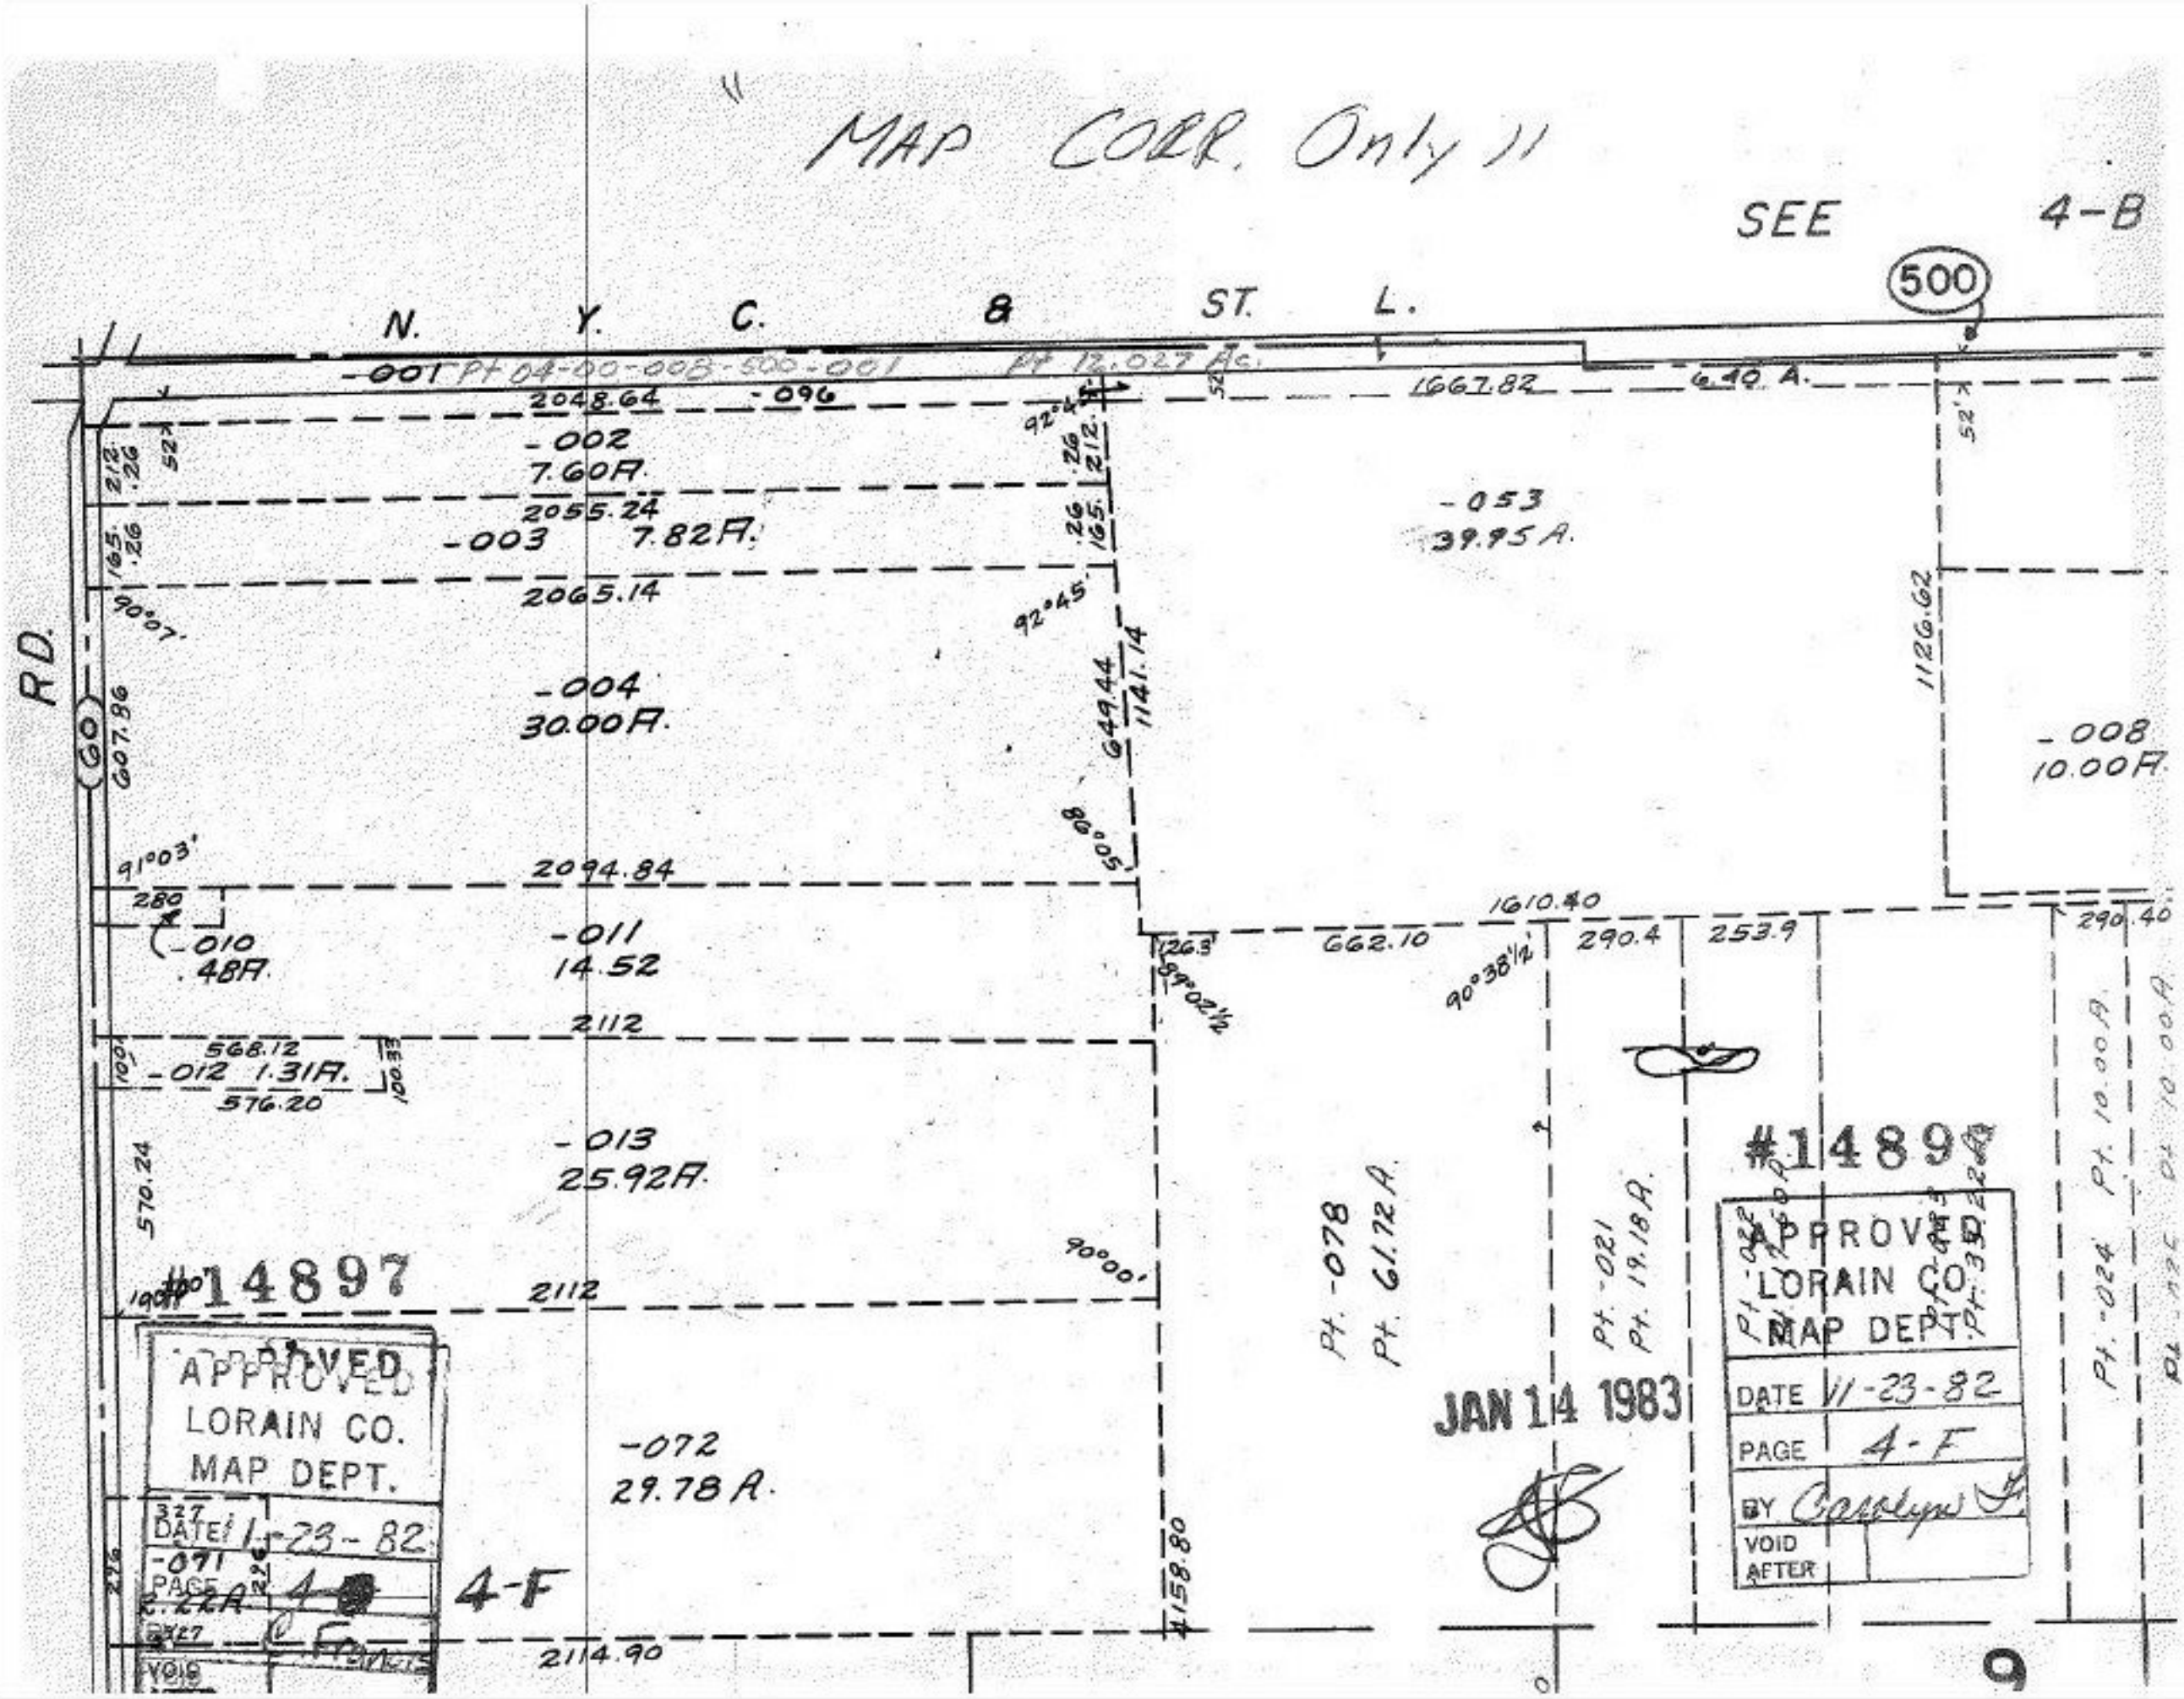
MAP CORR. Only 11
SEE 4-B
500
N. Y. C. & ST. L.
-001 Pt 04-00-008-500-001 Pt 12.027 Ac.
2048.64
-096
1667.82
6.40 A.
-002
7.60A.
2055.24
-003 7.82A.
2065.14
-053
39.95 A.
RD.
(60)
607.86
-004
30.00A.
649.44
1141.14
1126.62
-008
10.00A.
2094.84
-010
.48A.
-011
14.52
1610.40
662.10
290.4
253.9
290.40
2112
568.12
-012 1.31A.
576.20
-013
25.92A.
570.24
#14897
2112
-072
29.78 A.
Pt. -078
Pt. 61.72 A.
Pt. -021
Pt. 19.18 A.
Pt. -024
Pt. 10.00 A.
4158.80
2114.90
APPROVED
LORAIN CO.
MAP DEPT.
DATE 11-23-82
PAGE 4-F
BY Carolyn F.
VOID AFTER
JAN 14 1983
#14897
APPROVED
LORAIN CO.
MAP DEPT.
DATE 11-23-82
PAGE 4-F
BY Carolyn F.
VOID AFTER
4-F
9