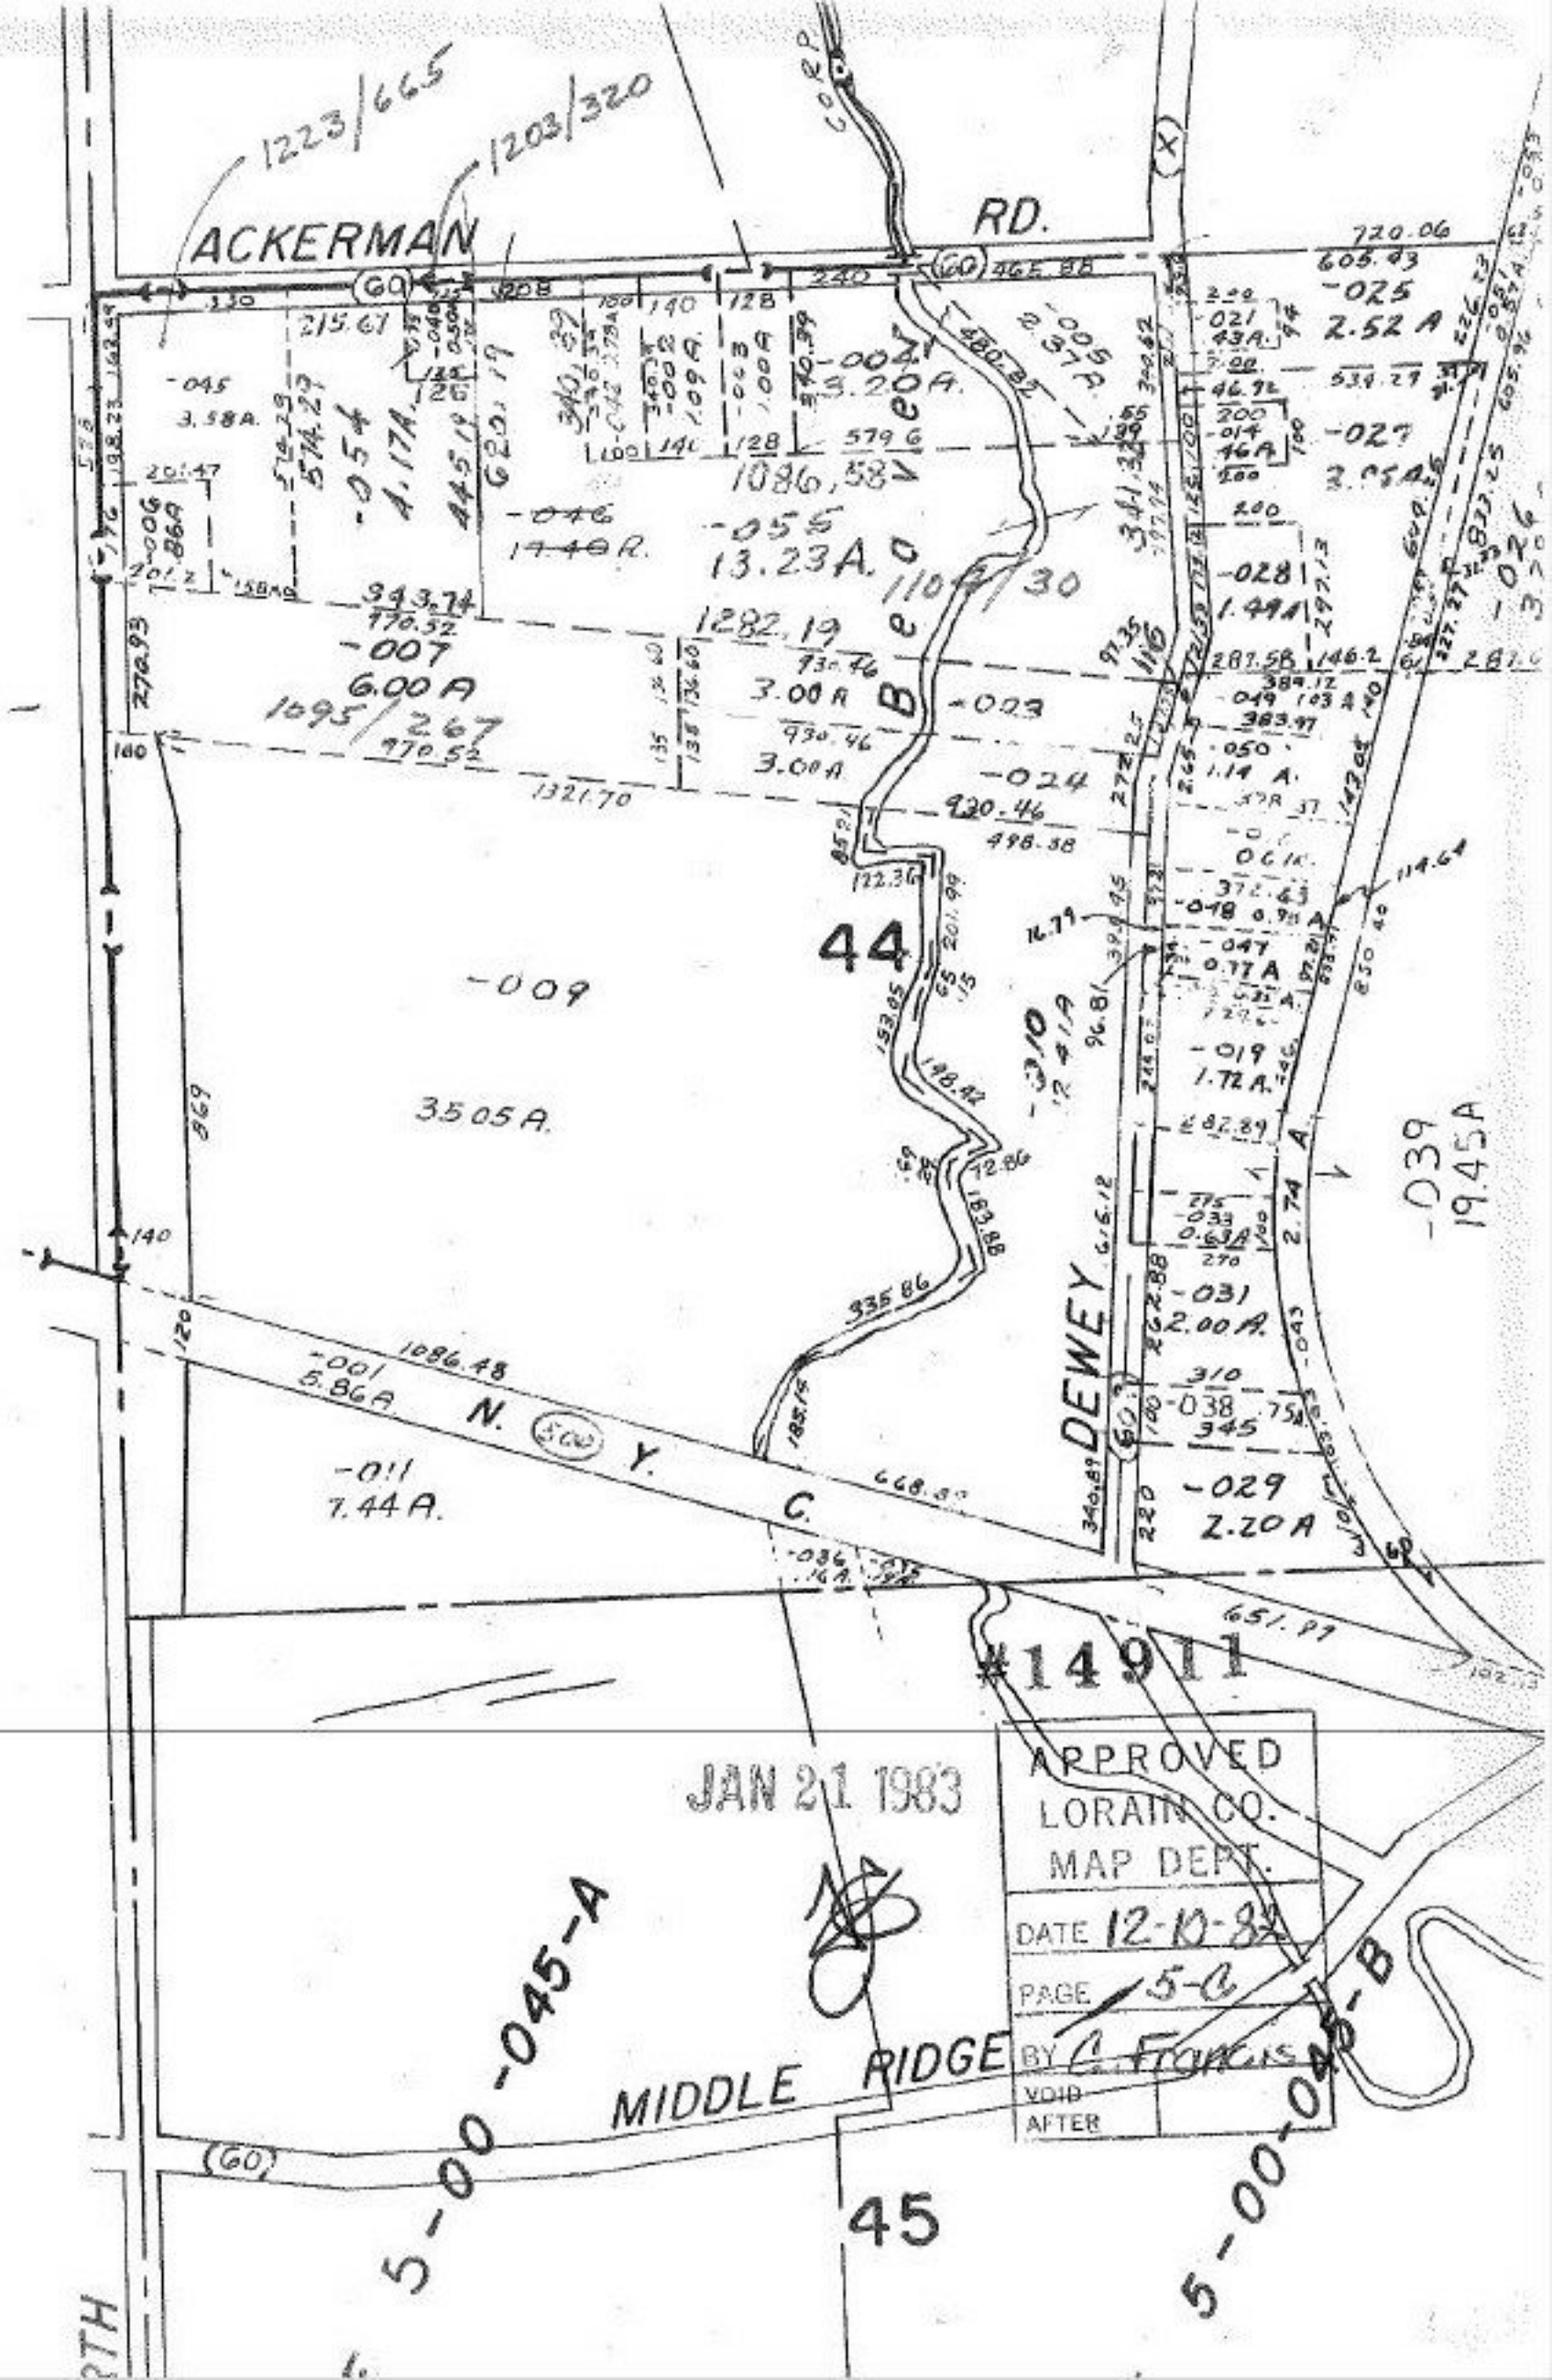
ACKERMAN RD.
1223/665
1203/320
CORP.
Beaver
DEWEY
N. Y. C.
MIDDLE RIDGE
44
45
5-00-045-A
5-00-045-B
#14911
JAN 21 1983
APPROVED
LORAIN CO.
MAP DEPT.
DATE 12-10-82
PAGE 5-C
BY C. Francis
VOID
AFTER